

NOTE: The locations and elevations of the existing water and gas mains and services are approximate only.

Upas Street is paved with 3" asphaltic concrete base and 1 1/2" asphaltic wearing surface.
 Replace cut pavement with 5" Portland cement concrete base and 1" asphaltic wearing surface.


WORK TO BE DONE.

- Proposed Water Main
- Gate Valve
- Pressure & Vacuum (P&V) Valve
- Fire Hydrant

EXISTING FACILITIES.

- Curb
- Water Main
- Water Valve
- Water Service 3/4"
- Fire Hydrant
- Sewer Main
- Sewer Manhole
- Sewer Lateral
- Sewer Dead End
- Gas Main
- Gas Service
- Telephone Underground Duct.

CITY DATUM
 ADD 6.119 FEET
 TO CONVERT TO
 MEAN SEA LEVEL

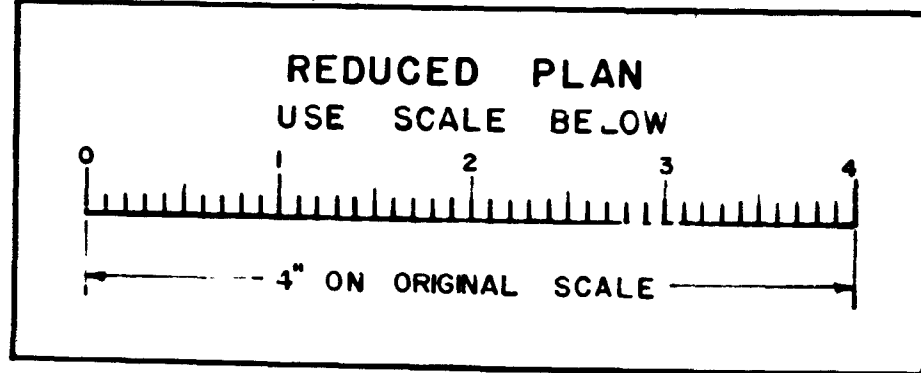

CITY OF SAN DIEGO ENGINEERING DEPARTMENT		Sheet 1
PLAN & PROFILE. 16" Water Main in Upas Street between Bancroft Street & 30th Street.		
APPROVED: <i>[Signature]</i> CITY ENGINEER	DATE DEC. 6, 1948	SCALE 1" = 50'
DRAWN BY: R.E. TRACED BY: R.E. CHECKED BY: R.E.	CHANGED DATE O.K. ADDITIONS 2-20-47 R.E. AS BUILT 8-19-47 R.E.	DRAWING NUMBER 6926-L

W.O. 2023
 MICROFILMED
 APR - 1962