

SCALE -
 1"=50' HORIZONTAL
 1"= 5' VERTICAL



AS BUILT DATA
 CONSTRUCTED BY WAL-CON
 W O 148011 (CONSTR), W O (ENGR)
 PIPE JOHNS-MANVILLE (KIND)
 GATE VALVES RICH (KIND)
 SOIL (KIND) GRANULAR WITH SMALL ROCKS
 STAKED (DATE)
 TESTED 4-23-76 (DATE)
 BACKFILL NATIVE (KIND)
 NOTE INCLUDE "CONSTRUCTION RECORD"
 CONNECTIONS BY - CITY FORCE
 W O
 PIPE
 GATE VALVES

REFERENCES -
 GATE BOOK F-20
 GAS BOOK 2, PAGES 16, 27, 28, 29, 64, 83, 105, 157, 475, 502
 TELE 153 0 153 1
 FIELD NOTES - CHIPMAN 4-1971, 206-1716
 SEWER 206, 208, 210 1716
 WATER 206, 208, 210 1716

IMPROVEMENTS -
 SEWER 2127-1-L, 14121-L, 208-D, 7062-D, 8831-D, 12664-2-D, 13602 4-D
 WATER 2522-L, 3633 L, 3634-L, 3635 L, 3636-L, 5927 L, 2127 1-L, 10994 4-D
 DRAIN 3633-1-L, 3646 L, 13602-1 2-3-4-D
 PAVING 1348-L, 1349-L, 3633-L

BENCH MARKS - (MEAN SEA LEVEL DATUM)
 B M - S W B P - STATE ST & LAUREL ST
 EL 80 073
 N W B P - REYNARD WAY & REDWOOD ST
 EL 90 127

RETIREMENT -
 3,665' - 6" C I 1930
 5 - F H 'S - 1930
 1-2" SERVICE 1930
 1-1" SERVICE 1930
 12 - 3 4" SERVICES 1930

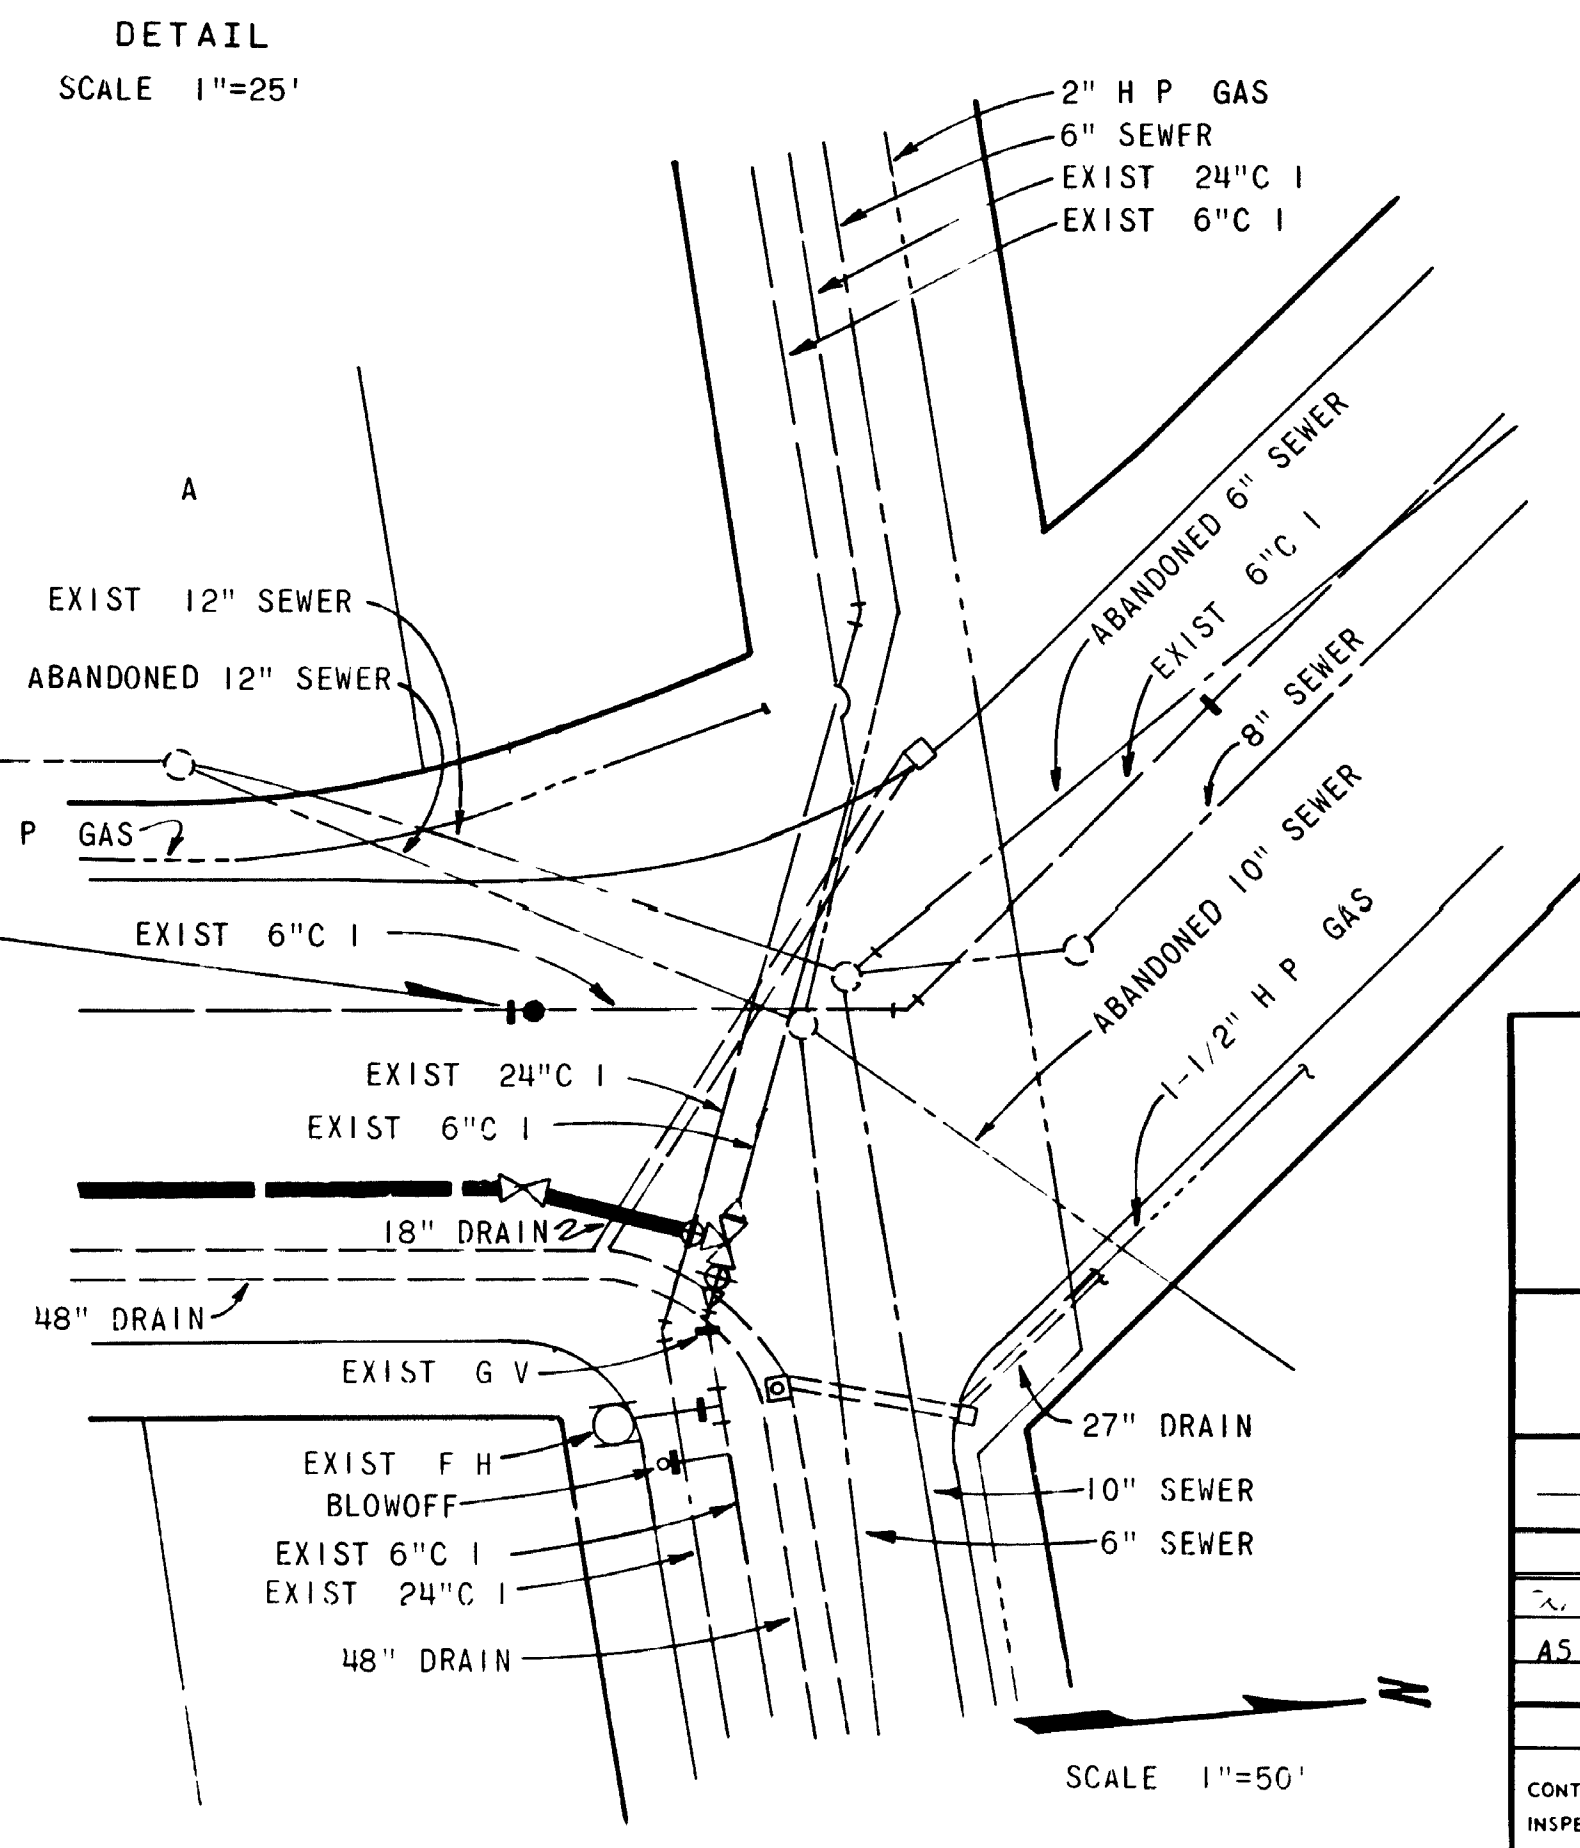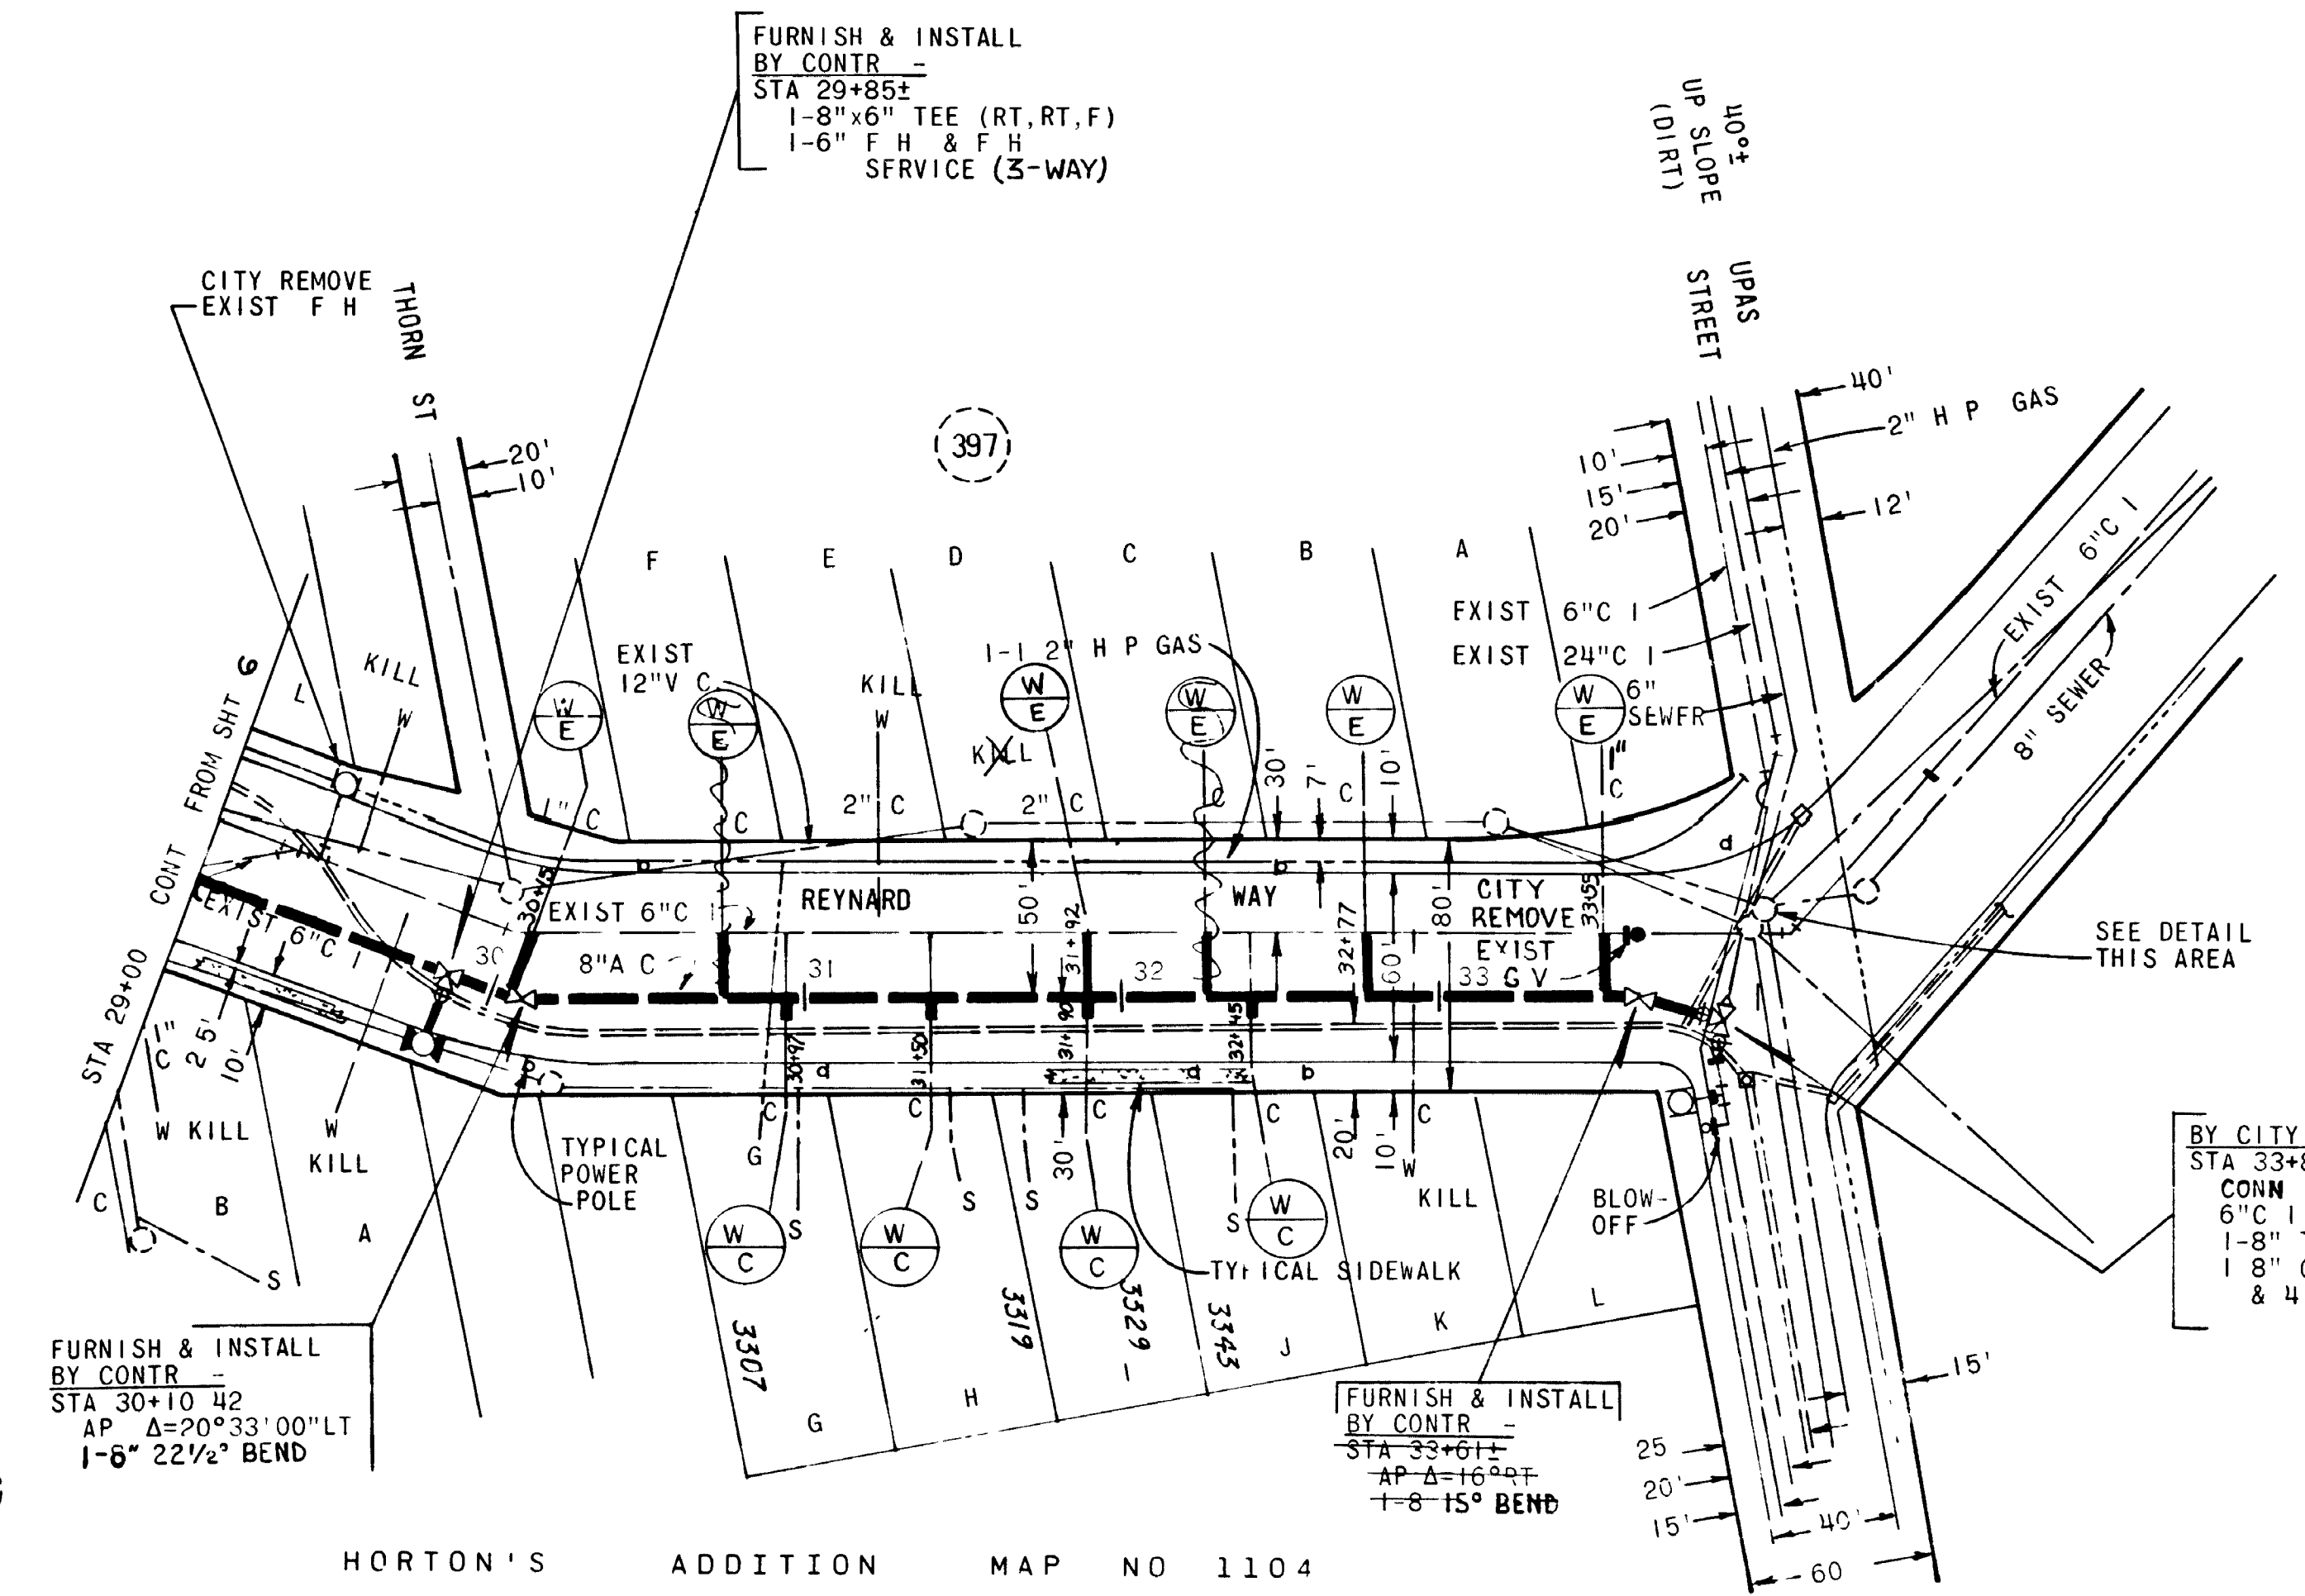

SEWER & WATER GROUP 18		EWO 148011	
REYNARD WAY 8" A C WATER MAIN		UWO 26821	
STA 29+00 TO UPAS STREET			
CITY OF SAN DIEGO, CALIFORNIA		ENGINEERING SUPERINTENDENT	
UTILITIES DEPARTMENT		DATE 2-31-72	
SHEET 7 OF 7 SHEETS		DESIGN ENGINEER	
DESCRIPTION	BY	APPROVED	FILMED
AS BUILT 9-21-79	BIRCK	KIFE	
CONSTRUCTION RECORD		CONTROL CERTIFICATION	
CONTRACTOR WAL-CON		DATE STARTED 4-8-76	
INSPECTOR H. MILLS		DATE COMPLETED 7-15-76	
CONNECTIONS BY		LAMBERT COORDINATES	
		208, 210, 1716	
		14822-7-D	

REYNARD WAY (WATER)