

NOTE
 1) CONSTRUCT ROCK TRAP MANHOLE ON VINE ST. PER DETAIL SEW-1 ON DWG SS-2.
 2) REMOVE BY OTHERS WITH FUTURE WORK

SEE DWG U-8
MATCH LINE

SEE DWG U-10
MATCH LINE

STORM DRAIN DATA

LINE	BEARING/DELTA	LENGTH	RADIUS	TYPE
1	N 54°07'09" E	3.75 ±	-	48" RCP, D-3000
2	N 54°07'09" E	55.5 ±	-	36" RCP, D-3000
3	N 49°24'25" E	67 ± 47 ±	-	24" RCP, D-3000
4	N 62°29'18" E	59.31 ±	-	30" RCP, D-2000
5	N 22°12'54" W	51.07 ±	-	24" RCP, D-2000
6	N 70° W	20 ±	45'	24" RCP, D-3000

WATERLINE DATA

LINE	BEARING/DELTA	LENGTH	RADIUS	TYPE
1	N 54°29'00" E	179.00'	-	24" SCRW
2	S 35°31'00" E	10.00'	-	24" SCRW
3	S 06°30'03" E	198.03'	880'	24" SCRW
4	S 36°01'20" E	10.00'	-	24" SCRW
5	N 53°58'40" E	95.49'	-	24" SCRW
6	N 36°01'20" W	30.00'	-	24" SCRW

AS BUILT
 Contract No. LRT-550
 Date 11/25/93

CITY OF SAN DIEGO, CALIFORNIA
 ENGINEERING DEPT.
 SHEET 60 OF 122 SHEETS

DESIGNER: *[Signature]* 10-6-95
 FOR CITY ENGINEER: *[Signature]*

CONTRACTOR: L.R. HUBBARD
 INSPECTOR: MARTIN HALL
 DATE STARTED: 6/92
 DATE COMPLETED: 11/93


CONNECTIONS BY CITY

SCALE: 1" = 40'

MTDB CONTRACT NO. LRT 550
 DRAWING NO. SHEET NO. U-9 64

NO.	DATE	REVISIONS	BY	CHK	APRV
1	10/20/93	AS-BUILT			

FRASER ENGINEERING, INC.
 2191 EL CAMINO REAL, OCEANSIDE CALIFORNIA (619) 722-3495

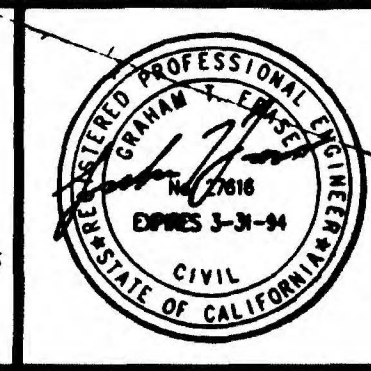

DESIGNED BY: D.W.
 DATE: 1/06/92
 DRAWN BY: M.S.B.
 CHECKED BY: M.A.
 MTDB PRJ. ENG.

MTDB
 Metropolitan Transit Development Board
 1255 Imperial Avenue, Suite 1000, San Diego, CA. 92101-7490 (619) 231-1466

LIGHT RAIL GUIDEWAY PROJECT
 San Diego
 OLD TOWN LRT SITE PREPARATION
 UTILITY RELOCATION PLAN

PL 14801031, 46807-9.DWG PLOT 1-40
 Jul 15, 1992 - 16:46:10

