



28TH STREET - UPAS ST. TO UNIVERSITY AVE.

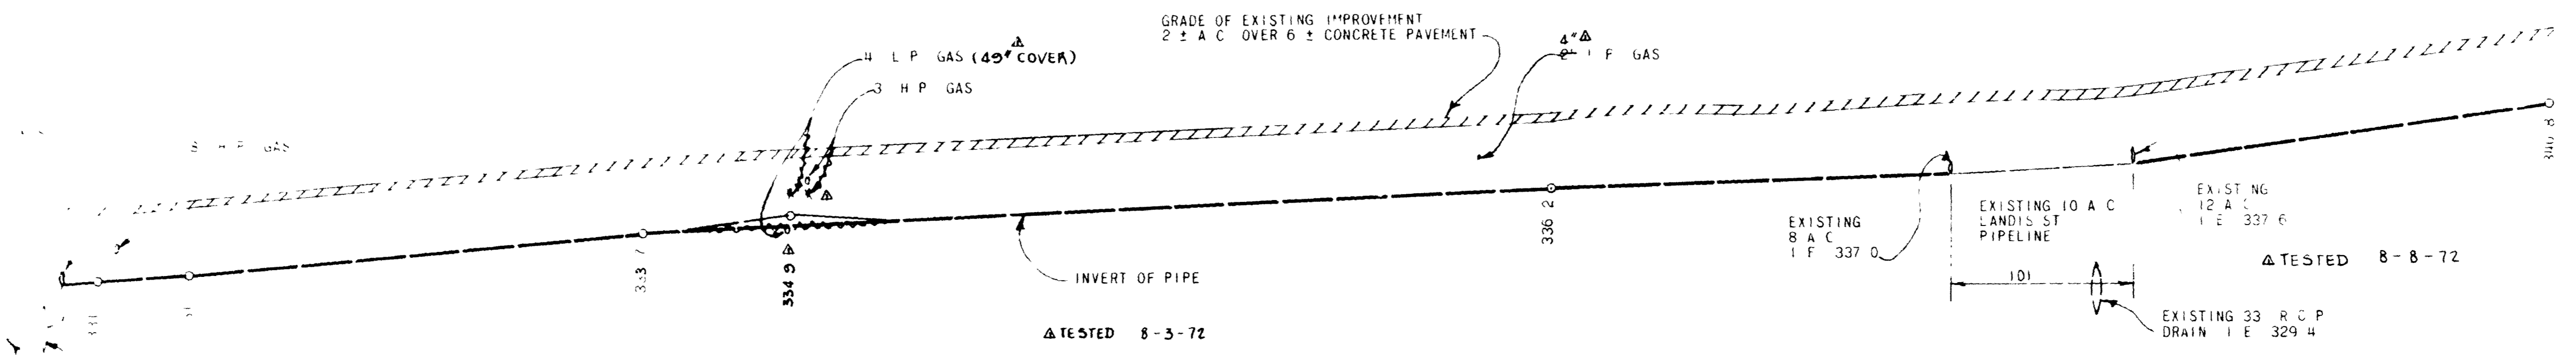

SCALE
1" = 50' HORIZONTAL
1" = 5' VERTICAL

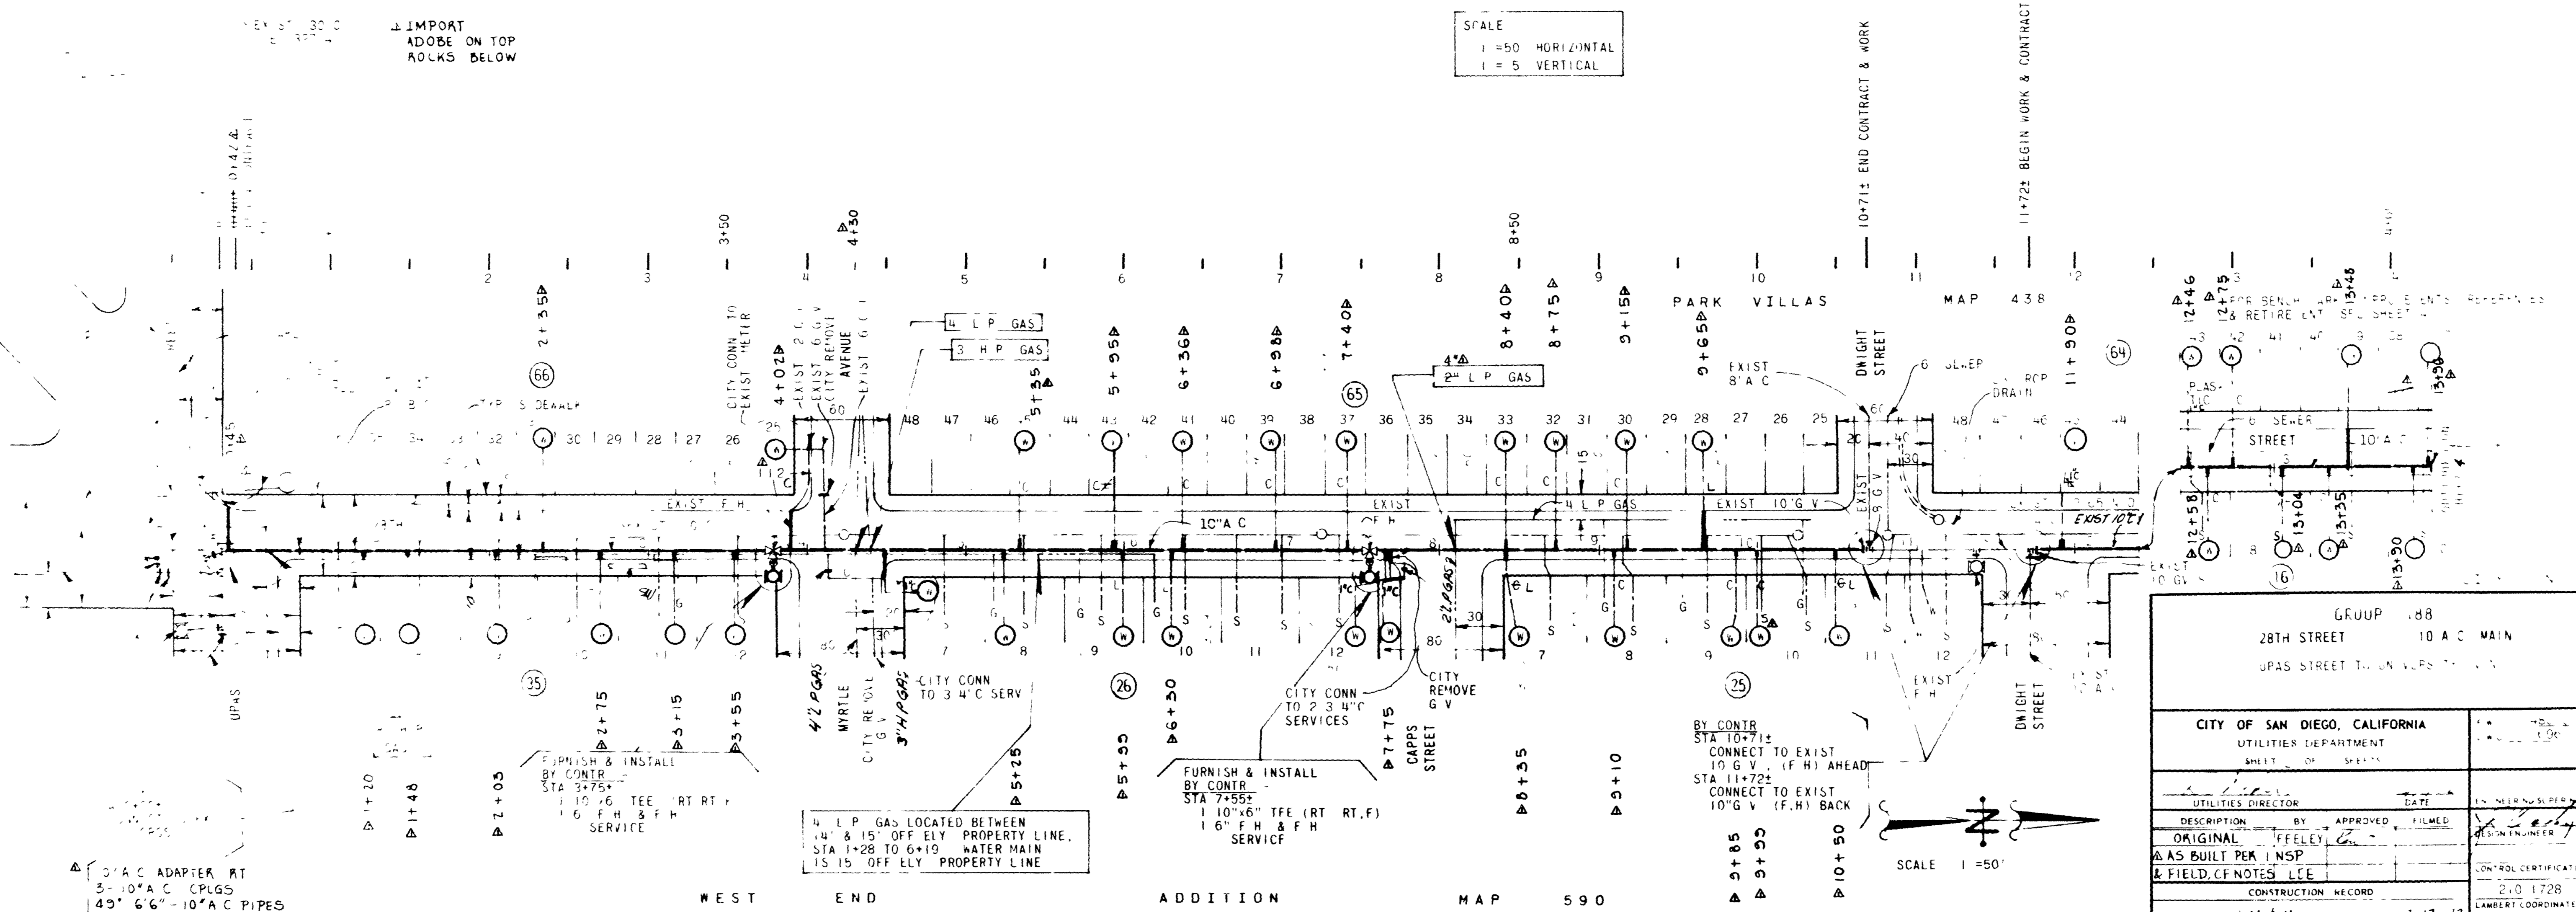

GROUP 88 28TH STREET 10" A.C. MAIN UPAS STREET TO UNIVERSITY AVE.	
CITY OF SAN DIEGO, CALIFORNIA UTILITIES DEPARTMENT	DATE
UTILITIES DIRECTOR	DATE
DESCRIPTION	BY APPROVED FILED
ORIGINAL	FEELY
AS BUILT PER INSP	
& FIELD NOTES LIE	
CONSTRUCTION RECORD	CONTROL CERTIFICATION
CONTRACTOR M & H DATE STARTED 1-17-72	210 1728
INSPECTOR H MILLS DATE COMPLETED 2-29-72	LAMBERT COORDINATES
UNNECESSARY BY CITY FORCE	14838 3-D

AS BUILT
1-24-75