


SCALE
 1" = 50' HORIZONTAL
 1" = 5' VERTICAL

SEE SHEET 11 FOR AS BUILT AND RETIREMENTS

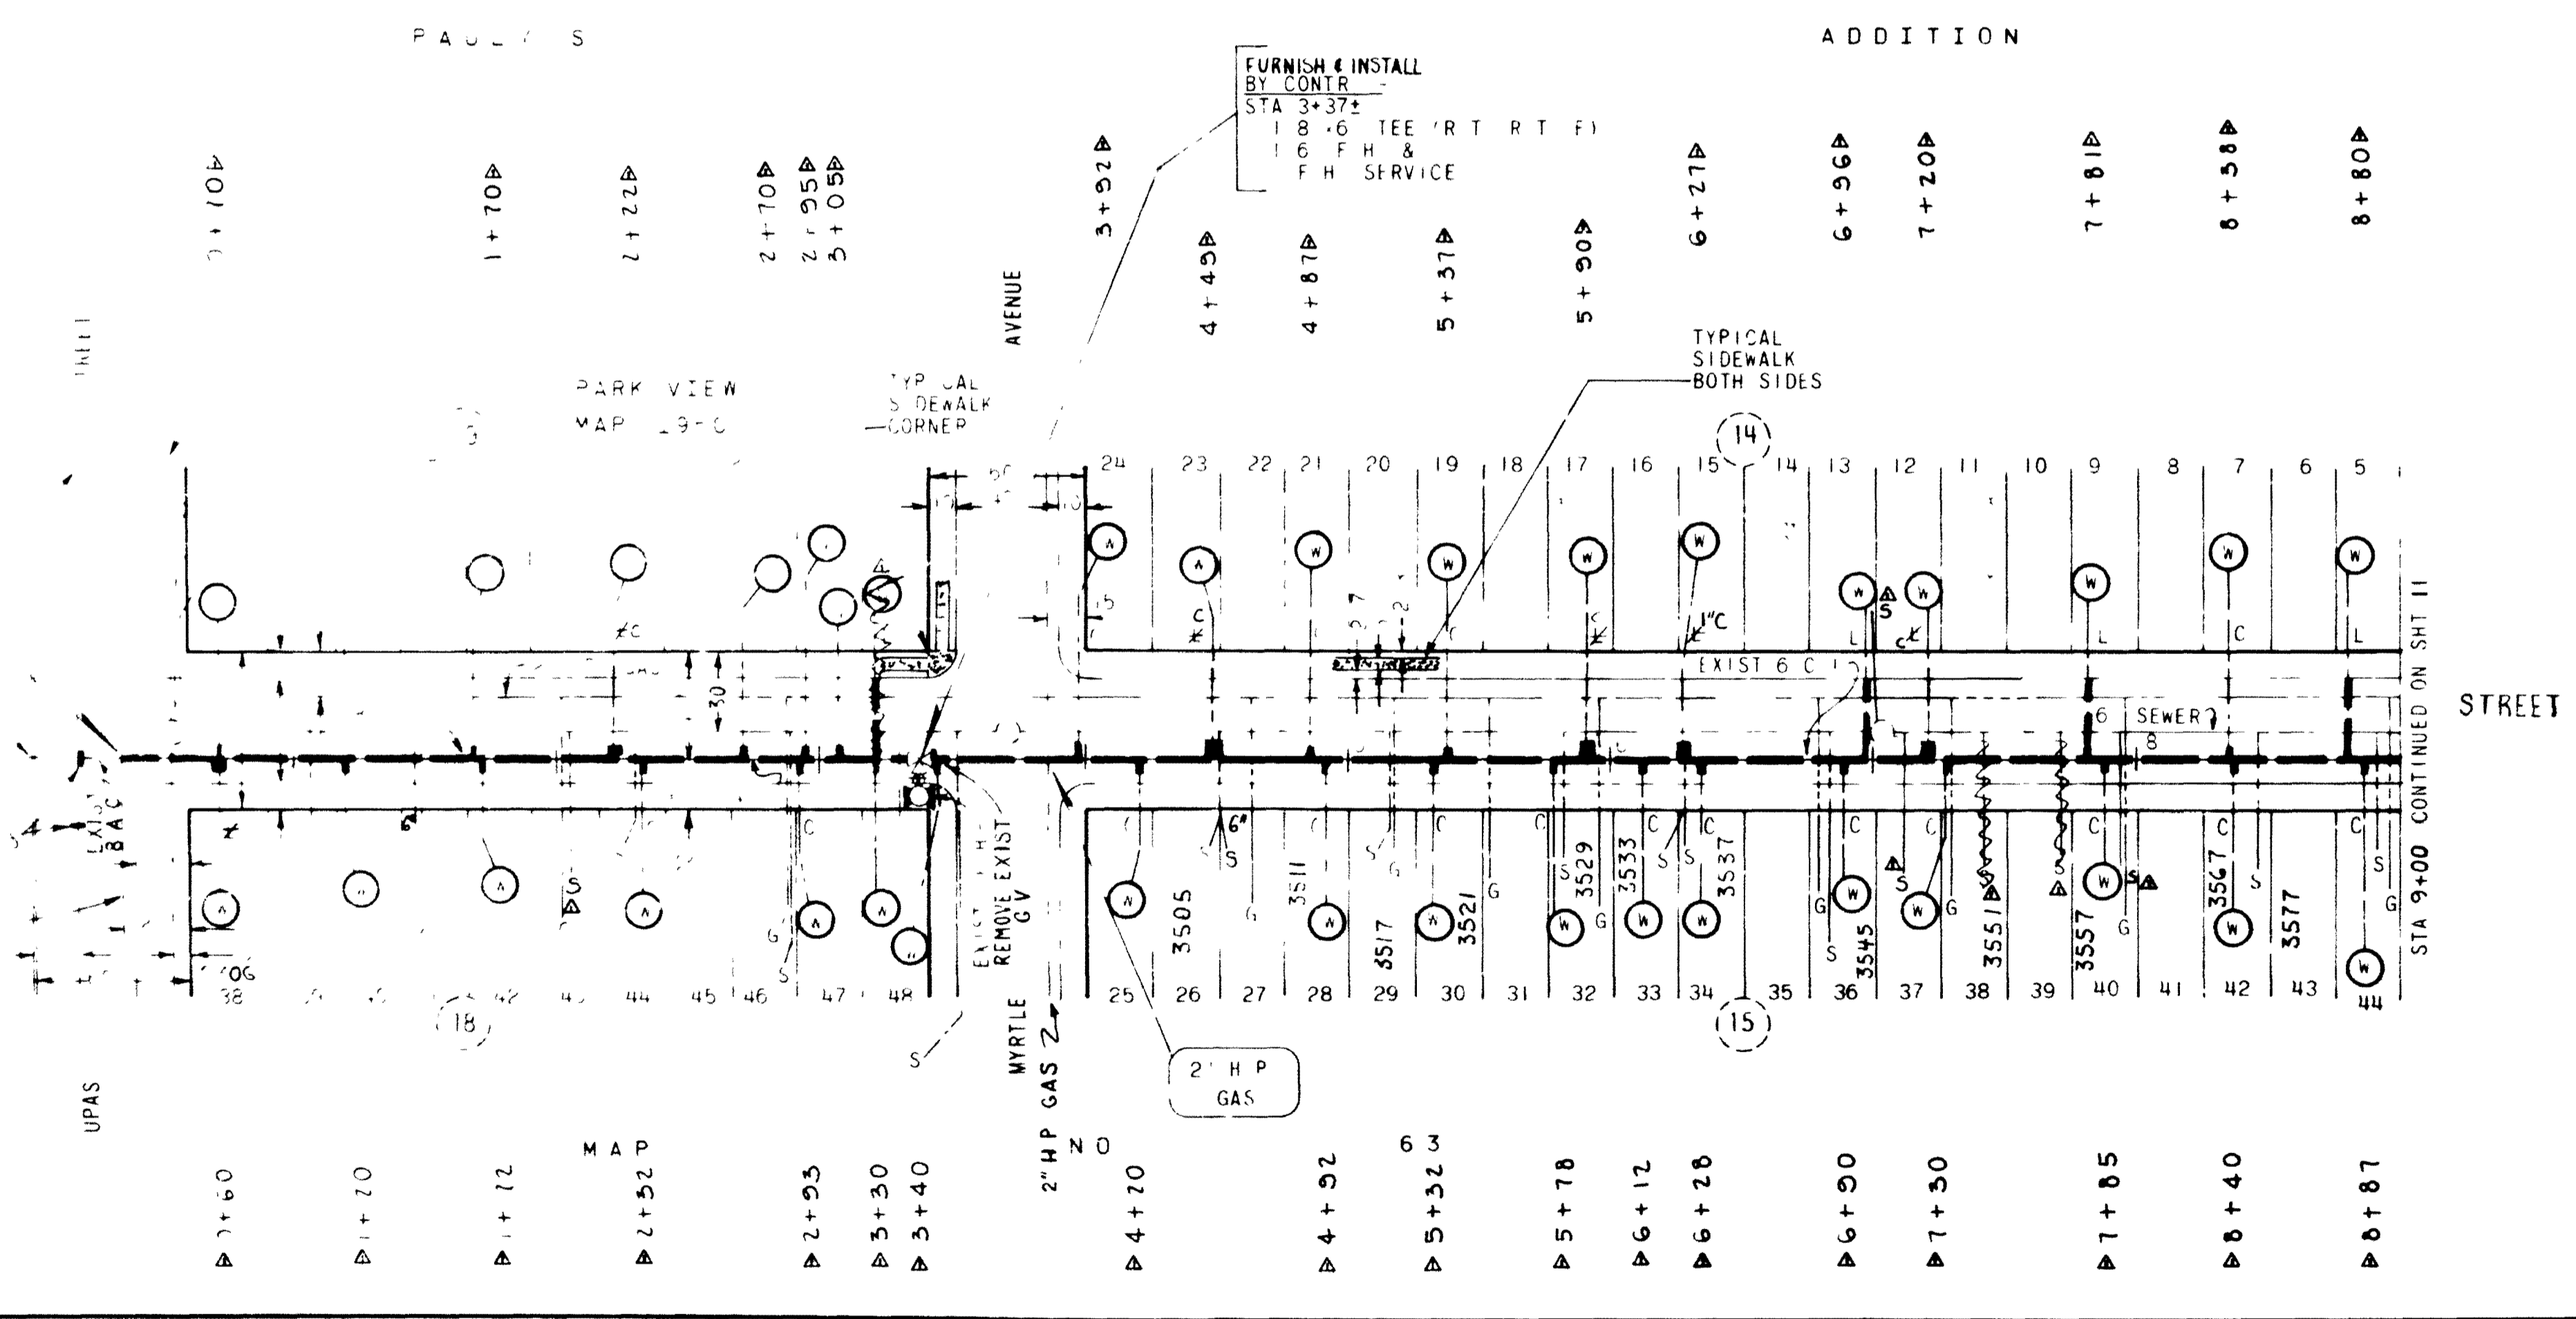

6" 8" A C C PLGS
 58' 57' 40" 57' 40" - 8" A C PIPES
 * SEE LEFT

SCALE - 1" = 50'

GROUP 88	
LOUISIANA STREET 8 A C MAIN	
UPAS STREET TO SAN JUAN	
CITY OF SAN DIEGO, CALIFORNIA	DATE: 12-1-75
UTILITIES DEPARTMENT	SCALE: 1" = 50'
SHEET 10 OF 11 SHEETS	
UTILITIES DIRECTOR	DATE
DESCRIPTION	BY APPROVED
ORIGINAL	BY: BIRLA
AS BUILT PER IN SP	DATE: 12-1-75
FIELD OF NOTES LEE	CONTROL: FIELD OF NOTES
CONSTRUCTION RECORD	DATE: 12-1-75
CONTRACTOR: L M & H	DATE STARTED: 1-72
INSPECTOR: H MILLS	DATE COMPLETED: 2-29-72
CONNECTIONS BY: CITY FORCE	14836 10-D

AS BUILT
 12-1-75

LOUISIANA ST.