


SCALE: HORIZONTAL 1"=50'  
VERTICAL 1"=6'

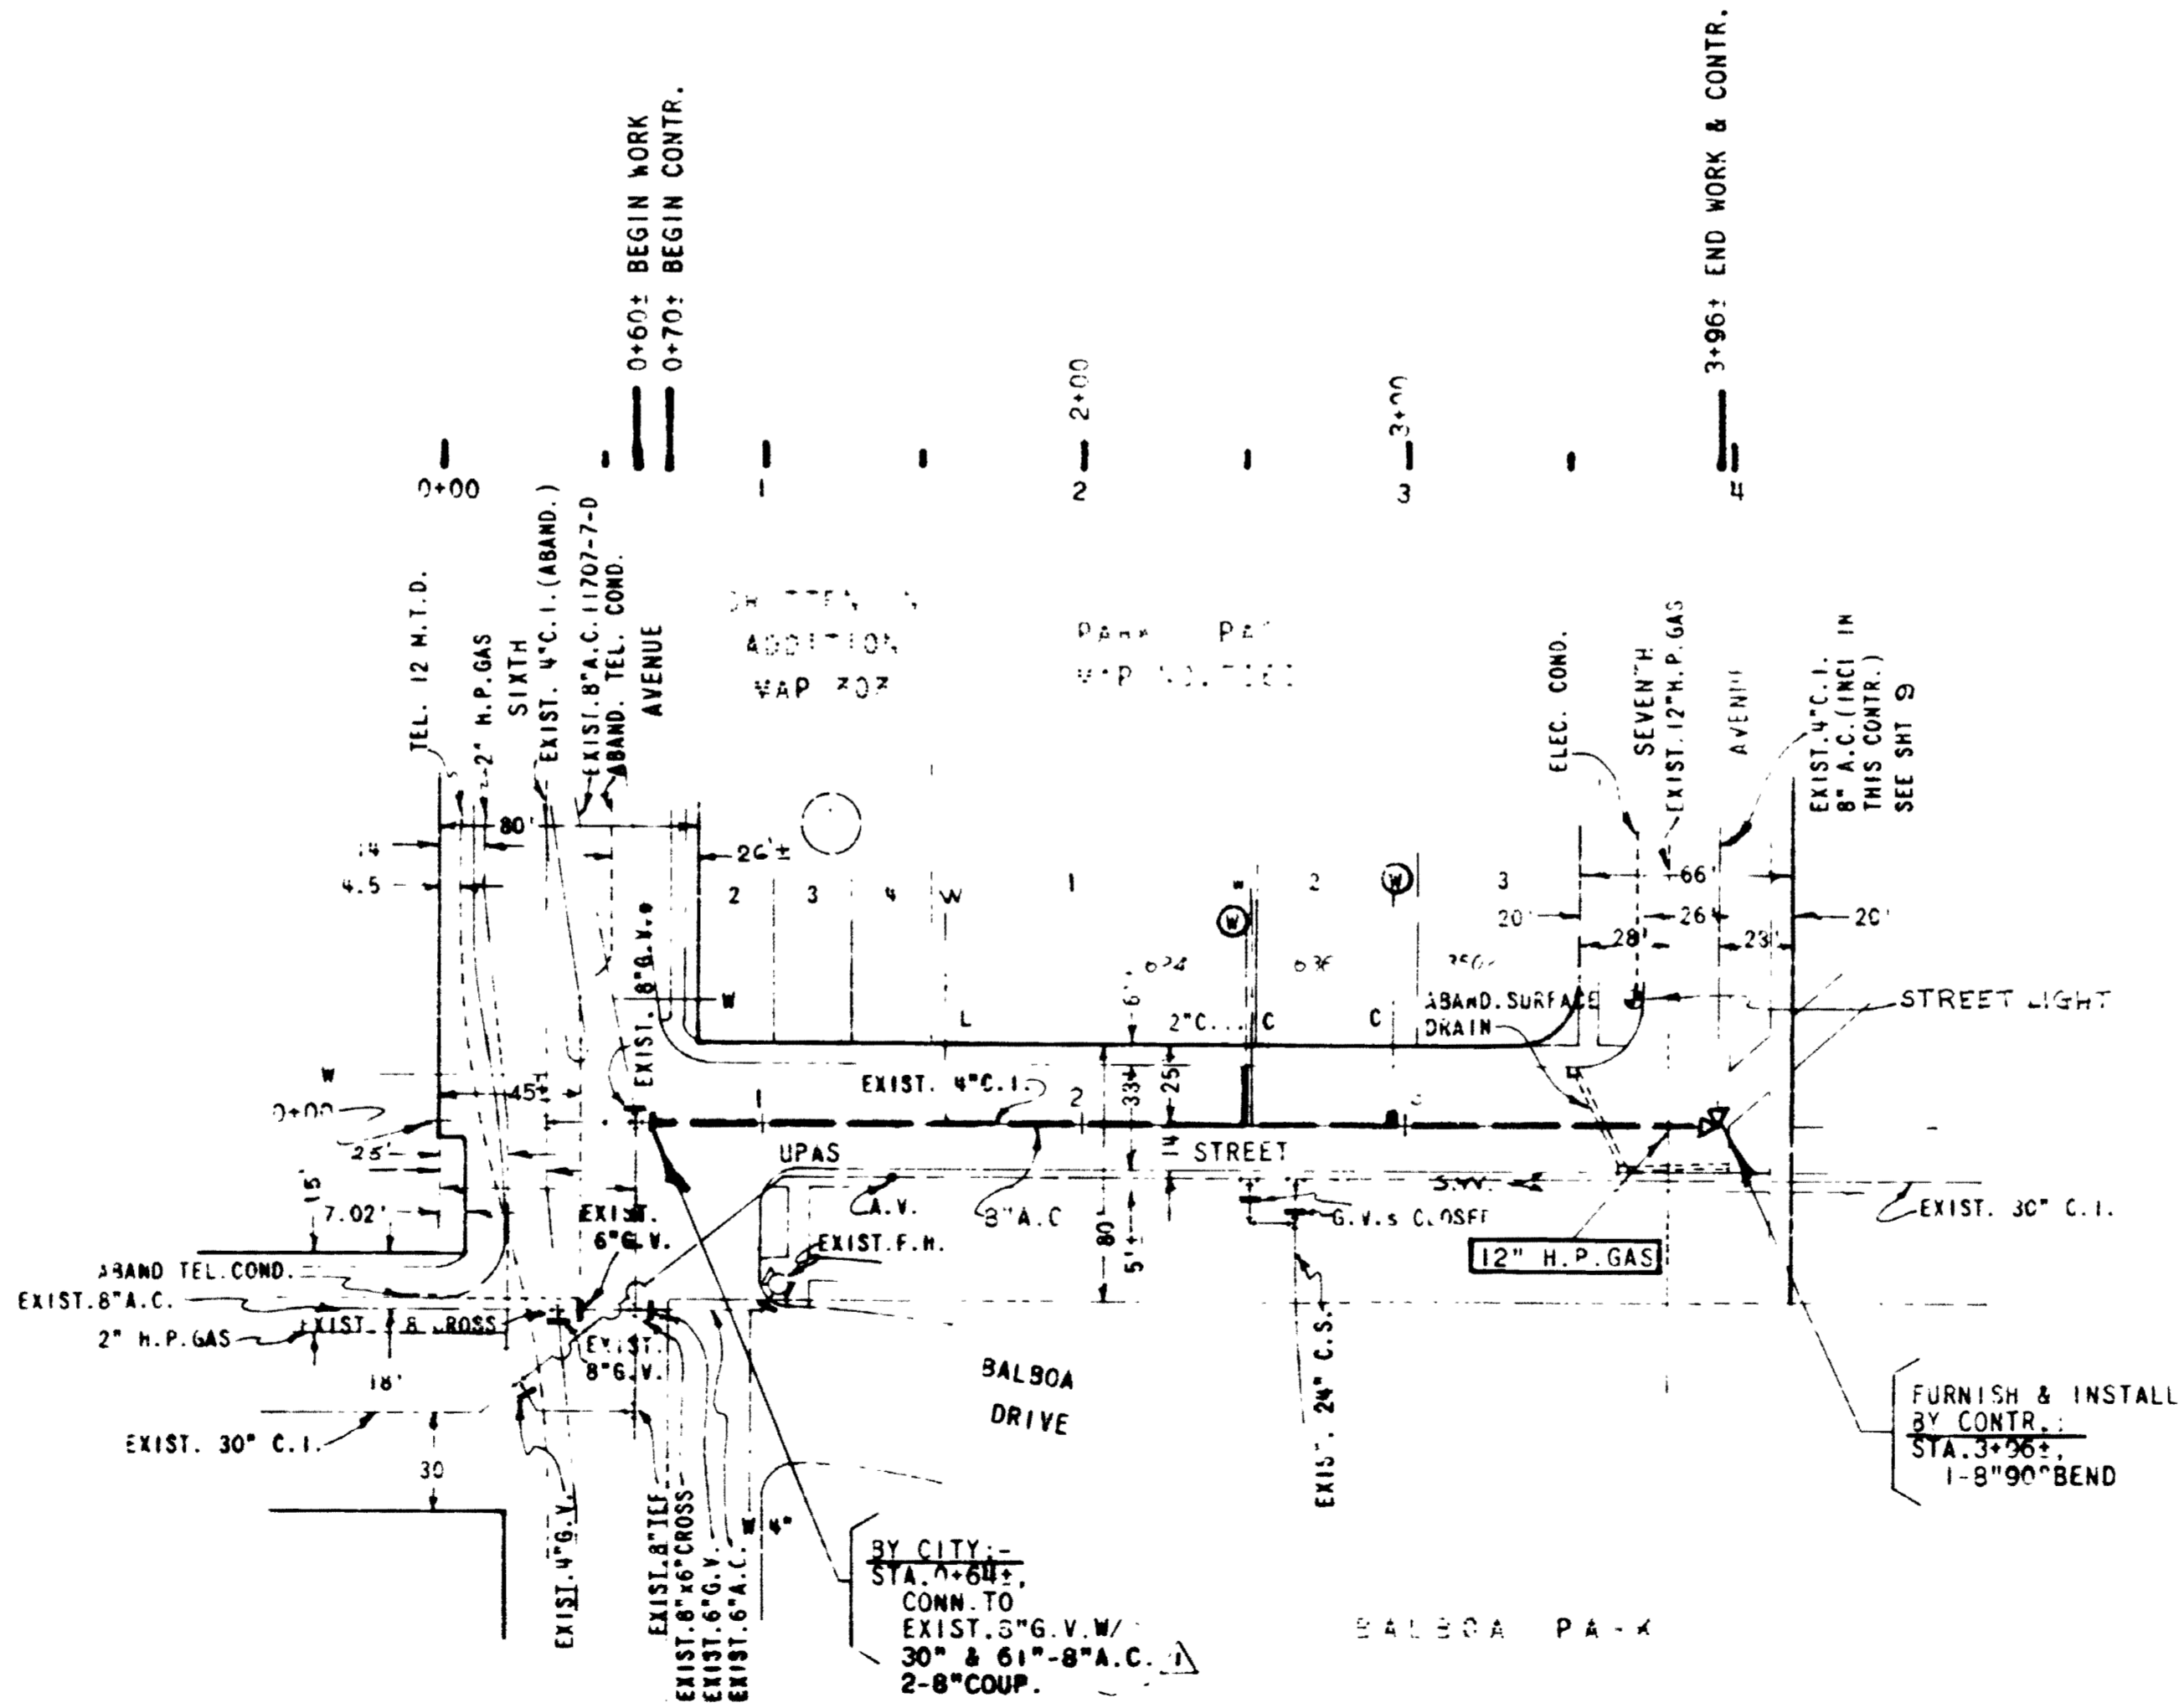

**AS BUILT DATA**  
 CONSTRUCTED BY: NAM BROS. CONST. CO.  
 W.O. 12234 (CONSTR.), W.O. 46376 (ENGR.)  
 PIPE: CERTAINTEE FLUID-TITE A.C.  
 (Kind)  
 GATE VALVES: NONE  
 (Kind)  
 SOIL: SANDY LOAM  
 (Kind)  
 STAKED: 10/7/85  
 (Date)  
 TESTED: 11/3/85  
 (Date)  
 BACKFILL: IMPORT SAND  
 (Kind)  
 Note: Include "CONSTRUCTION RECORD".  
 CONNECTIONS BY: CITY FORCE.  
 W.O. 12235  
 PIPE: 8" A.C.  
 GATE VALVES: NONE

**BENCH MARK: (MEAN SEA LEVEL DATUM)**  
 5+M S.W.B.P. - 6TH ST. & UPAS ST.  
 EL. 294.81

**REFERENCES**  
 SEWER - 8" x 4' SHT 224  
 GAS - 12" SHT 195A  
 GATE SF - SHT 1049  
 11/20/85 2" A.C. 4" IN SIXTH ST.  
 4054 - MAC TEL & TEL CO.  
 FIELD NOTES - 10/7/85 UPAS ST. W.O. 48381

**RETIREMENT**  
 SHT 270

CITY OF SAN DIEGO, CALIFORNIA ENGINEERING DEPARTMENT SHEET 8 OF 12 SHEETS		W.O. NO. 12235
CONTRACTOR: NAM BROS. CONST. CO.	DATE STARTED: 10/7/85	DATE COMPLETED: 11/2/85
INSPECTOR: L.A. BATES	DATE STARTED: 10/7/85	DATE COMPLETED: 11/2/85

UPAS STREET

AS BUILT