


SCALE: 1" = 50' Horizontal
1" = 6' Vertical

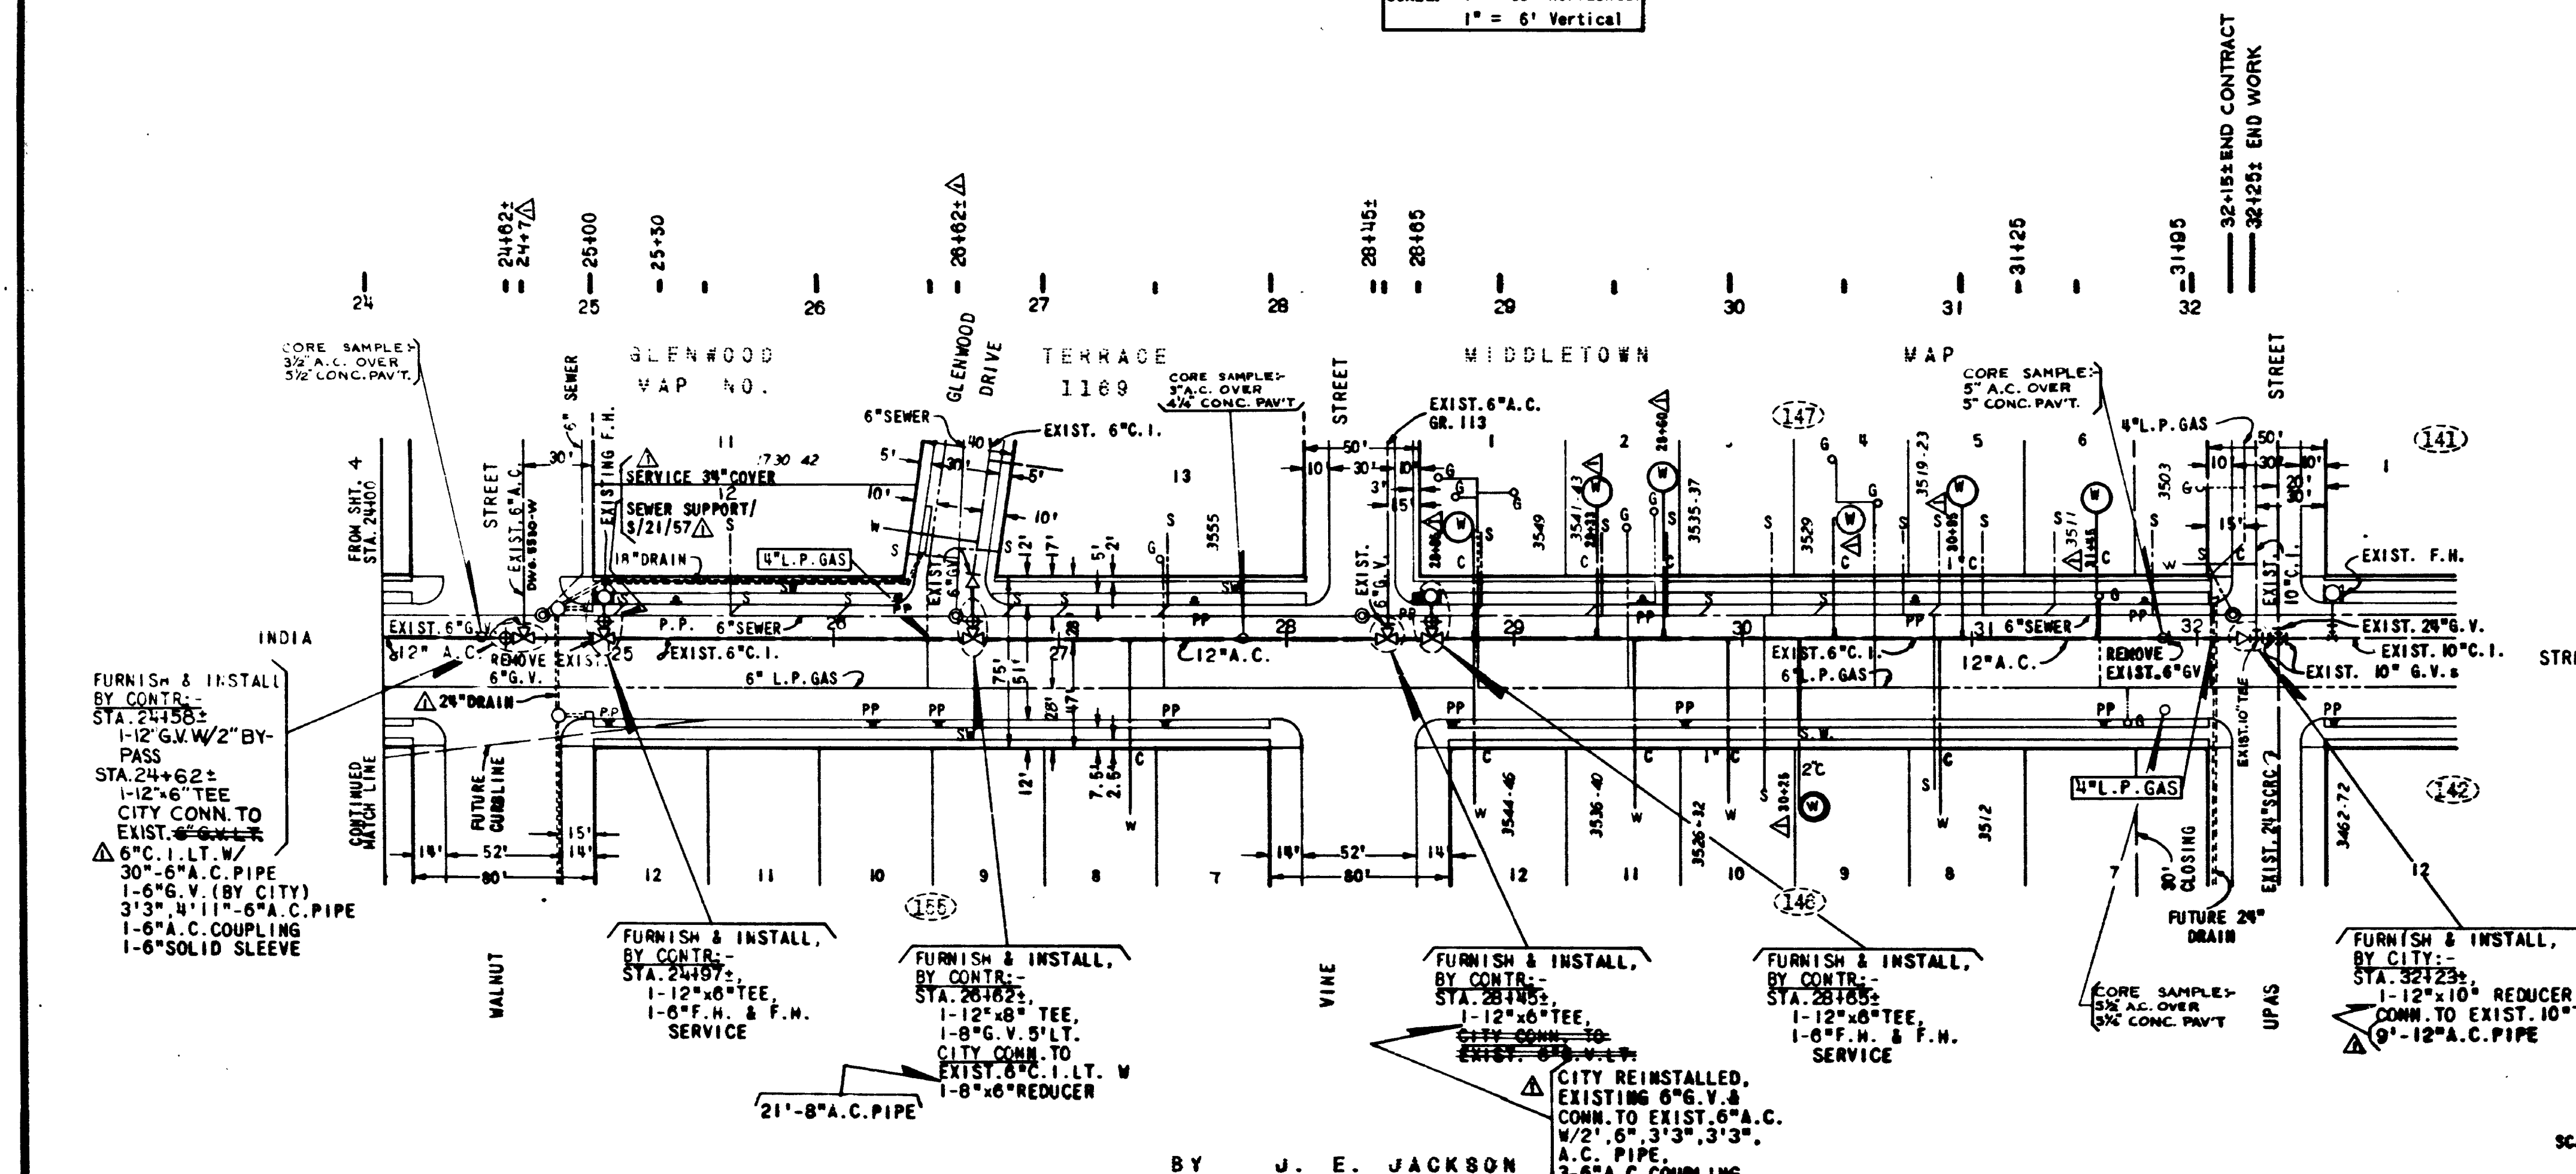

BY J. E. JACKSON

FOR BENCH MARKS, REFERENCES, AS BUILT DATA AND RETIREMENT SEE SHY.

CITY OF SAN DIEGO ENGINEERING DEPARTMENT				SHEET 5 OF 12 SHEETS		ENGINEERING W.O. 00222																								
CROSSTOWN FREEWAY PIPELINES INDIA STREET 12" A.C. MAIN McKee Street to Upas Street																														
<table border="1"> <tr> <th>PLAN REVISION</th> <th>DATE</th> <th>APPROVAL</th> <th>BY</th> <th>DATE</th> <th>APPROVAL</th> <th>BY</th> </tr> <tr> <td>7/14/09</td> <td>8/19/09</td> <td></td> <td>E.C. Losch</td> <td></td> <td></td> <td></td> </tr> </table>							PLAN REVISION	DATE	APPROVAL	BY	DATE	APPROVAL	BY	7/14/09	8/19/09		E.C. Losch													
PLAN REVISION	DATE	APPROVAL	BY	DATE	APPROVAL	BY																								
7/14/09	8/19/09		E.C. Losch																											
<table border="1"> <tr> <td>DESIGNED</td> <td>BY</td> <td>DATE</td> <td>APPROVAL</td> </tr> <tr> <td>E.C. LOSCH</td> <td>E.C. LOSCH</td> <td>8/19/09</td> <td></td> </tr> </table>		DESIGNED	BY	DATE	APPROVAL	E.C. LOSCH	E.C. LOSCH	8/19/09		<table border="1"> <tr> <td>CITY ENGINEER</td> <td>APPROVAL FOR</td> <td>DATE</td> </tr> <tr> <td></td> <td>CONSTRUCTION</td> <td></td> </tr> </table>		CITY ENGINEER	APPROVAL FOR	DATE		CONSTRUCTION		<table border="1"> <tr> <td>WATER DEPT.</td> <td>SEWERAGE</td> </tr> <tr> <td>PLANNING DEPT.</td> <td>DEBRIDGE</td> </tr> <tr> <td>ELECTRICAL</td> <td>HIGHWAY</td> </tr> <tr> <td>STRUCTURAL</td> <td>GRADING</td> </tr> <tr> <td>TRAFFIC</td> <td>CONTROL</td> </tr> </table>			WATER DEPT.	SEWERAGE	PLANNING DEPT.	DEBRIDGE	ELECTRICAL	HIGHWAY	STRUCTURAL	GRADING	TRAFFIC	CONTROL
DESIGNED	BY	DATE	APPROVAL																											
E.C. LOSCH	E.C. LOSCH	8/19/09																												
CITY ENGINEER	APPROVAL FOR	DATE																												
	CONSTRUCTION																													
WATER DEPT.	SEWERAGE																													
PLANNING DEPT.	DEBRIDGE																													
ELECTRICAL	HIGHWAY																													
STRUCTURAL	GRADING																													
TRAFFIC	CONTROL																													
<table border="1"> <tr> <td>CONTR. E.C. LOSCH CO.</td> <td>INSP. H. HILLS</td> </tr> </table>						CONTR. E.C. LOSCH CO.	INSP. H. HILLS	<table border="1"> <tr> <td>CROSSING: NONE</td> </tr> <tr> <td>FIELD BOOK</td> </tr> </table>	CROSSING: NONE	FIELD BOOK																				
CONTR. E.C. LOSCH CO.	INSP. H. HILLS																													
CROSSING: NONE																														
FIELD BOOK																														
11539-5-D						INDEXED																								

INDIA STREET