

FURNISH & INSTALLED BY CITY:
 STA. 3122 LT.
 68' OF 10" C.I. PIPE
 1-10" TEE 10' LT.
 9'0" OF 10" NIPPLE
 1-10" 22.5° VERT. BEND B&B, 10' LT.
 1-8" 10° VERT. BEND B&B, 5' AS.
 1-8" 45° VERT. BEND B&B, 5' AS.
 63' OF 8" C.I. PIPE
 1-8" 45° VERT. BEND B&B
 STA. 3122 RT.
 51'8" OF 10" C.I. PIPE
 1-10" 45° VERT. BEND B&B
 7' OF 10" C.I. PIPE
 1-10" VERT. BEND B&B
 W.O. 58283

BY CITY: Δ
 STA. 0+48
 CONN. TO EXIST. 24" X 12" CROSS. W/ Δ
 5' OF 24" C.I. PIPE
 1-24" SPLIT SLEEVE
 W.O. 58263

FURNISH & INSTALL. BY CONT'D:
 STA. 3122 Δ
 1-24" X 10" CROSS (B&F)
 NOTE: DRILL FLGD. BOLT HOLES 10" 30" TO RT. OF STD. POSITION.
 2-10" G.V. 1/2" FLGD. RT. & LT.
 2-10" FLG. TO SPGT. ADAPTOR RT. & LT.
 BY CITY: Δ

FURNISH & INSTALLED BY CITY:
 STA. 3122 (FORWARD)
 2' OF 24" C.I. PIPE
 2' OF 24" C.I. PIPE B&F
 STA. 3128
 1-24" G.V. B&F 70 TURNS
 MUELLER & CONN. TO EXIST. 24" C.I. W/ 8" OF 24" C.I. B&B
 W.O. 27045


REFERENCES:
 Water Rk. 10, Sht. F-20-A
 Sewer Rk. 2, Sht. 122, 168
 Sewer Rk. 1, Sht. 10, 20
 Gate Book
 2094-1 (Water)
 XI-20-2-20-0 State Highway

AS BUILT DATA
 CONSTRUCTED BY: W.V. HUTCHISON CO., INC.
 W.O. 68282 (CONSTR.), W.O. 48281 (ENGR.).
 PIPE: S.C.R.C.
 GATE VALVES: RICH
 SOIL: SANDY LOAM
 STAKED: 8/14/68
 TESTED: 9/5/68
 BACKFILL: IMPORVED BEACH SAND
 Note: Include "CONSTRUCTION RECORD".
 CONDITIONS BY: CITY FORCE.
 W.O. 58283
 PIPE: 10" & 24" C.I.
 GATE VALVE: MUELLER


RETIREMENT
 Δ 282' - 24" C.I. 1/2"
 Δ 351' - 10" C.I. 1/2"
 Δ 1-10" G.V. 1810
 1-8" F.M. & F.N. Serv. 1940

BENCH MARK: (City Datum)
 B.M. S.E.S.P. Kettner Blvd. & Redwood St., El. 58.53'

SCALE: 1" = 50'

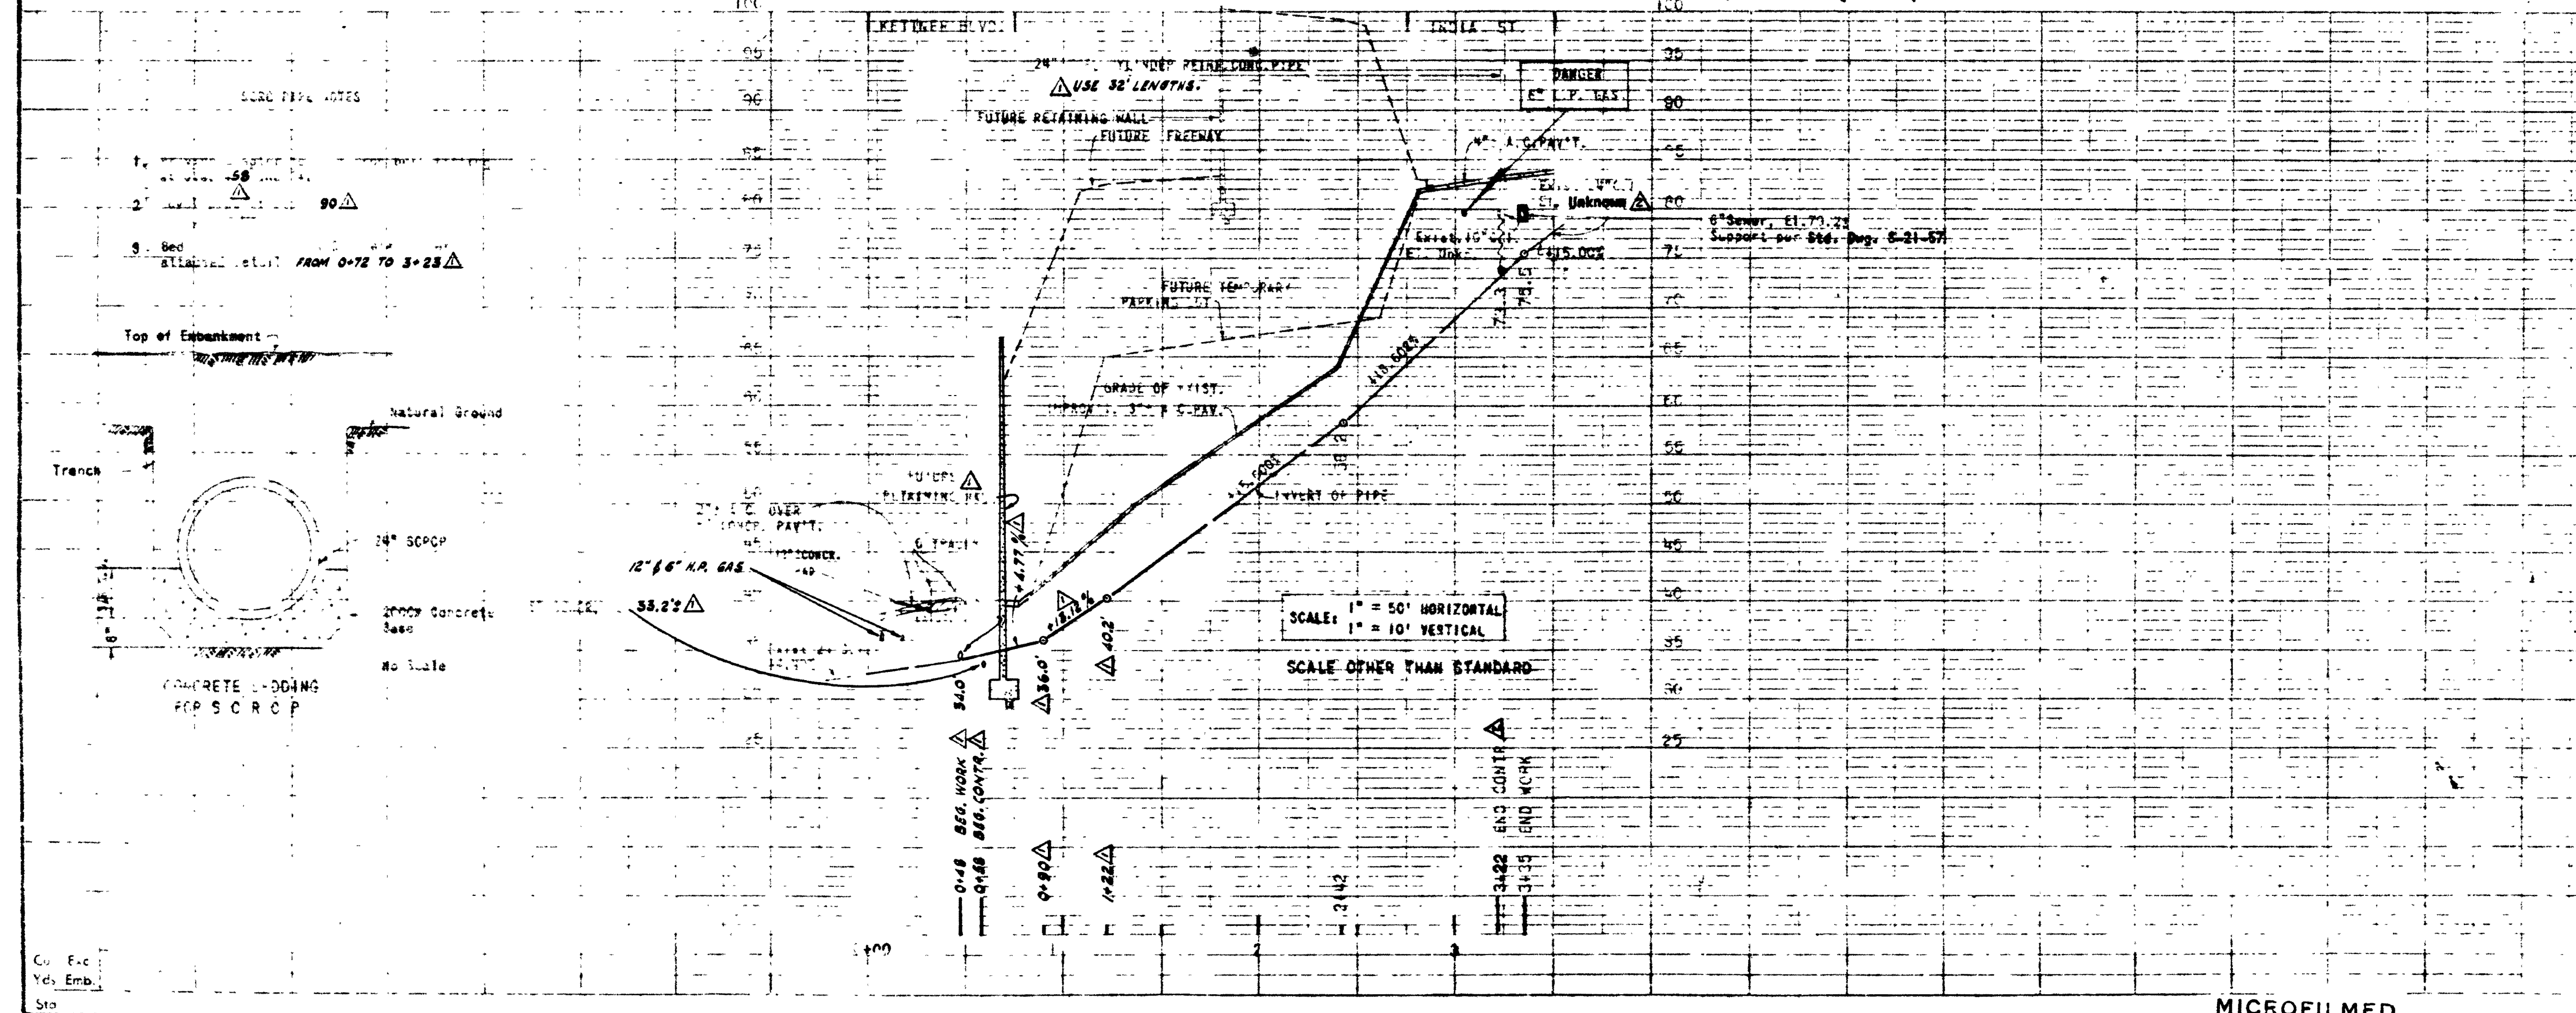

1. ...
2. ...
3. Bed attached to ... from 0+72 to 3+23 Δ

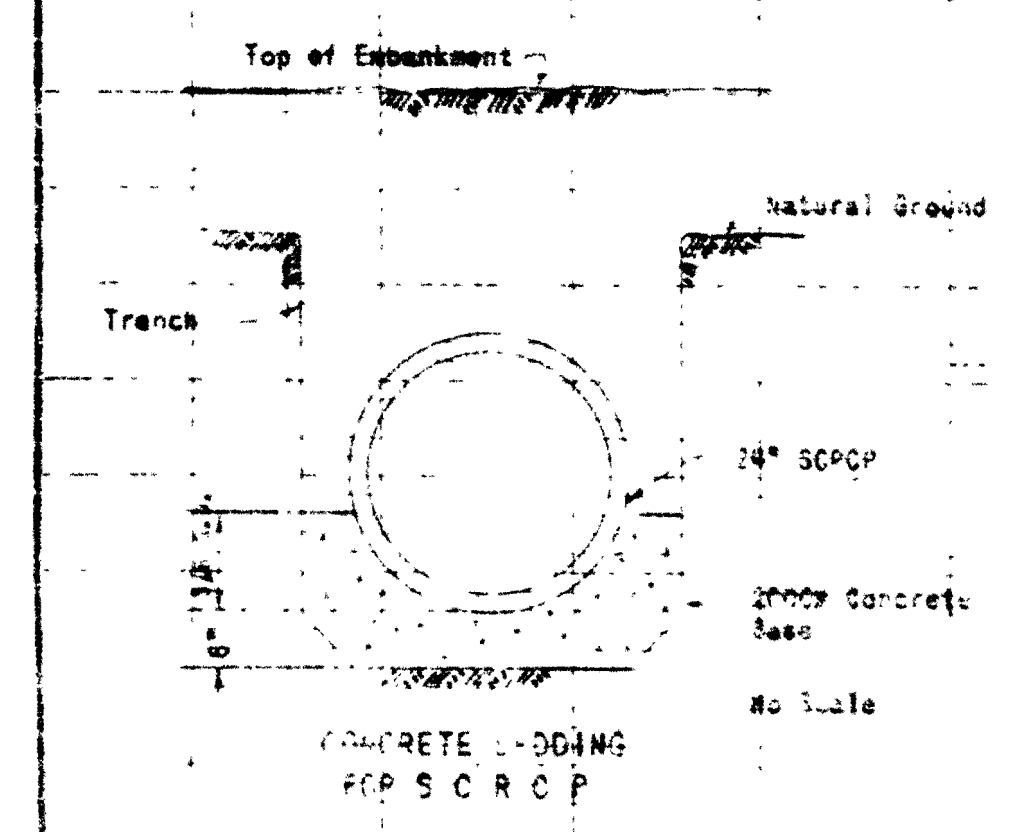

CONSTRUCTION CHANGE

CONSTRUCTION CHANGES		E.A. Hutchison	
NO.	DESCRIPTION	DATE	BY
1	TOTAL RETIREMENT AT KETNER BLVD.		

10" & 24" WATER MAIN
 KETNER BOULEVARD TO INDIA STREET
 SHEET 2 OF 2
 ENGINEER: E.A. Hutchison
 DATE: 4/2/68
 CHECKED: MUELLER
 W.O. NO. 11-2-24D

MICROFILMED

JAN 16 1971

AS BUILT MICROFILMED 5-20-A

MAR 18 1968

11-43-KD