

NOTE: MINIMUM 3' COVER ON TOP OF PIPE

PROPOSED PIPE DATA TABLE			
NO.	Δ / BEARING	RADIUS	REMARKS
11	N69°54'21\"/>		

COORDINATE TABLE			
NO.	NORTHING	EASTING	DESCRIPTION
210081.1	9015	1717701.2302	22 1/2\"/>

REFERENCE:
 BENCH MARK: SWBP REYNARD WAY AND OTSEGO DRIVE
 ELEVATION - 138.566 MSI
 FIELD NOTES: WENWORTH 3-16-89, W.O. 181021W, 171591S
 INDEX 210-1716
 WATER: 2126-L, 2127-1-L
 SEWER: 7062-2-D, 7063-3-D, 7064-4-D, 1034-3-D,
 1035-4-D, 2126-L, 2127-1-L, 2127-L
 STORM DRAIN: 366-L, 367-1-L, 2126-L, 2127-L,
 10802-2-D, 13602-3-D, 13602-4-D,
 GAS: 2-155, 2-157A, 2-184A
 ELECTRIC: 210-1717-5
 CABLE TV: 210-716
 TELEPHONE: 184008
 IMPROVEMENTS:
 WATER GATE BOOK: F-19
 SEWER GATE BOOK: F-19
 100' SCALE: 210-1716
 THOMAS BROS.: 1268, J-6

NOTE:
 CURLEW STREET
 REYNARD WAY TO SLOANE AVE. SHALL BE HIGHLIGHTED BY
 CITY FORCES PRIOR TO START OF CONSTRUCTION. CITY TO
 FURNISH HIGHLIGHTING MATERIAL AND MAKE ALL CONNECTIONS.

RETIREMENT:
 850' 6\"/>

WATER AND SEWER GROUP 487
CURLEW STREET
 REYNARD WAY TO S/O BROOKES AVENUE
 MIDDLETOWN AREA

CITY OF SAN DIEGO, CALIFORNIA
 ENGINEERING & CAPITAL IMPROVEMENTS DEPARTMENT
 SHEET 9 OF 62 SHEETS

APPROVED: *[Signature]* DATE: 4/10/98

DESCRIPTION: ORIGINAL LMA

DATE: 04-14-98 W.O.: 11776 DRN: RMK DES: KM


LINTVEDT, McCOLL & ASSOCIATES

AS-BUILT LMA DATE: 4/10/98

CONTRACTOR: DATE STARTED: DATE COMPLETED: 12-15-00

210-1716
 25858-9-D

- BY CONTRACTOR:
 FURNISH & INSTALL
 STA. 10 + 05.74
 1- 8" 22 1/2" BEND (MJ)
- BY CONTRACTOR:
 FURNISH & INSTALL
 STA. 10 + 24.55
 1- 8"X6" TEE (MJ,MJ,F)
 1- 6" F.H. ASSEMBLY (W-10)
- BY CONTRACTOR:
 FURNISH & INSTALL
 STA. 11 + 35.50
 1- 8" 22 1/2" BEND (MJ,F)
 1- 8" 11 1/4" BEND (F,MJ)
- BY CONTRACTOR:
 FURNISH & INSTALL
 STA. 13 + 03.30
 1- 8" 22 1/2" BEND (MJ)
- BY CONTRACTOR:
 FURNISH & INSTALL
 STA. 15 + 41.63
 1- 8" 11 1/4" BEND (MJ)
- BY CONTRACTOR:
 FURNISH & INSTALL
 STA. 15 + 66.93
 1- 8"X6" TEE (MJ,MJ,F)
 1- NEW 6" F.H. ASSEMBLY (W-10)
- BY CONTRACTOR:
 FURNISH & INSTALL
 STA. 17 + 97.84
 1- 8" 22 1/2" BEND (MJ)

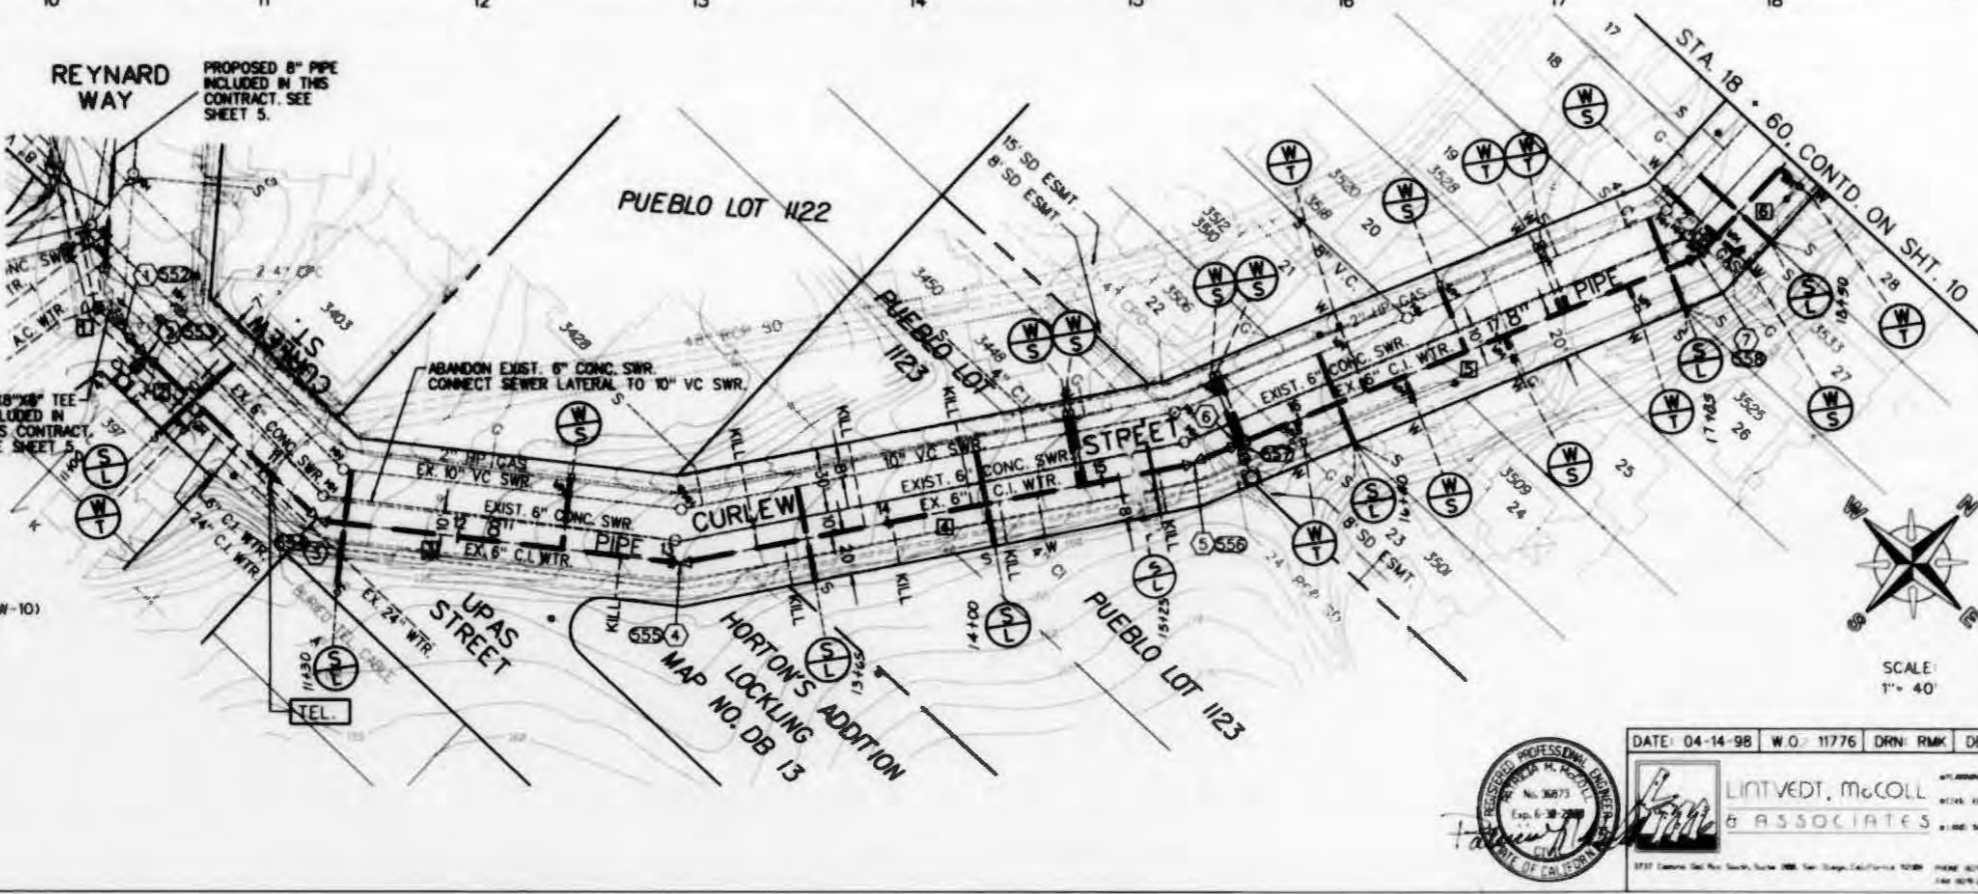

f:\ustation\776\776-09wr.dgn
 plot @ 1"=40'

PRINTED FROM THE ORIGINAL. BEST QUALITY
 OBTAINABLE. EXCESSIVE GRAY BACKGROUND
 MAY CAUSE A POOR QUALITY REPRODUCTION.



CURLEW STREET

AS - BUILT