


SCALE:
1" = 50' HORIZONTAL
1" = 6' VERTICAL

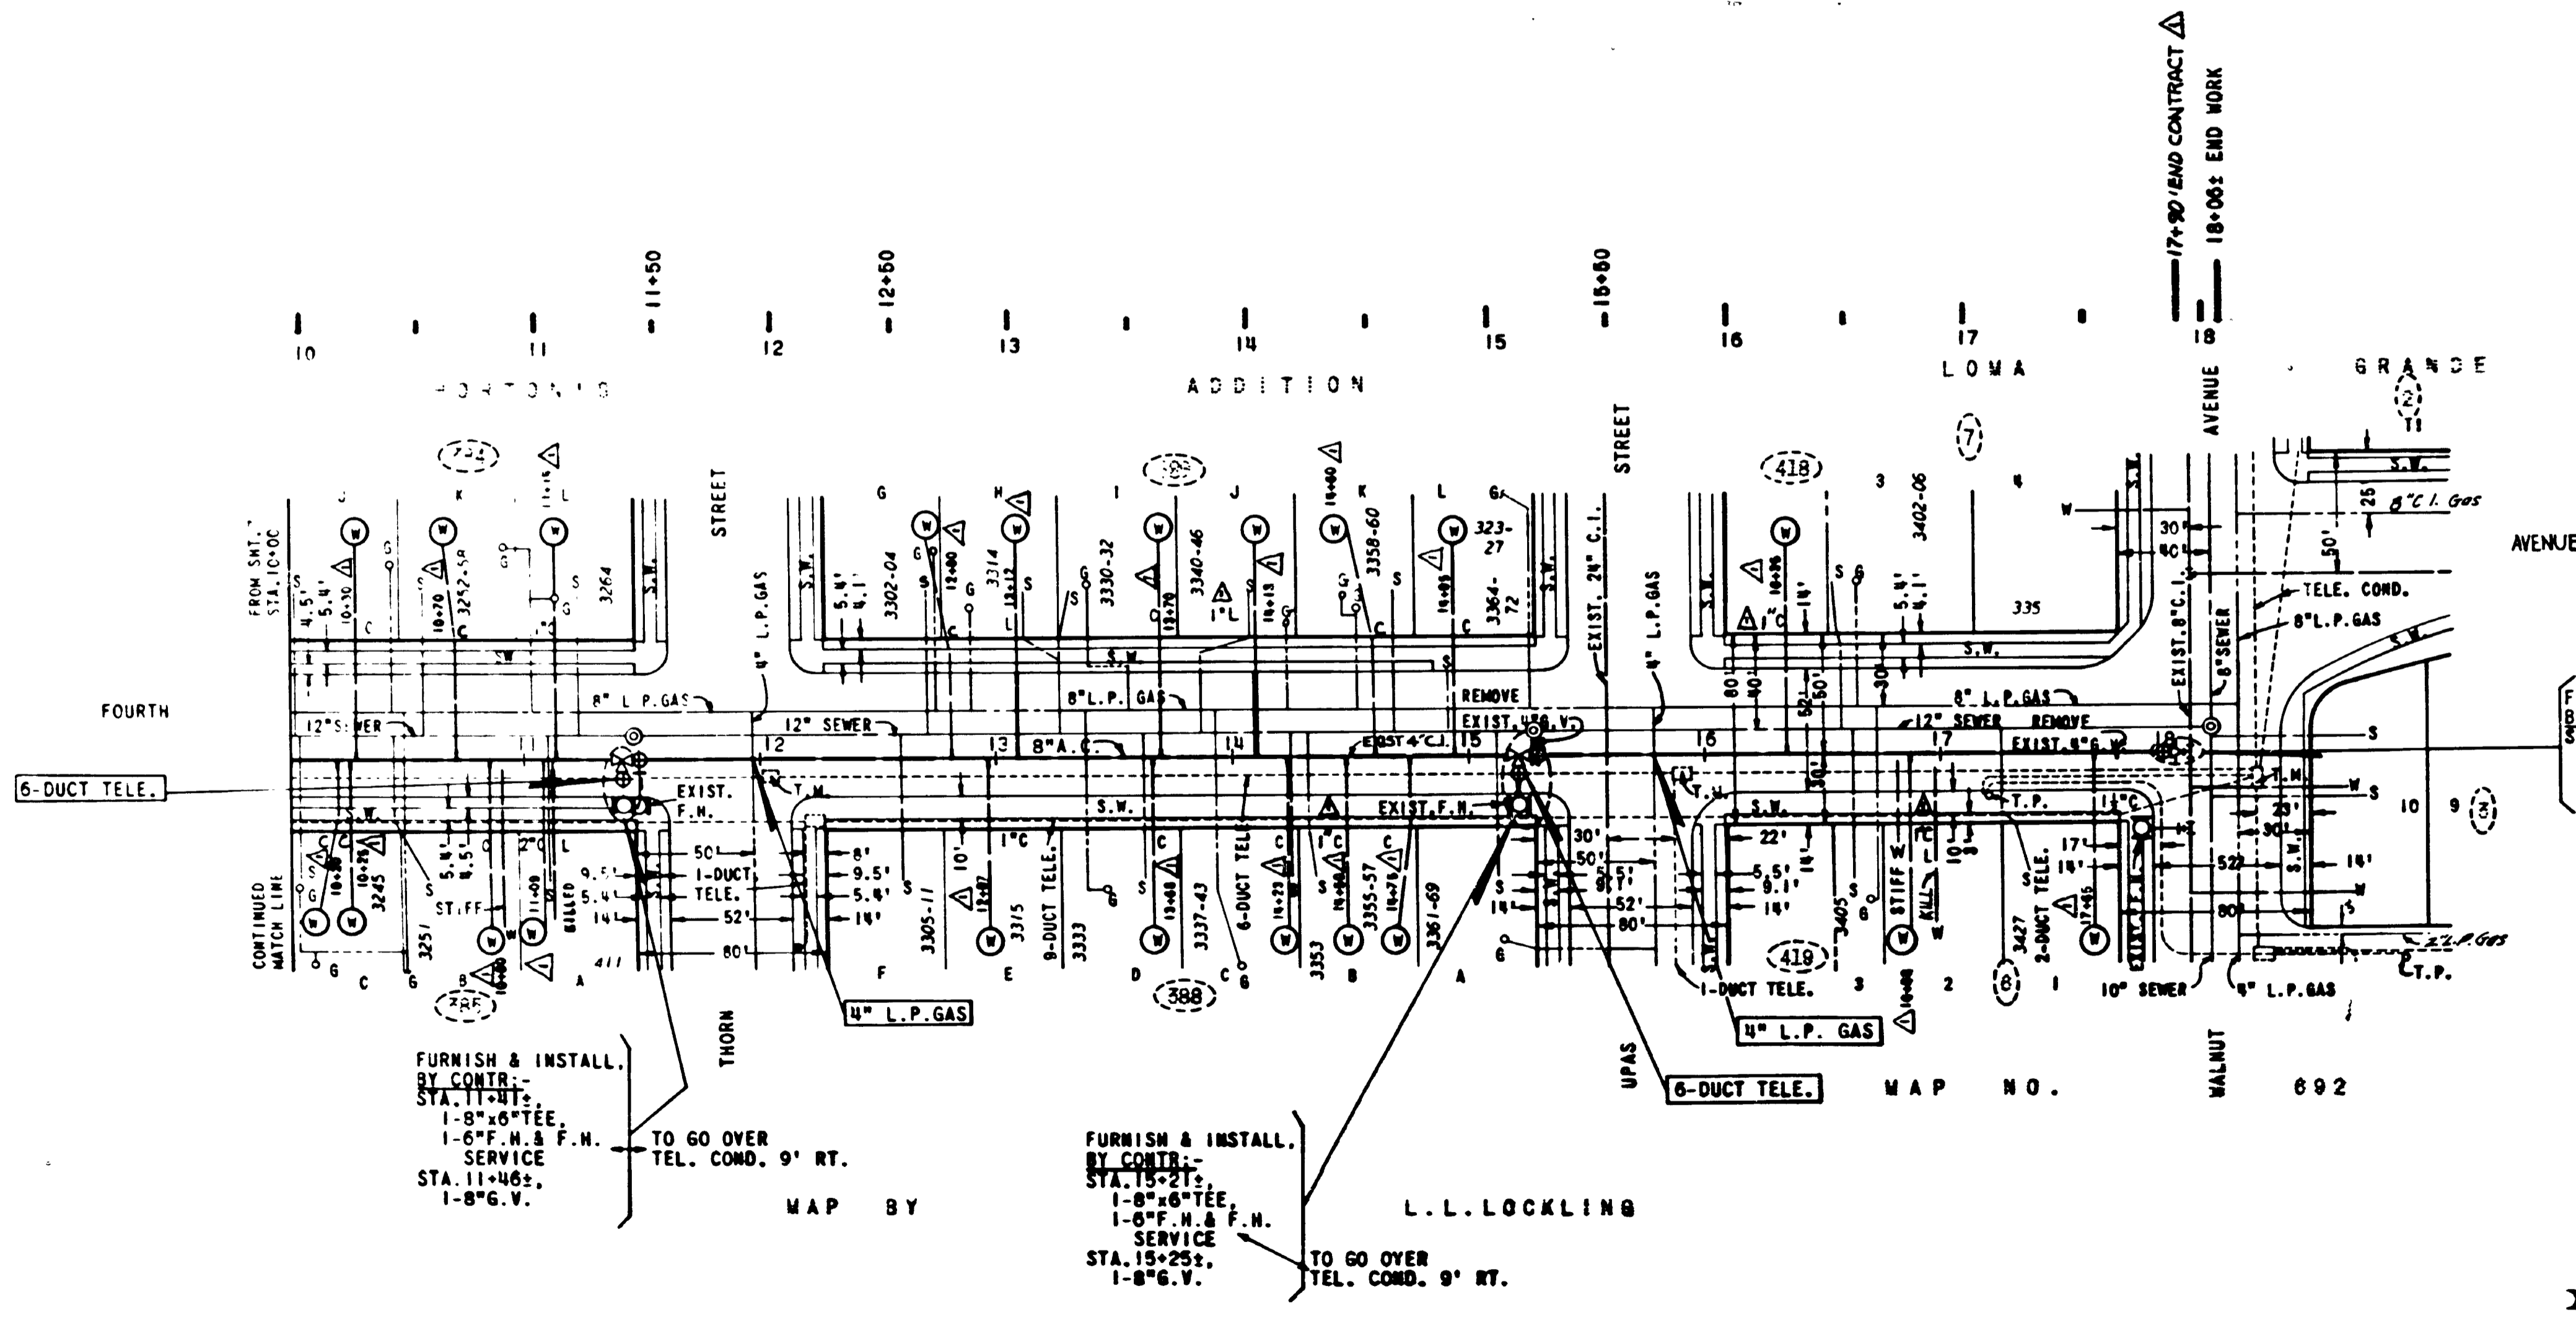

FOR BENCH MARKS, REFERENCES, RETIREMENT, AND AS BUILT DATA SEE SMT. 7

FURNISH & INSTALL. BY CONTR. STA. 11+21 TO 11+46.5. 1-6" F.H. & F.H. SERVICE. 1-8" G.V.

FURNISH & INSTALL. BY CONTR. STA. 15+21 TO 15+25. 1-6" F.H. & F.H. SERVICE. 1-8" G.V.

FURNISH & INSTALL. BY CITY. STA. 18+03 TO 18+06. 1-9" 4" RED. S&S CONN. TO EXIST. 8" x 4" TEE. 6" 6" 3" 5" 8" A.C. PIPE. 2-8" A.C. COUP. 1-8" G.V.

GROUP 139 FOURTH AVENUE 8" A.C. MAIN Quince Street To Walnut Avenue		MICROFILMED DEC 7 1965	ENGINEERING W.O. 4690 INDEXED JAN 1 1965
CITY OF SAN DIEGO ENGINEERING DEPARTMENT			
PLAN REVISION		SHEET 8 OF 17 SHEETS	
CHANGED BY	DATE	APPROVAL	DATE
		<i>E.A. Baker</i>	DEC 11 1962
DESIGNED BY	DATE	CITY ENGINEER	APPROVABLE FOR
PLANNED BY	DATE	ENGINEER	APPROVABLE FOR
CONSTRUCTION	DATE	ENGINEER	APPROVABLE FOR
FIELD DATE	DATE	ENGINEER	APPROVABLE FOR
200-1700			
11720-0-0		AS BUILT AS BUILT	

SCALE: 1" = 50'

FOURTH AVENUE QUINCE ST. TO WALNUT AVE.