


- 1 BY CITY FORCES STA 0+80± ON C.L. BEFORE CONTRACTOR CUT AND PLUG EX. 10" CI BY CITY AFTER ACCEPTANCE OF NEW MAIN IN HAWK ST.- RECONNECT
- 2 BY CITY FORCES STA 6+58±, 30' RT BEFORE CONTRACTOR CUT AND PLUG EX. 8" A.C. BY CITY AFTER ACCEPTANCE OF NEW MAIN IN HAWK ST.- RECONNECT
- 3 BY CITY FORCES BEFORE CONTRACTOR STA 10+36±, 30' RT CUT & PLUG EX. 24" C.I. STA 10+72±, RT CUT & PLUG EX. 10" C.I. BY CITY AFTER ACCEPTANCE OF NEW MAIN IN HAWK ST.- RECONNECT
- 4 BY CONTRACTOR STA 0+66.9± TO STA 10+27±, 10' RT FURNISH AND INSTALL 10" WATER
- 5 BY CONTRACTOR STA 0+66.9±, 10' RT FURNISH AND INSTALL 1-10" TEE MJxMJxFLG 1-10" 45° BEND FLG 1-10" 1-1/4" BEND FLG 1-10" G.V. FLGxMJ, AHD
- 6 BY CONTRACTOR STA 2+46.1±, 9.9' LT FURNISH & INSTALL 1-10" x6" TEE MJxMJ,FLG 1-6" F.H. ASSEMBLY F.H. MARKER
- 7 BY CONTRACTOR STA 6+22.2±, 9.8' RT FURNISH & INSTALL 1-10" x6" TEE MJxMJ,FLG 1-6" F.H. ASSEMBLY F.H. MARKER
- 8 BY CONTRACTOR STA 6+58.0±, 10' LT FURNISH & INSTALL 1-10" x10" x8" TEE, MJxMJ,FLG 1-10" G.V. MJxFLG BK 1-6" F.H. ASSEMBLY F.H. MARKER
- 9 BY CONTRACTOR STA 10+17.9±, 9.7' LT FURNISH & INSTALL 1-10" x6" TEE MJxMJ,FLG 1-6" F.H. ASSEMBLY F.H. MARKER
- 10 BY CITY STA 10+37±, 10' RT FURNISH & INSTALL 1-24" x24" x10" x10" CROSS MJxMJxFLGxFLG 2-10" G.V. MJxFLG BK, AHD STA. 10+26, 10' RT, TO STA. 10+36, 10' RT 10" WATER

COORDINATE TABLE			PROPOSED PIPE DATA TABLE					
NO.	NORTHING	EASTING	DESCRIPTION	NO.	Δ / BEARING	RADIUS	LENGTH	REMARKS
01	1849500.67	6277087.07	STA 00+00.00	1	N00° 04' 21" E	-	591' ±	10" WATER PIPE
02	1850600.66	6278088.34	STA 11+00.00	2	N00° 04' 21" E	-	375' ±	10" WATER PIPE

CENTERLINE DATA			
NO.	Δ / BEARING	RADIUS	LENGTH
1	N00° 04' 21" E	-	1100.00'

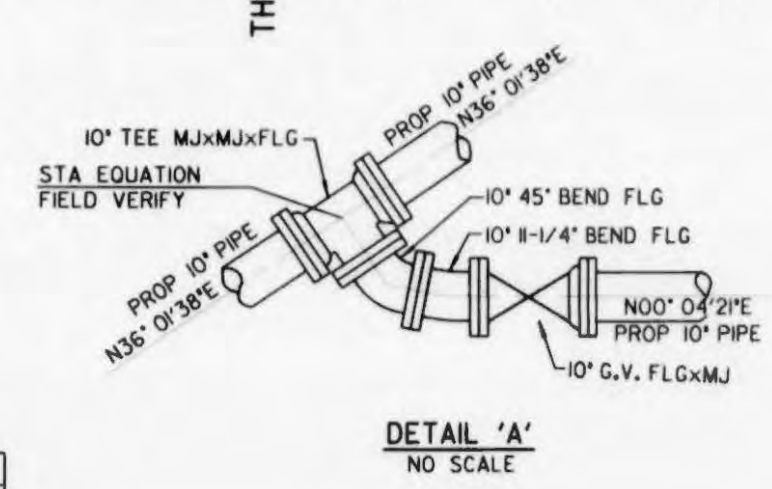

REFERENCE:
 BENCH MARK: SWBP REDWOOD ST. AND COLUMBIA ST. ELEVATION 147.24 MSL
 FIELD NOTES: FARNSWORTH 208/1713 7-26-'94, WO 172521
 WATER: 14695-2-D, 19695-7-d, 10234-12-D
 SEWER: N/A
 STORM DRAIN: 3251-L
 GAS: 2-122, 2-67, 2-109
 ELECTRIC: 208-1716, 210-1716
 CABLE TV: N/A
 TELEPHONE: N/A
 IMPROVEMENTS: N/A
 WATER GATE BOOK: F-19, F-20
 SEWER GATE BOOK: F-19, F-20
 100' SCALE: 208-1716, 210-1716
 THOMAS BROS.: 1268-J7
 RETIREMENTS:
 945' 10" CI PIPE INSTALLED 1928
 3 FH

SEWER AND WATER GROUP 639
HAWK STREET
 HORTON AVENUE TO UPAS STREET

CITY OF SAN DIEGO, CALIFORNIA
 ENGINEERING AND CAPITAL PROJECTS DEPARTMENT
 SHEET 16 OF 38 SHEETS


DATE	3-3-97	DATE	3-3-97
BY	GF/MC	APPROVED	DATE
DESCRIPTION	GF/MC	DATE	FILED
ORIGINAL	GF/MC	DATE	FILED

CONTRACTOR: 94 CAL. UNDERGROUND DATE STARTED: 1-04-97
 INSPECTOR: DWAYNE ARBELY DATE COMPLETED: 04-15-97

28028-16-D

AS-BUILT

FILMED FROM THE ORIGINAL. BEST QUALITY OBTAINABLE. EXCESSIVE GRAY BACKGROUND MAY CAUSE A POOR QUALITY REPRODUCTION.

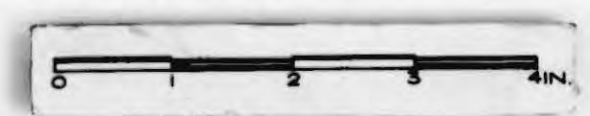

HAWK STREET