



30 TH STREET

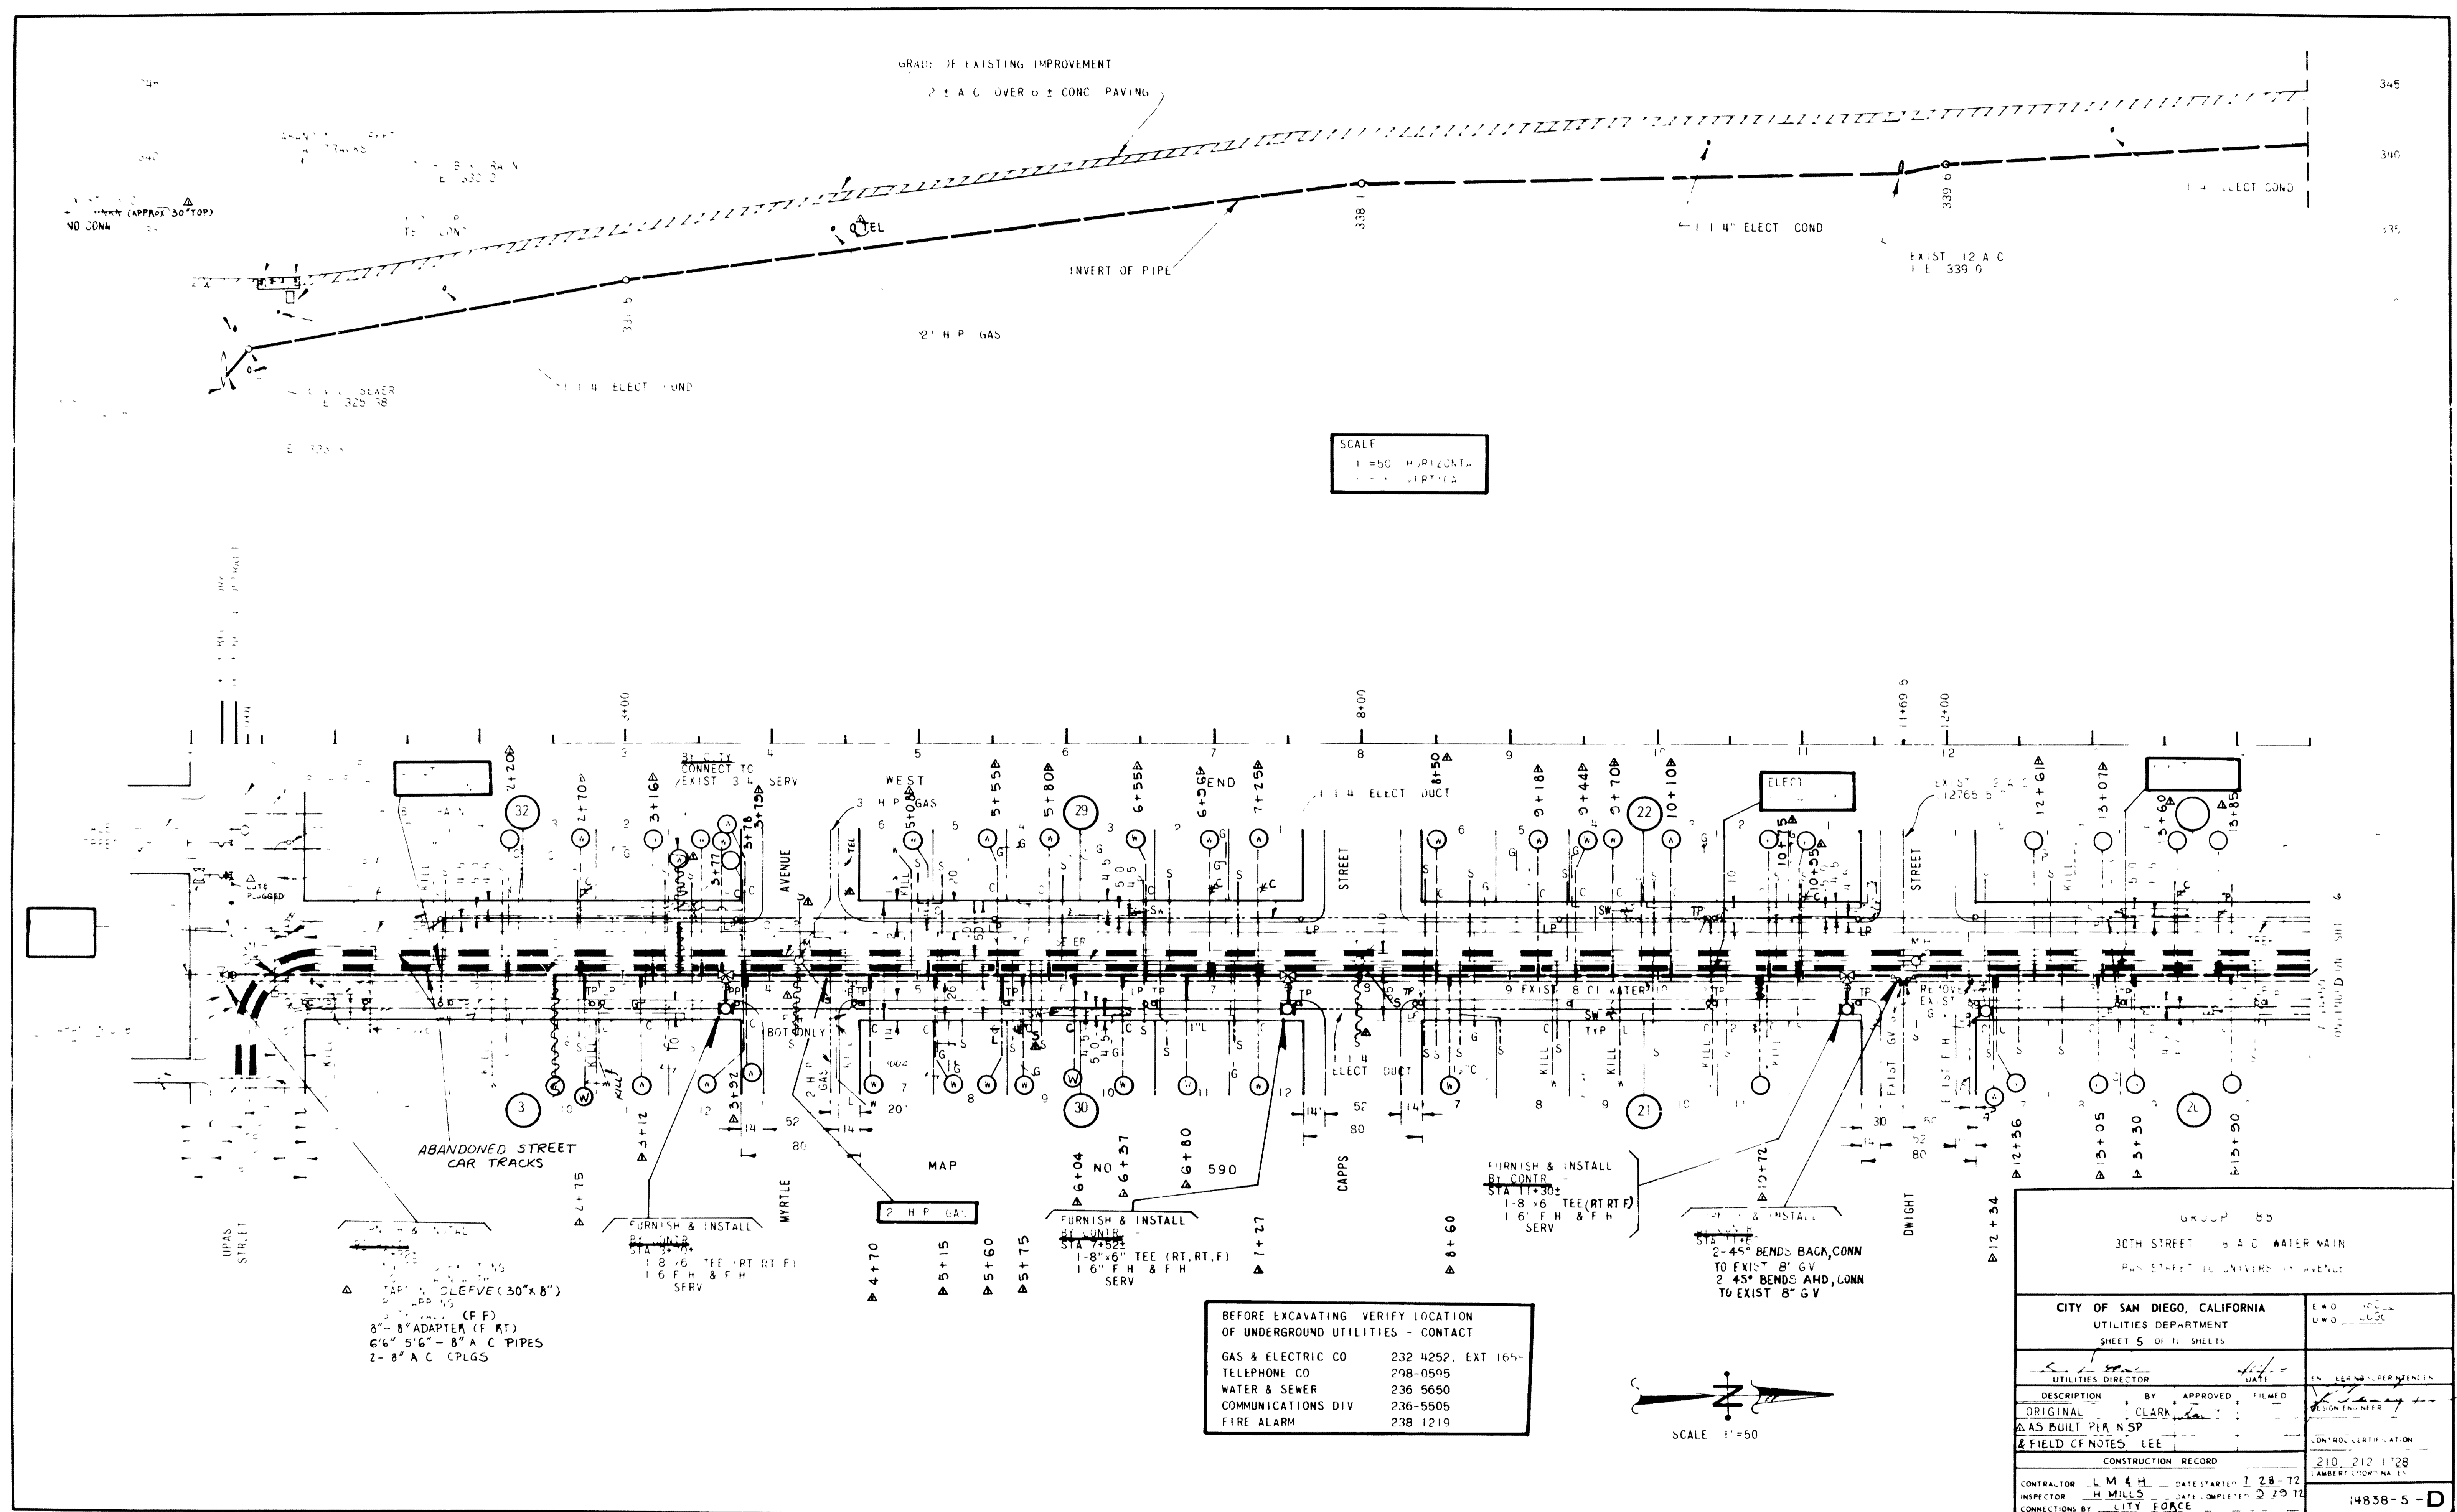

SCALE  
1" = 50' HORIZONTAL  
1" = 10' VERTICAL

BEFORE EXCAVATING VERIFY LOCATION OF UNDERGROUND UTILITIES - CONTACT  
 GAS & ELECTRIC CO 232 4252, EXT 165  
 TELEPHONE CO 298-0595  
 WATER & SEWER 236 5650  
 COMMUNICATIONS DIV 236-5505  
 FIRE ALARM 238 1219

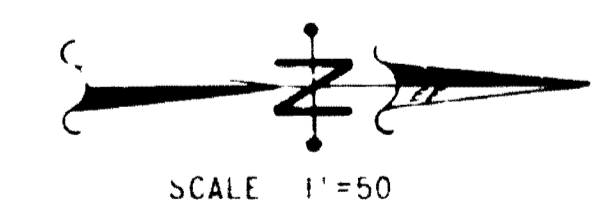

GROUP 85	
30TH STREET 5" A.C. WATER MAIN	
PLAN STREET TO UNIVERSITY AVENUE	
CITY OF SAN DIEGO, CALIFORNIA	DATE: 12-28-72
UTILITIES DEPARTMENT	BY: H. MILLS
SHEET 5 OF 11 SHEETS	IN FIELD PERMITS
UTILITIES DIRECTOR	DATE: 12-28-72
DESCRIPTION	BY APPROVED
ORIGINAL	CLARK
AS BUILT PIA N'SP	DESIGN ENGINEER
& FIELD CF NOTES LEE	CONTROL LOCATION
CONSTRUCTION RECORD	210 212 1728
CONTRACTOR L.M. & H. DATE STARTED 1-28-72	INSPECTOR H. MILLS DATE COMPLETED 2-29-72
CONNECTIONS BY CITY FORCE	14858-5-D

AS BUILT  
1-24-75