


REFERENCES  
 100' SCALE WATER & SEWER 208-1728  
 WATER 872-L 6444-L 10640-10-D 57C2-L  
 SEWER 19213-4-D  
 GAS BOOK 3 PAGES 237, 238  
 GATE BOOK H-20

FIELD NOTES WENTWORTH 208-1728 148163

BENCH MARK: (MEAN SEA LEVEL DATUM)  
 B M N.E.B.P THORN ST & GRANADA AVE  
 ELEV. 329.609

RETIREMENT:  
 1041-4" C.I. 1915  
 1-C-F.H. 1915

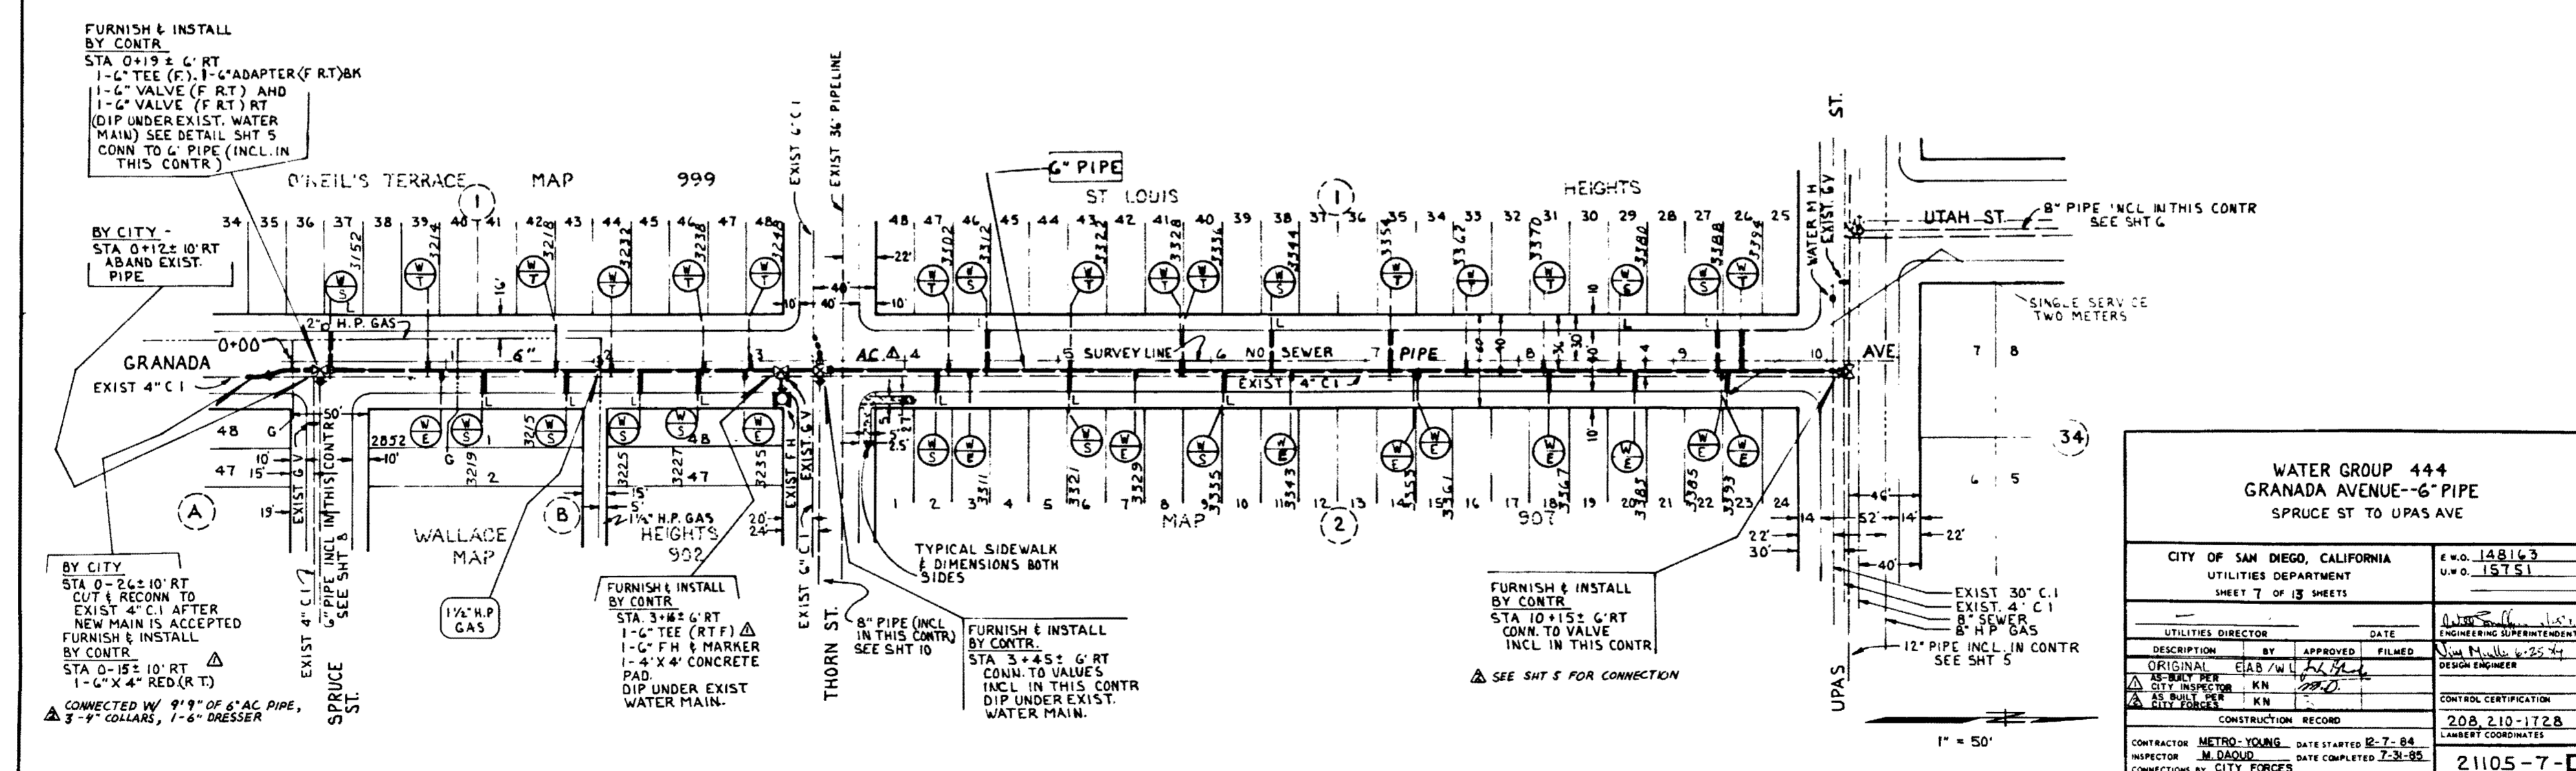

WATER GROUP 444 GRANADA AVENUE--6" PIPE SPRUCE ST TO UPAS AVE	
CITY OF SAN DIEGO, CALIFORNIA UTILITIES DEPARTMENT SHEET 7 OF 13 SHEETS	e.w. 148163 u.w. 15751
UTILITIES DIRECTOR	DATE
DESCRIPTION	BY APPROVED FILMED
ORIGINAL	EAB/WLL
AS BUILT PER	KN
CITY INSPECTOR	KN
AS BUILT PER	KN
CITY FORCES	KN
CONSTRUCTION RECORD	208, 210-1728
CONTRACTOR METRO-YOUNG DATE STARTED 8-7-84	INSPECTOR M. DAQUID DATE COMPLETED 7-31-85
CONNECTIONS BY CITY FORCES	21105-7-D

GRANADA AVE.

AS-BUILT

