

COORDINATE TABLE			
NO.	NORTHING	EASTING	DESCRIPTION
140	N247799.24	E1756287.20	8" TEE, FH ASSY.
141	N247813.57	E1755935.72	STA. 0+00
142	N247813.27	E1755965.72	INTERSECTION
143	N247802.94	E1755975.61	CUT & PLUG

PROPOSED PIPE DATA TABLE				
NO.	Δ/BEARING	RADIUS	LENGTH	REMARKS
1	N89° 15' 42" W	10'		CITY FORCES
2	N89° 15' 42" W	5.35'		8" CLASS 150

SCALE
1"=40' HORIZ.
1"=4' VERT.

NOTE:
TEXAS ST. SHALL BE HIGHLINED BY CITY FORCES PRIOR TO BEGINNING OF CONSTRUCTION. CITY TO FURNISH HIGHLINING MATERIAL AND MAKE ALL CONNECTIONS.

1 BY CITY FORCES
AHEAD OF CONTRACTOR STA. 0+40 ±, 11' RT. CUT & PLUG RECONNECT AFTER NEW MAIN HAS BEEN ACCEPTED

2 BY CITY FORCES
STA. 0+55 ±, 11' RT. REMOVE EXIST. 8" X 4" RED. AHEAD REMOVE EXIST. 4" VALVE AHEAD 15' FURNISH AND INSTALL 1" VALVE (M.J.M.) AHD. AFTER NEW MAIN HAS BEEN ACCEPTED CONNECT TO NEW 8" VALVE

3 BY CONTRACTOR
STA. 3+50 ±, 11' RT. FURNISH & INSTALL 1" 8" X 6" TEE (M.J., F.F.) 1" FH ASSEMBLY (STD. W-10) 1" 8" VALVE AHEAD (F, M.J.)

4 BY CONTRACTOR
STA. 4+14 ±, 11' RT. REMOVE EXIST. VALVE

REFERENCE:

BENCH MARK: SWBP PARK BLVD. & UNIVERSITY AVE. EL. = 321.89' MSL
FIELD NOTES: HOLT 12-21-90, 208-1725, WO 181651
WATER: 14432-9-D, 14432-10-D
SEWER:
STORM DRAIN: 21525-1-D
GAS: 11-338, 11-391, 11-270, 11-283 11-323
TELEPHONE:
WATER GATE BOOK: H-19
SEWER GATE BOOK: H-19
100' SCALE: 210-1722, 210-1725
THOMAS BROS.: 60, D, E-4

RETIREMENT:

545' OF EX. 6" CL. YR. FB. 1992


**WATER AND SEWER GROUP 510
LEAD SERVICE REPLACEMENT
TEXAS STREET
UPAS ST. TO STA. 6+00**

CITY OF SAN DIEGO, CALIFORNIA
UTILITIES DEPARTMENT
SHEET 13 OF 63 SHEETS

UTILITIES DIRECTOR	DATE	7-22-92	WATER #01	181651
SEWER #02	DATE		SEWER #03	172561
DESCRIPTION	BY	APPROVED	DATE	FILED
ORIGINAL	RJS/dsb	10/1/91	7/29/92	DEC. 2, 1992
AS-BUILT	FM		4-9-94	

CONTRACTOR: DELINGRUB... DATE STARTED: 5-21-91
INSPECTOR: CARLEN GRANHAM DATE COMPLETED: 12-21-91

26328-13-D

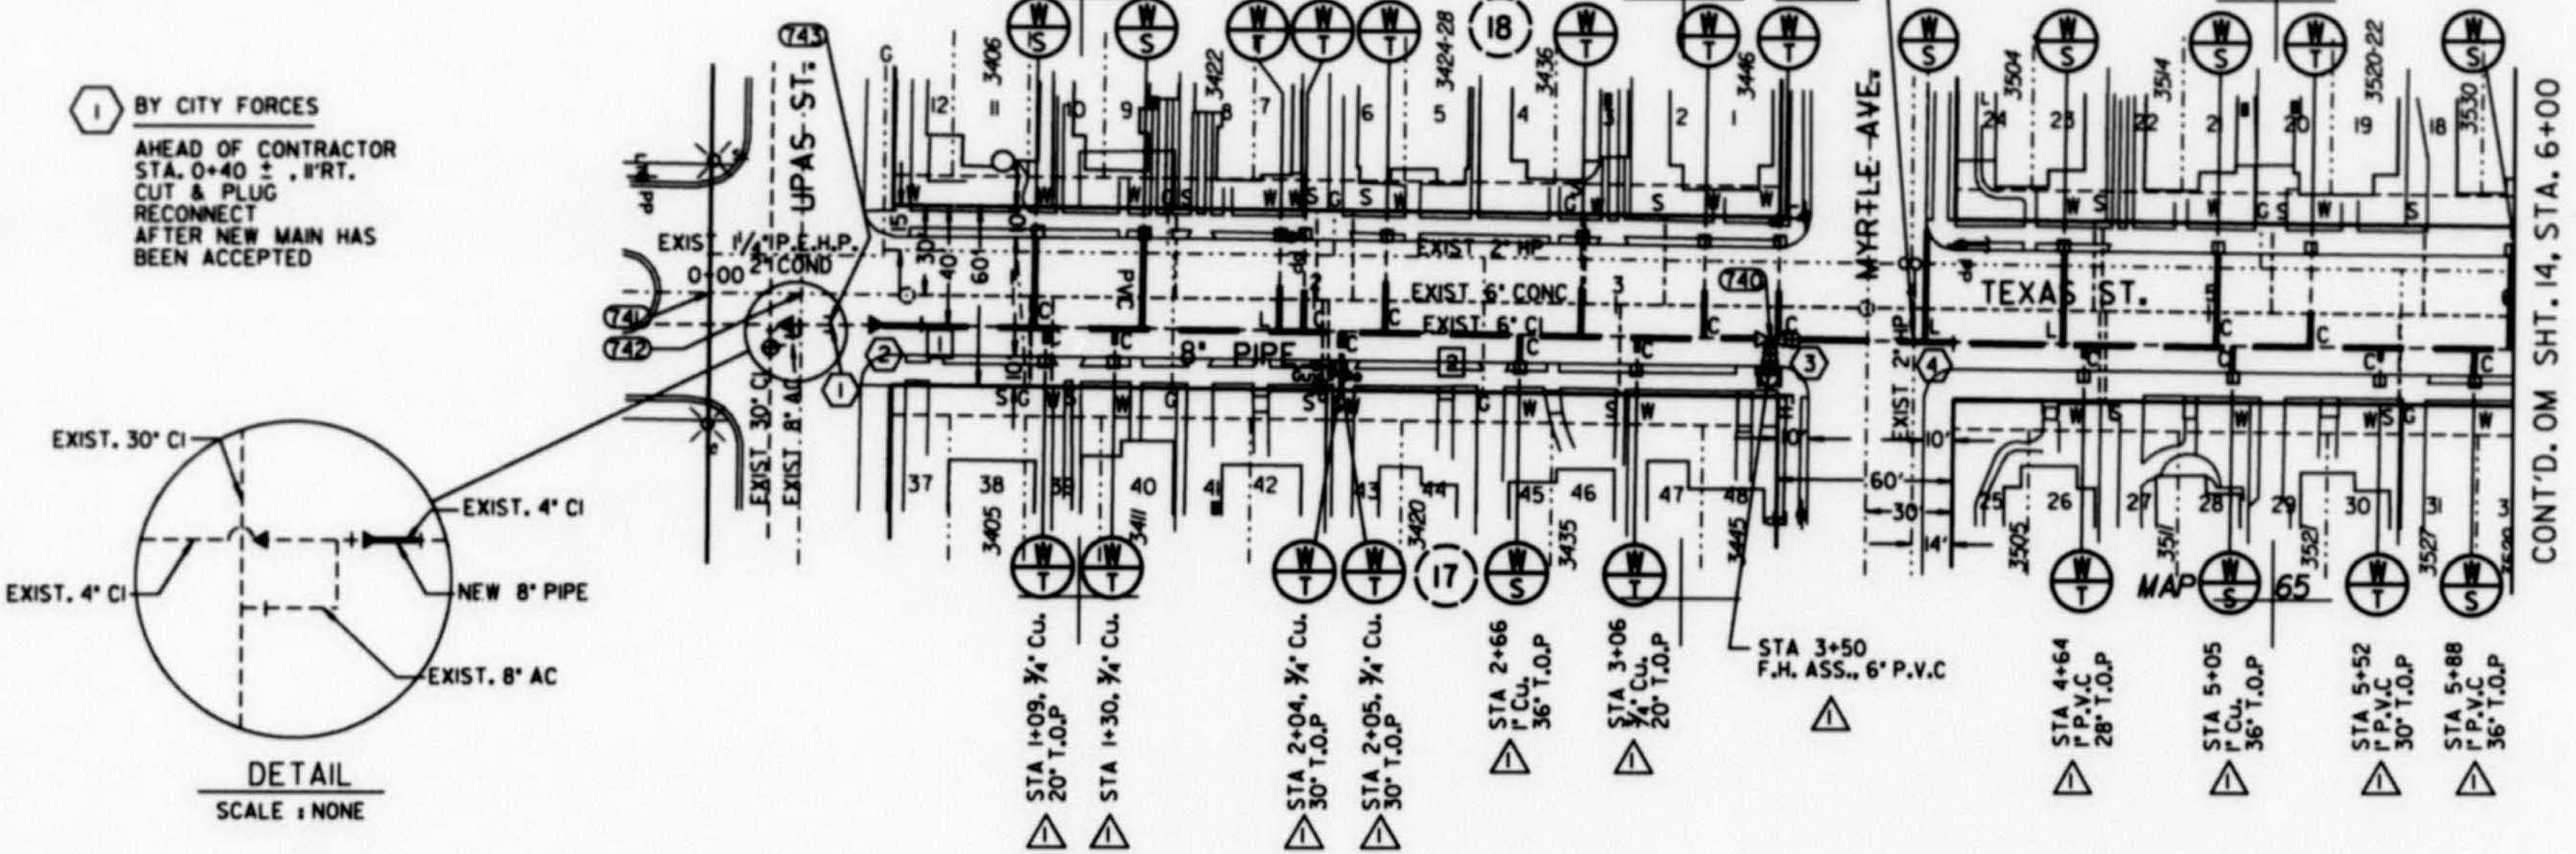

TEXAS STREET

AS-BUILT

FILMED FROM THE ORIGINAL, BEST QUALITY OBTAINABLE, EXCESSIVE GRAY BACKGROUND MAY CAUSE A POOR QUALITY REPRODUCTION

