

- ### WORK TO BE DONE
- THE IMPROVEMENT CONSISTS OF THE FOLLOWING WORK TO BE DONE ACCORDING TO THESE PLANS AND THE SPECIFICATIONS OF THE CITY OF SAN DIEGO.
 - THE GRADING OF THE PORTIONS OF THE STREETS SHOWN HATCHED THIS:
 - THE PREPARATION OF THE SUBGRADE AND THE PAVING OF THE PORTIONS OF THE STREET SHOWN THIS:
 - THE CONSTRUCTION OF TYPE "G" CURB AS SHOWN THIS:
 - THE CONSTRUCTION OF CUTOFF WALL PER 24-EB AS SHOWN.
 - THE CONSTRUCTION OF CONCRETE ENCASMENT SHOWN THIS:
 - THE CONSTRUCTION OF 18" R.C.P. CULVERT AS SHOWN THIS:
 - THE CONSTRUCTION OF CONCRETE SENIOR MANHOLES AS SHOWN ON THE PLAN.
 - THE CONSTRUCTION OF STORM DRAIN CLEANOUT SHOWN THIS:
 - THE CONSTRUCTION OF 6" GATE VALVES & BOXES SHOWN THIS:
 - THE CONSTRUCTION OF GRAVITY TYPE HEADWALL AS SHOWN.
 - THE CONSTRUCTION OF 6" A.C. WATER MAIN SHOWN THIS:
 - THE CONSTRUCTION OF CONCRETE SENIOR MANHOLES SHOWN THIS:
 - THE CONSTRUCTION OF FIRE HYDRANT SERVICE SHOWN THIS:
 - THE CONSTRUCTION OF 8" V.E. SEWER MAIN SHOWN THIS:
 - THE CONSTRUCTION OF TYPE "D" CLEANOUT SHOWN THIS:
 - THE CONSTRUCTION OF CONCRETE GRADE SHOWN THIS:


STANDARD DRAWINGS

1-E-D, 9-EB, 21-EB, 27-EB, 30-EB, 31-EB, 50-EB, 70-EB, 24-EB, 21-EB, 12-4-EB, 24-EB, 31-EB, 32-EB, 300-EB, 101-EB, 107-EB, 100-EB, 22-WB, 250-WB, 261-WB, 266-WB, 553-EB.

NOTE: NO PAVEMENT SHALL BE PLACED BEFORE GAS MAINS & SERVICES ARE INSTALLED.

STANDARD SPECIFICATIONS

STANDARD SPECIFICATIONS, PART I FILED APRIL 9, 1958, INCLUDING AMENDMENT FILED APRIL 8, 1959, PART V FILED MAY 9, 1958. GENERAL CONDITIONS FOR PRIME CONTRACT WORK.

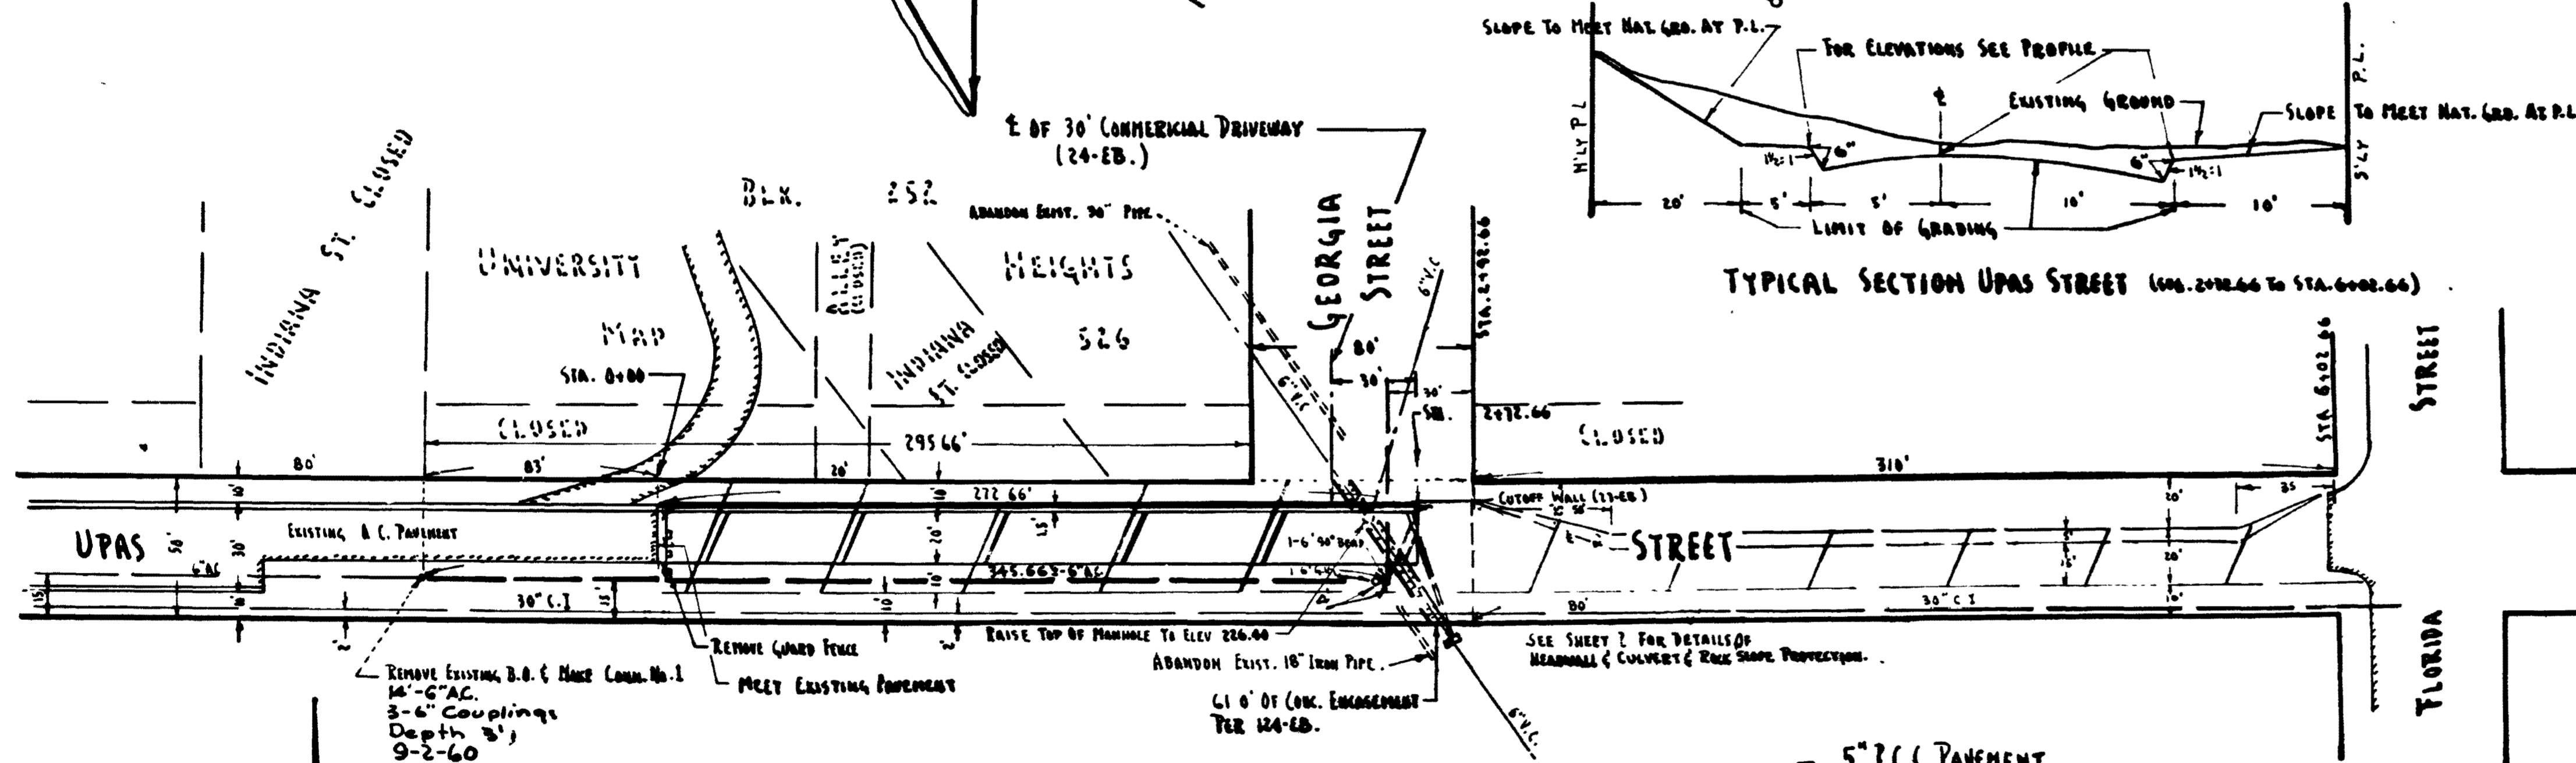

WATER DEPARTMENT NOTES

THE CONNECTIONS TO ALL EXISTING WATER MAINS WILL BE MADE BY THE CITY OF SAN DIEGO WATER DEPARTMENT. CHARGES WILL BE COLLECTED ONLY ON CONNECTIONS ACTUALLY MADE. WHERE NO CONNECTION IS MADE, THE CONTRACTOR SHALL INSTALL A BLOWOFF AT THE SITE AS SHOWN ON THE PLANS. ANY CONNECTION NOT SHOWN WILL BE MADE AT PERMANENT EXPENSE AS OF THIS DATE. THE COSTS OF CONNECTIONS SHOWN ON THESE PLANS ARE AS FOLLOWS:

(CONNECTION NO. 1) \$157.00
 (CONNECTION NO. 2) \$157.00


CITY FORCES WILL EXCAVATE, BACKFILL, & FURNISH AND INSTALL ALL MATERIAL EXCEPT PAVING, THE APPROXIMATE TEN (10) FEET ADJACENT TO THE POINT OF CONNECTION TO EACH EXISTING MAIN.

THE CONTRACTOR SHALL EXCAVATE AT THE LOCATION OF EACH REQUIRED CONNECTION TO AN EXISTING MAIN TO DETERMINE THE ELEVATION AND LOCATION OF THE MAIN AT THE CONNECTION. IMMEDIATELY AFTER SUCH DETERMINATION HAS BEEN MADE, THE ABOVE EXPLORATORY EXCAVATION SHALL BE BACKFILLED IN ACCORDANCE WITH CITY STANDARD SPECIFICATIONS. (WHERE REQUIRED BY ENGINEER.)

ALL PIPE LINE WORK BY CONTRACTOR SHALL TERMINATE APPROXIMATELY TEN (10) FEET FROM POINTS OF CONNECTIONS TO THE EXISTING WATER MAINS AND NO EXCAVATION SHALL BE MADE WITHIN THE AFORESAID TEN (10) FEET EXCEPT THE ABOVE EXPLORATORY EXCAVATION.

CONSTRUCTION APPROVAL
 Date Fee Paid: 6-2-60 Permit No. 114,279
 Approved for Construction By: *[Signature]*

PRIVATE CONTRACT
 ENGINEER OF WORK: *[Signature]* RE. 8629

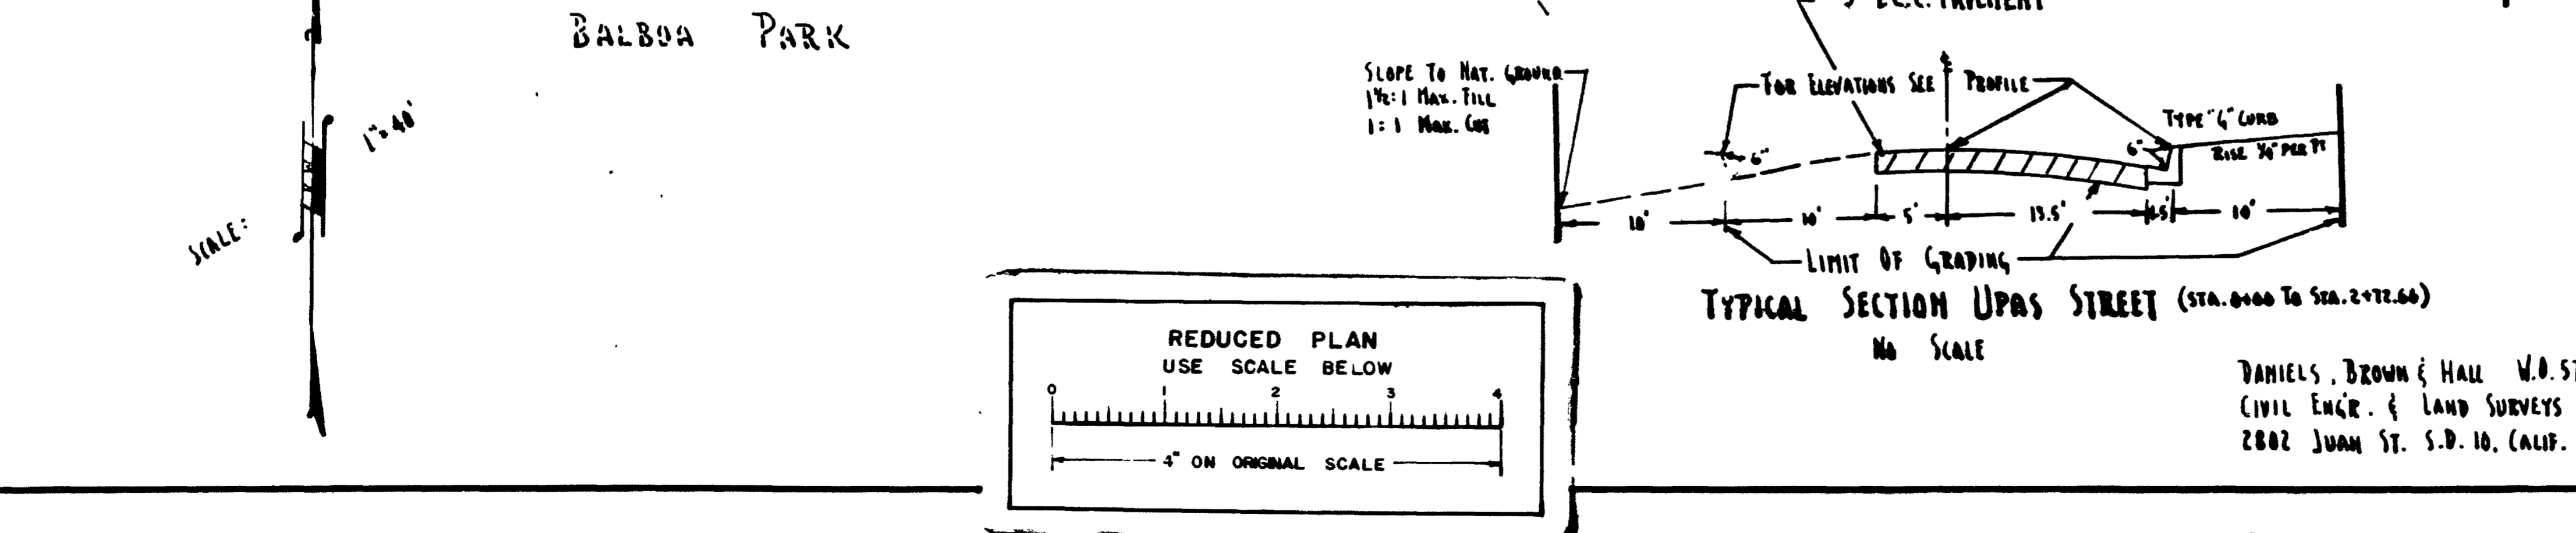

PLAN FOR THE IMPROVEMENT OF
 UPAS STREET
 GEORGIA STREET - W'LY.

IN 279

CITY OF SAN DIEGO ENGINEERING DEPARTMENT			SHEET 1 OF 2 SHEETS		NO 20845
CHANGE	BY	DATE	APPROVAL	DATE	APPROVAL
As Built	D.S.	4/5/60	<i>[Signature]</i>	4/5/60	<i>[Signature]</i>
CONSTRUCTION RECORD			APPROVALS FOR		
DATE STARTED	DATE COMPLETED	CONTRACTOR	WATER DEPT.	SEWERAGE DEPT.	CITY ENGINEER
6/12/60	1/12/61	Hodgins	<i>[Signature]</i>	<i>[Signature]</i>	<i>[Signature]</i>
CONTR. ENGINEER	INSPECTION	TRAFFIC	ELECTRICAL	HIGHWAY	CHECKED
Hodgins	Boyd	F.D. Egan	STRUCTURAL	GRADES	V.W.
FIELD BOOK	H-19	CONTROL	DESIGNED		9026-D

DANIELS, BROWN & HALL W.O. 5769
 CIVIL ENGR. & LAND SURVEYS
 2802 JUAN ST. S.D. 10, CALIF. CP-6483

INDEXED MICROFILMED
 APR 1960 APR -- 1963