
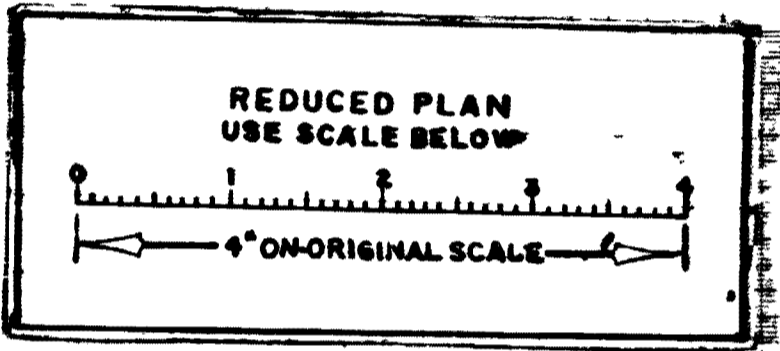



CONTRACTOR: SCHAFER & STOWERS
CONSTRUCTED: APRIL 6, 1958
PIPE: 6" ASBESTOS CEMENT CLASS
150-FURNISHED BY CONTR.
VALVES & FITTINGS: " " " "
TEST PRESSURE 225 p. s. i.
WORK DONE BY CONTR. ON V.O. 13694
" " CITY " " 13695

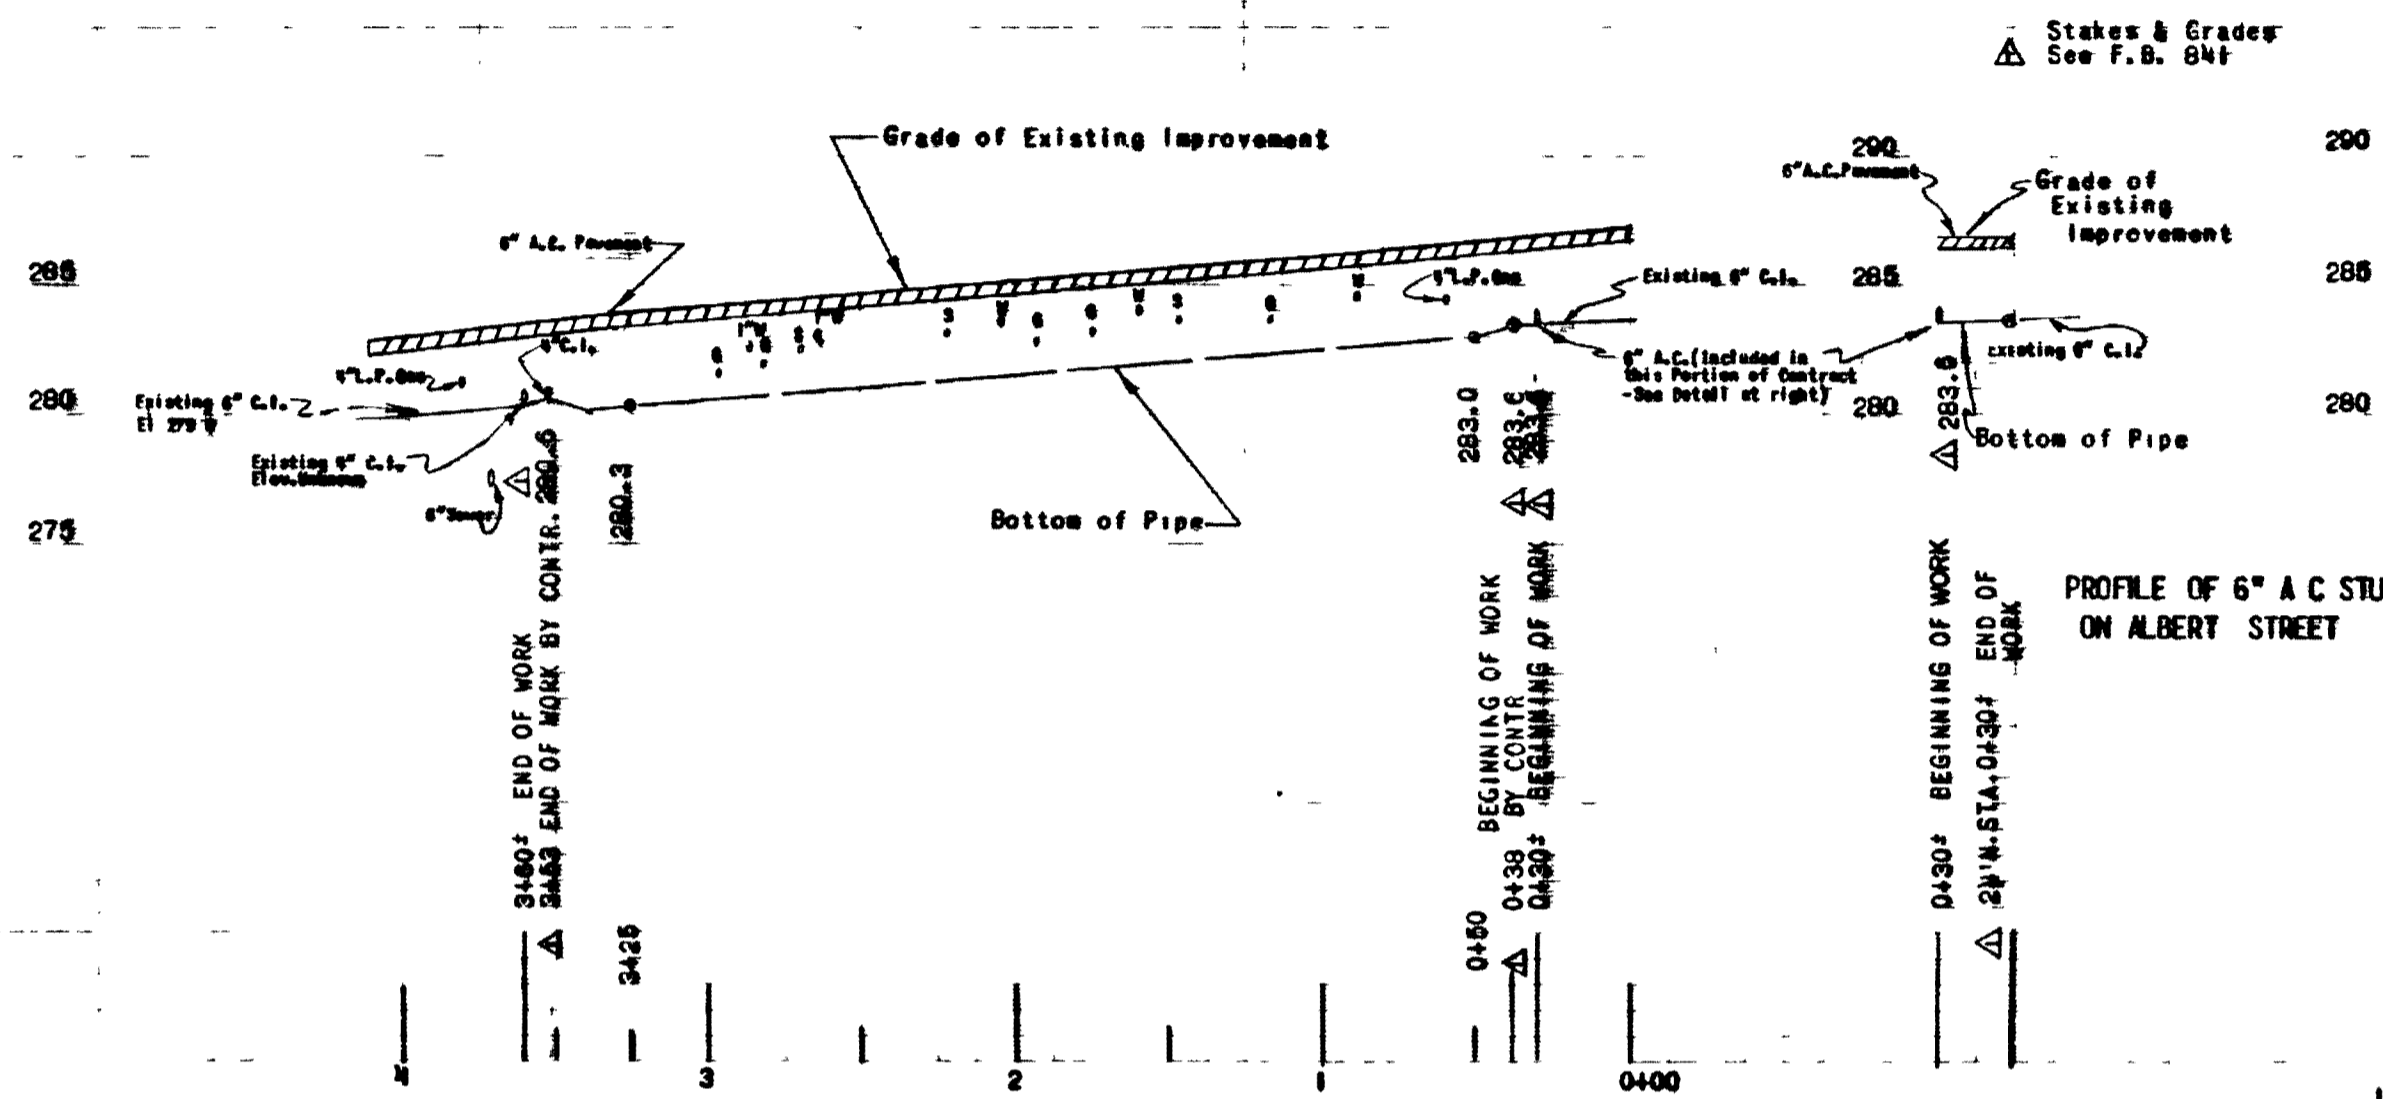

LEGEND

	Proposed water main
	Proposed gate valve
	Existing water main & G.V.
	Fire hydrant assembly
	Water service lateral
	Pavement
	Gas main
	Sewer main & manhole
	Proposed tee & cross
	Existing tee & cross

T. J. HIGGINS ADDITION ON MAP NO 242

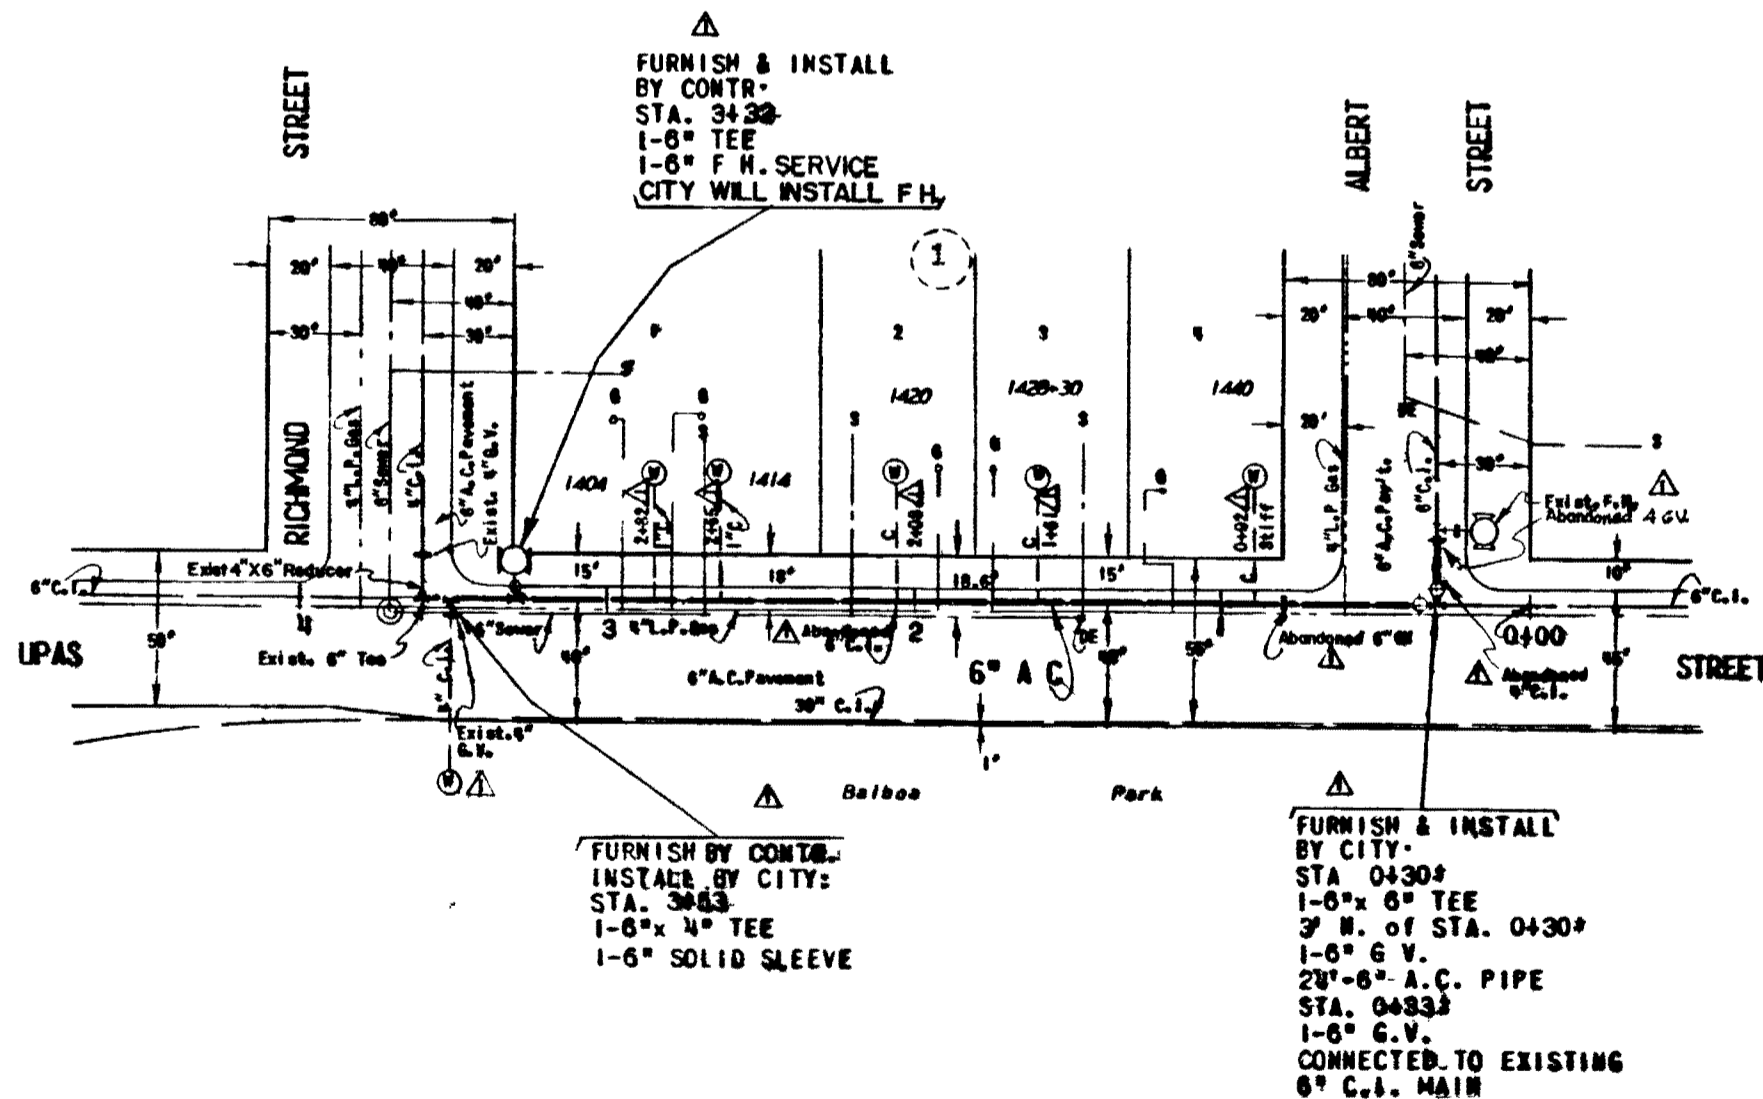

FURNISH & INSTALL BY CONTR. STA. 3430
1-6" TEE
1-6" F.H. SERVICE
CITY WILL INSTALL F.H.

FURNISH BY CONTR. INSTALL BY CITY: STA. 3463
1-6"x 4" TEE
1-6" SOLID SLEEVE

FURNISH & INSTALL BY CITY: STA. 0430
1-6"x 6" TEE
3' W. OF STA. 0430
1-6" G.V.
28'-6" A.C. PIPE
STA. 0433
1-6" G.V.
CONNECTED TO EXISTING 6" C.I. MAIN

Ref Dwg.
Water Plat Bk. 4, Sht. 232
Sewer Bk. 4, Sht. 232
Gas Bk. 2, Sht. 199, 198
Date Bk. Pg. A-43
2414-L, 2415-L, 2416-L

OFFICE CHECK	INITIAL	DATE
County Surveyor		
Calverts & Drains	REC	9-8-55
S.D. Gas & Electric Co.	GRW	8-28-55
Sewers	GRW	9-18-55
State Highway		
Street Grades	UTJ	9-8-55
Telephone Co.	WLL	9-30-55
Water Distribution	WLL	11/18/55
Public Works	RW	8-23-55
Field (City Engr.)	S. Anderson	9/8/55

SPEC NO 130

CITY OF SAN DIEGO CALIFORNIA WATER DEPARTMENT			
CAST IRON WATER MAIN REPLACEMENTS, 195-5			
UPAS STREET 6" A.C. MAIN			
ALBERT STREET TO RICHMOND STREET			
RECOMMENDED: J. Gray		APPROVED: W. Beermann	
ENGINEER		DIRECTOR	
DATE: June 1, 1955		DATUM City	
DRAWN: J. Gray	TRACED:	CHECKED:	
P. S. None	SCALE: 1" = 50' Horizontal 1" = 6' Vertical		
GROUP 101	SHEET 1 OF 1 SHEETS	DWG NO 6917-W	
AS BUILT		CROFILMED	

JAN 24 1964