


RICHMOND STREET

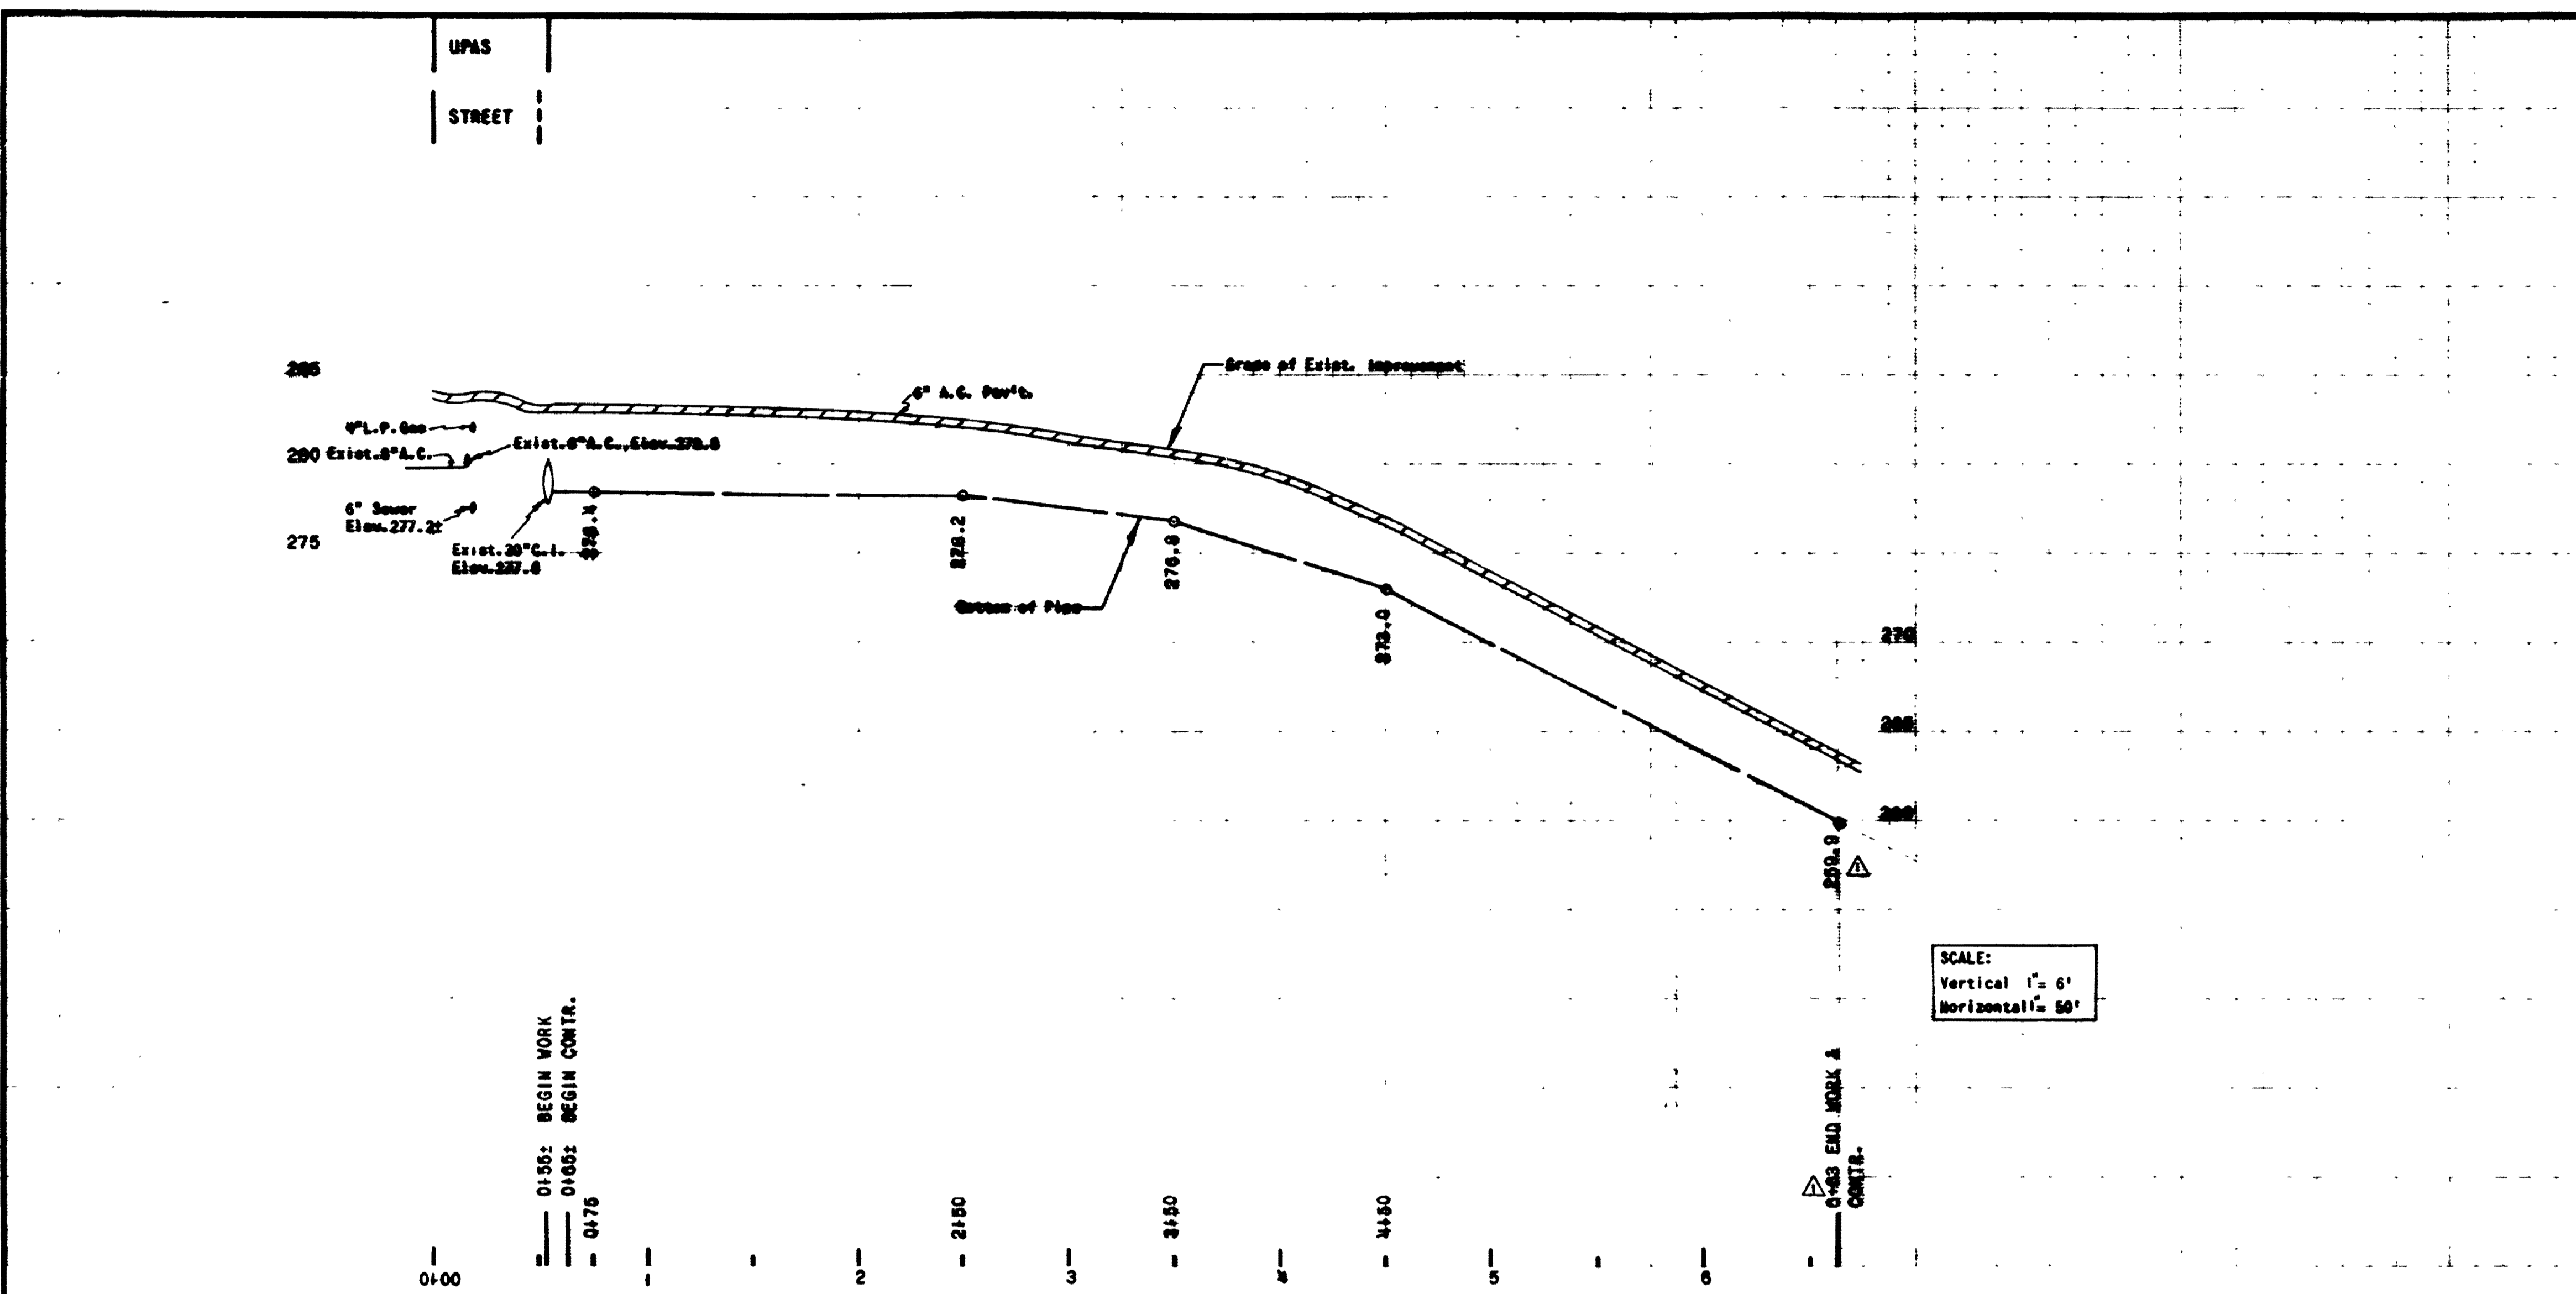

SCALE:
Vertical 1" = 6'
Horizontal 1" = 50'

0+55: BEGIN WORK
0+85: BEGIN CONTR.
0+75

THEODORE ROOSEVELT
JUNIOR HIGH SCHOOL

TRAFFIC NOTE:- MAINTAIN
TWO LANES OF TRAFFIC AT ALL
TIMES.


NOTE:
Extended main to 76' to provide water for
future service to Park Dept. main which has
already been installed to meet 8" service
@ Sta. 0+56.

AS BUILT DATA
CONSTRUCTED BY: R.M. & S. ENGR. CONTR.
W.O. 20004 (CONSTR.), W.O. 48205 (EMGR.)
PIPE: (kind) K.M. "PLUID TITE"
GATE VALVES: RICH (kind)
SOIL: (kind) GRANULAR W/2" ROCK
STAKED: (date) 8/3/62
TESTED: (date) 8/31/62
BACKFILL: (kind) SELECT MATERIAL
NOTE: include "CONSTRUCTION RECORD".
CONNECTIONS BY:- CITY FORCE,
W.O. 20005
PIPE: A.C.
GATE VALVE: MUELLER

BENCH MARKS (City Datum)
TM - Top F.N. N.E. Cor. Upas St.
& Richmond St.
Elev. 287.31
BM - S.E. S.P. Myrtle Ave. & Richmond
St.
Elev. 280.04

REFERENCES:
Water Rk. #3, Sht. 9-19-C
Sewer Rk. #1, Sht. 225 & 232
Gas Rk. #2, Sht. 197 & 198
Gate Rk. Sht. 4-43
2415: Pav. on Upas St.
5767-L 30" C.I. in Upas St.
6017-W 6" A.C. in Upas St.
5340-L Pav. on Richmond St. Upas St.
Field Notes W.O. 48205


RETIREMENT:
None

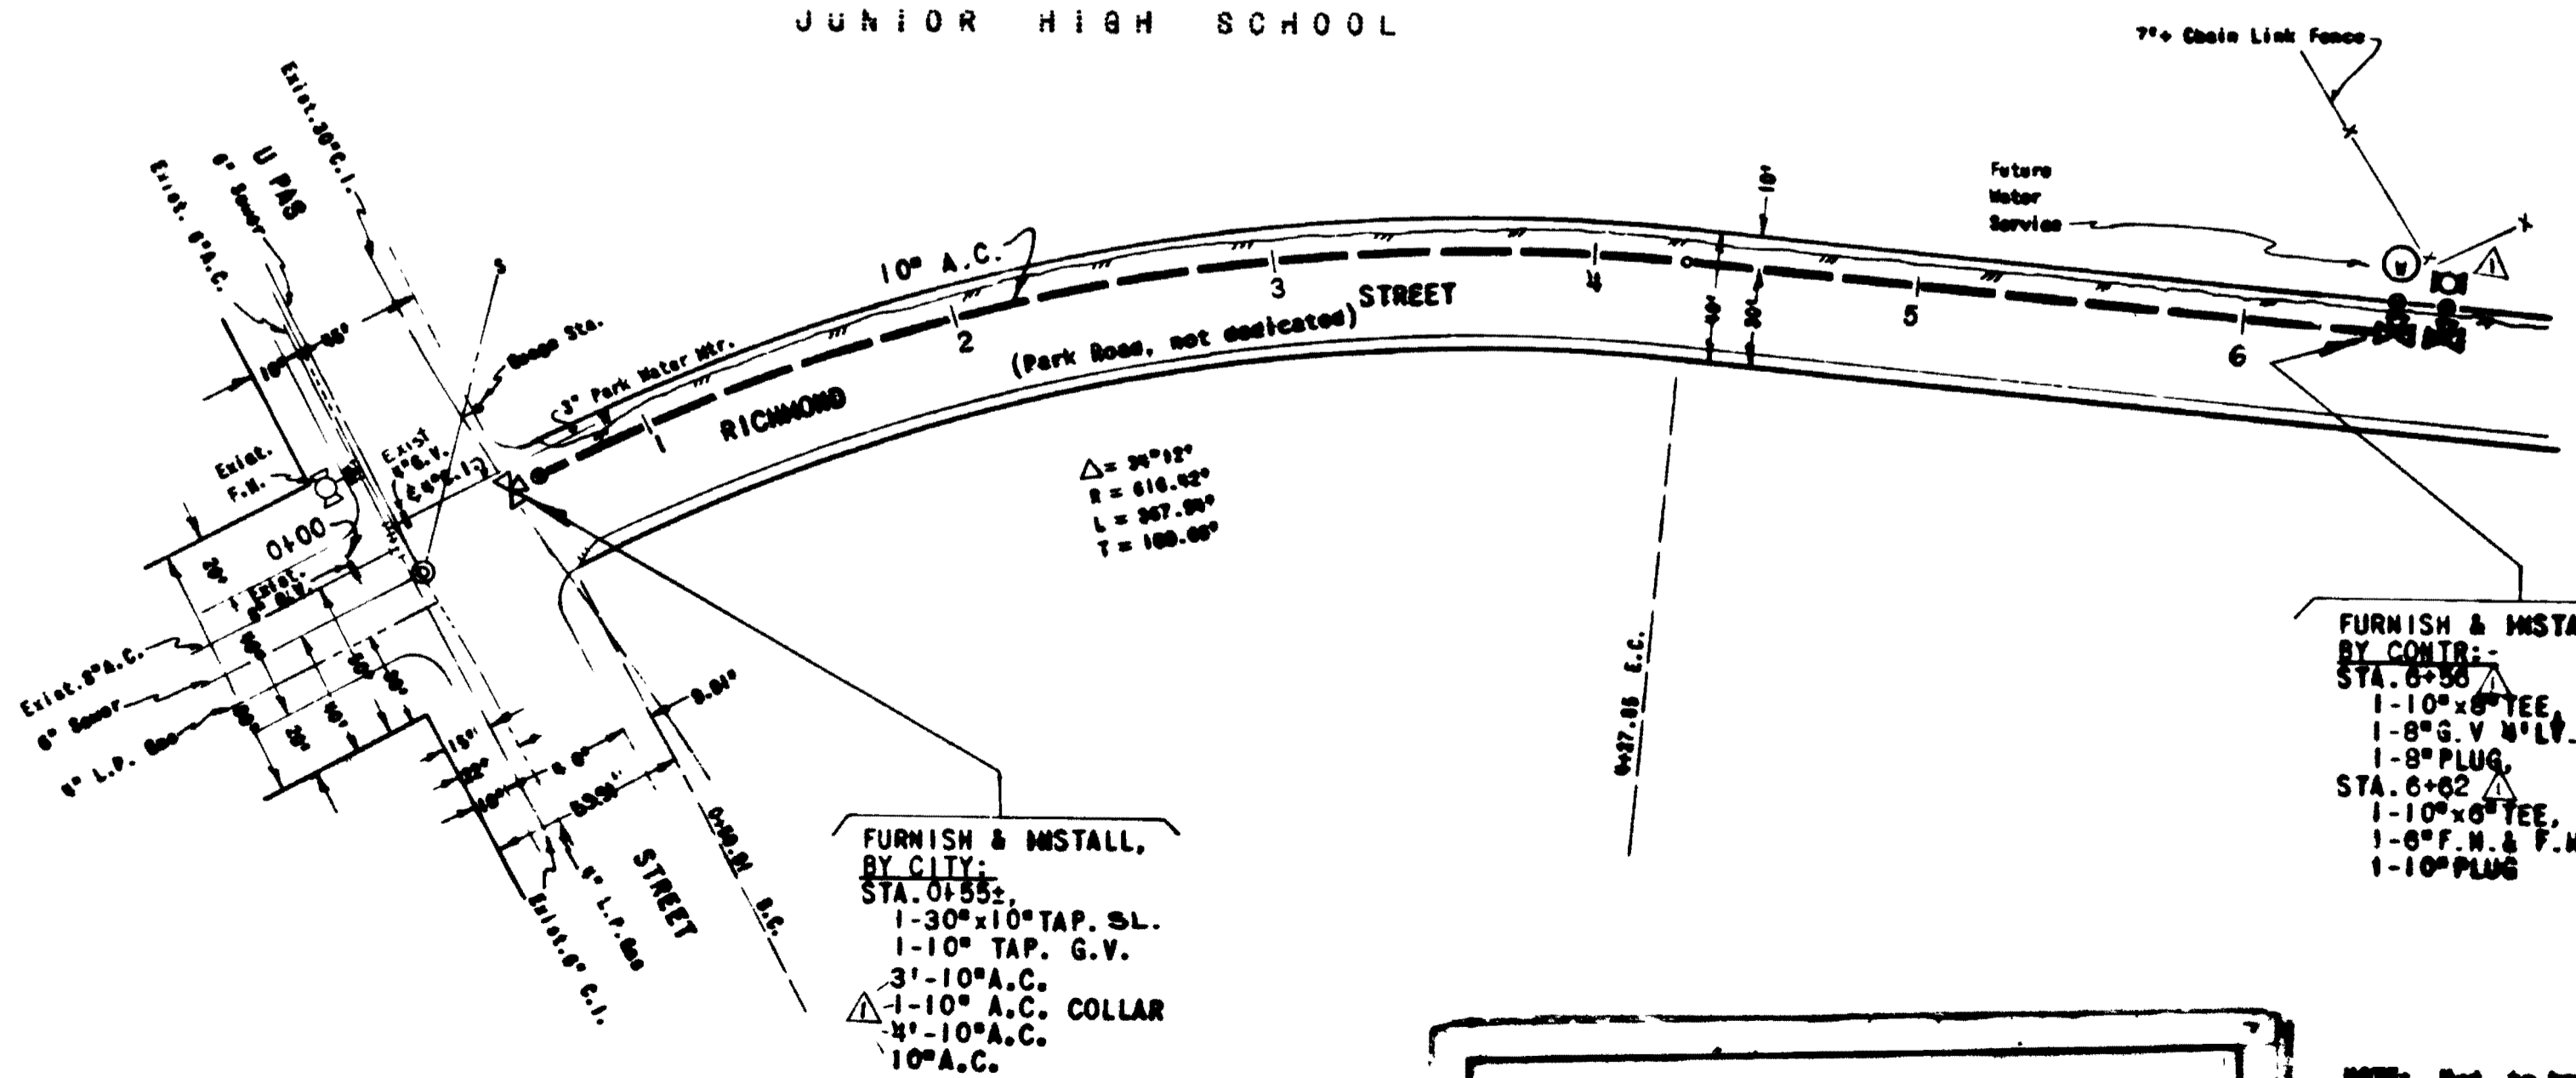

**FURNISH & INSTALL,
BY CITY:**
STA. 0+55:
1-30"x10" TAP, S.L.
1-10" TAP, G.V.
3"-10" A.C.
1-10" A.C. COLLAR
1"-10" A.C.
10" A.C.

**FURNISH & INSTALL,
BY CONTR.:**
STA. 0+56:
1-10"x6" TEE
1-6" N. & W. L.V., SHACKLE TO TEE
1-6" PLUG
STA. 0+52:
1-10"x6" TEE
1-6" F.N. & F.N. SERVICE,
1-10" PLUG

NOTE: Spd. to have 1-3/4" and 1-0" Port

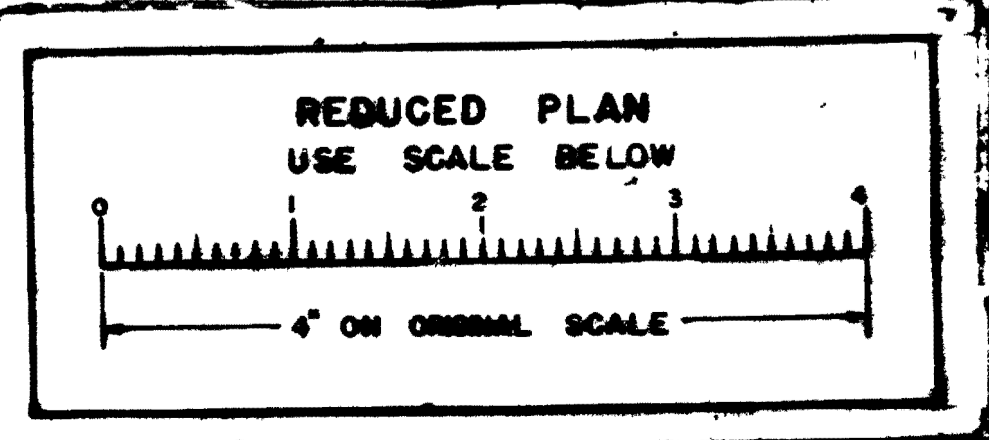

SCALE: 1" = 50'

RICHMOND STREET GROUP 228		10" A.C. MAIN		ENGINEERING W.O. 48205	
UPAS STREET TO 605' SOUTH					
CITY OF SAN DIEGO ENGINEERING DEPARTMENT SHEET 6 OF 9 SHEETS					
PLAN REVISION		APPROVAL		DATE	
AS BUILT AS PER I&E P.P. 6-25-62	BY	DATE	APPROVAL	DATE	
CITY ENGINEER & FIELD				4/11/62	
CONSTRUCTION RECORD		APPROVALS FOR		DATE	
9-29-62	9-10-62	WATER DEPT.	SEWERAGE DEPT.	PLANNING DEPT.	HIGHWAY DEPT.
BY STAFF	DATE COMPLETED	STRUCTURAL	GRADES	ELECTRICAL	UTILITIES
CONTR. R.M. & S. ENGR. CONTR.	EMP. MARTELL	TRAFFIC	CONTROL		
NOTES: 6-19-C, 6-20-3					
-19-C & 6-20-3		MICROFILMED		10,561-6-D	

AS BUILT

JUN 4 1963