


SCALE:-  
 1"=50' HORIZONTAL  
 1"= 6' VERTICAL

FURNISH & INSTALL  
 BY CITY:-  
 STA. 0+60+  
 CONN. TO EXIST.  
 4" G.V.

1- NIPPLE 4" A.C.  
 BET. RED. & G.V.  
 6" 6"-8" A.C.  
 1-8" COUPLING

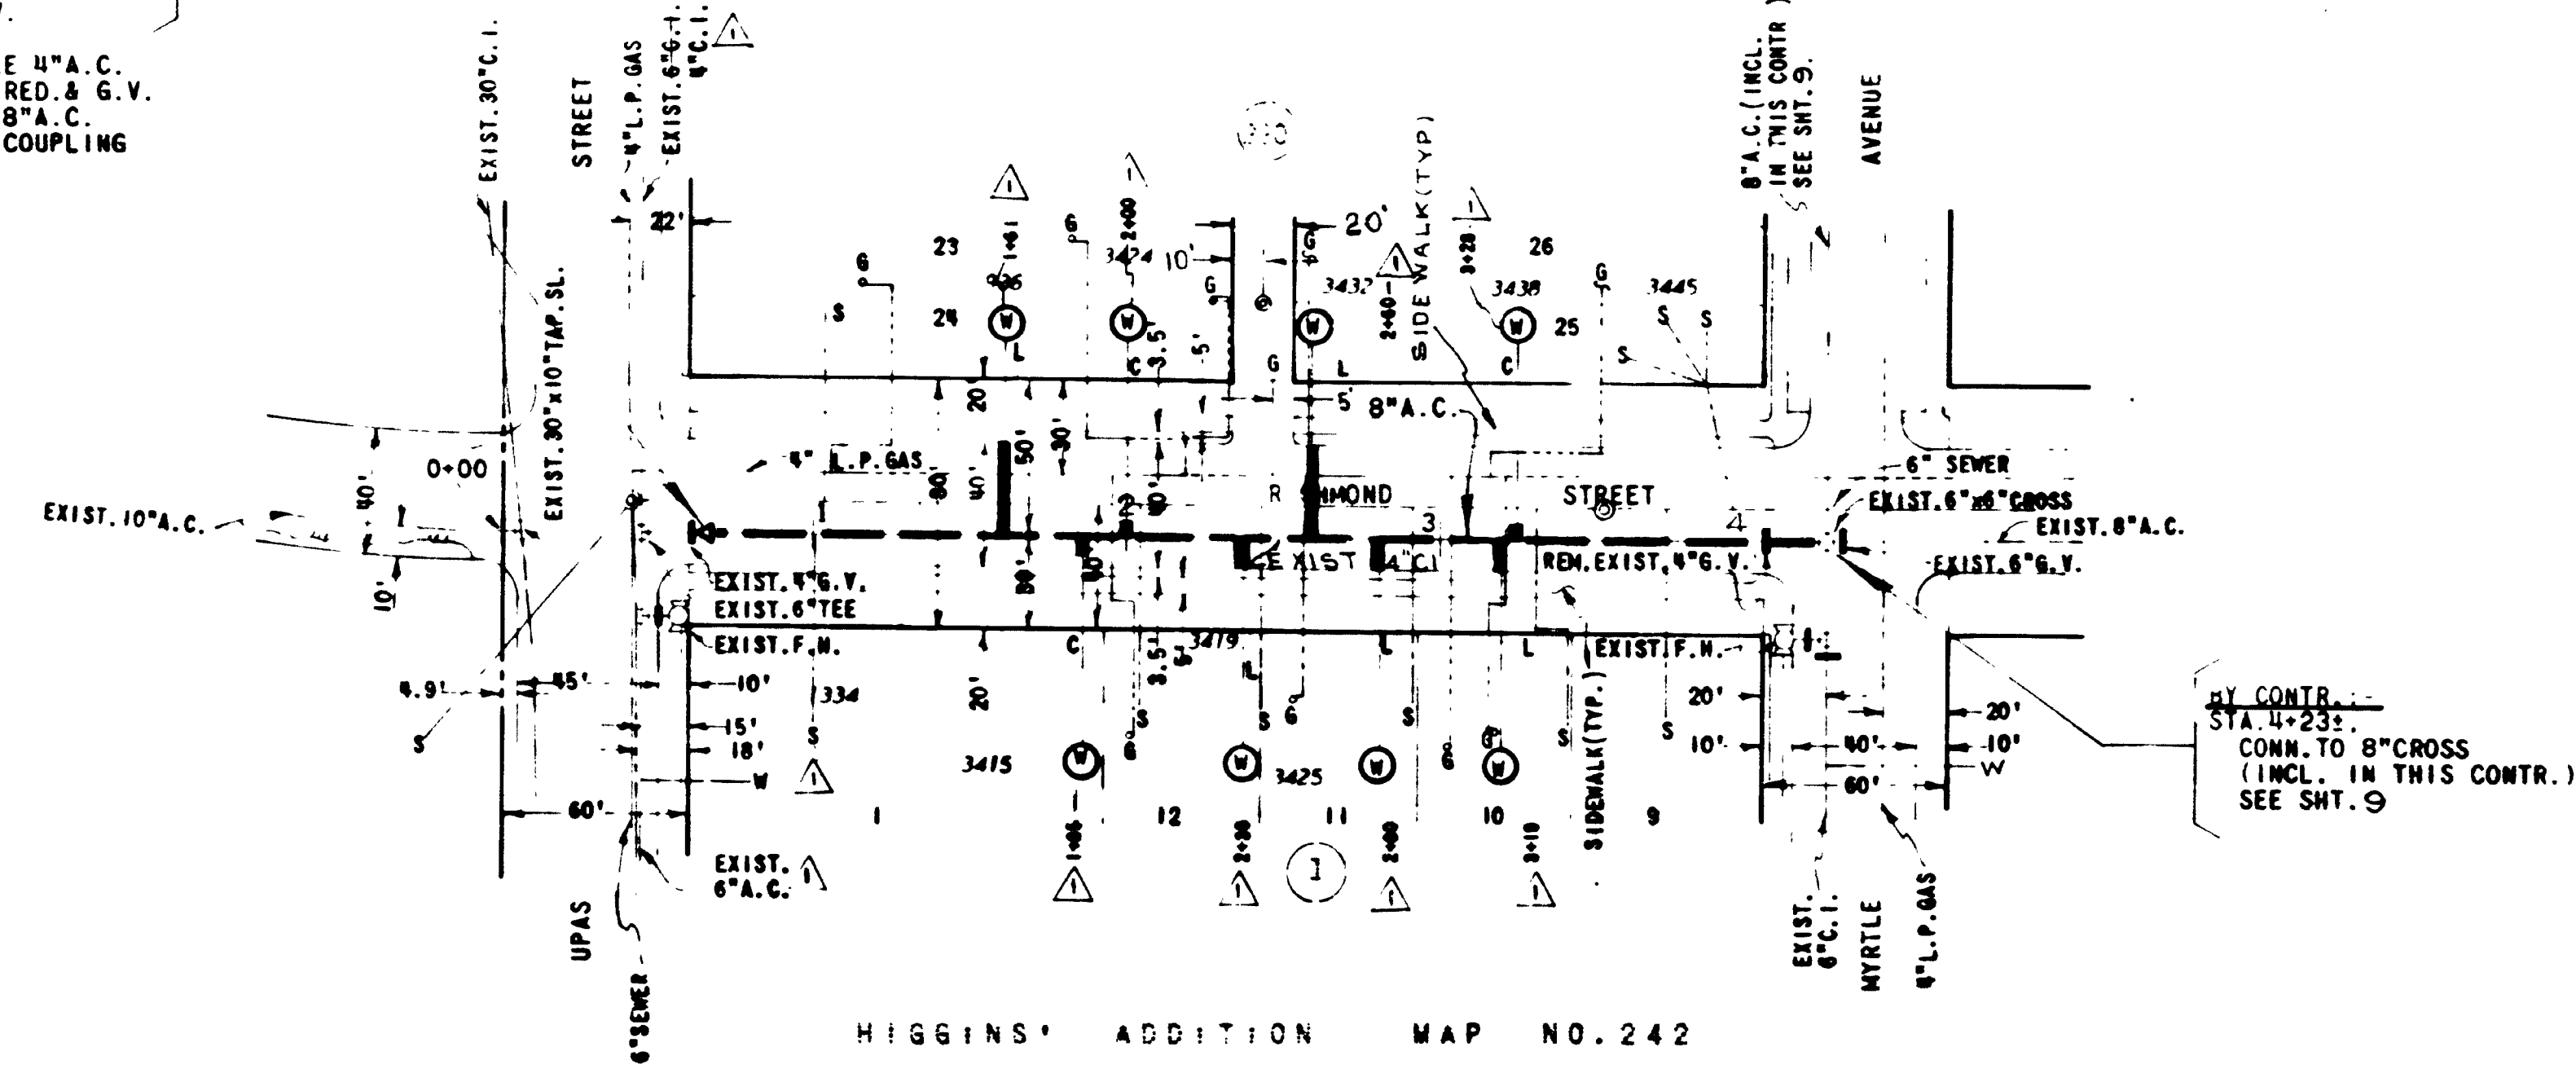

AS BUILT DATA

CONSTRUCTED BY:- LONG, MARKER & HOWLEY CONST.CO.  
 W.O. 19045 (CONSTR.), W.O. 48397 (ENGR.),  
 PIPE: JOWNS-MANVILLE "RING-TITE"  
 (Kind)  
 GATE VALVES: NONE  
 (Kind)  
 SOIL: REP. CONGLOMERATE  
 (Kind)  
 STAKED: 12/14/66  
 (Date)  
 TESTED: 2/6/67  
 (Date)  
 BACKFILL: - IMPORT  
 (Kind)  
 Note: include "CONSTRUCTION RECORD".  
 CONNECTIONS BY:- CITY FORCE,  
 W.O. 19045  
 PIPE: 8" A.C. & 6" A.C.  
 GATE VALVES: NONE

BENCH MARK:- (MEAN SEA LEVEL DATUM)  
 B.M. - N.W.C.P. - RICHMOND ST. & UPAS ST.,  
 EL. 290.030

REFERENCES:-  
 GATE BK. G-19  
 GAS 2. SHTS. 196 & 203  
 2415-L WATER, RICHMOND ST.  
 5787-L " " " " 30" C.I. UPAS ST. P.L.  
 10561-6-D WATER, RICHMOND ST. 0+00 TO S.  
 6917-W WATER 6" A.C. UPAS ST.  
 6803-W " " RICHMOND ST. 4+23+ TO W.  
 FIELD NOTES 210-1722, 48397 RICHMOND ST.

RETIREMENT:-  
 363' - 4" C.I. - 1927  
 1-4" G.V. - 1927

GROUP 150 RICHMOND STREET 8" A.C. MAIN Upas Street to Myrtle Avenue		W.O. NO. 48397
CITY OF SAN DIEGO, CALIFORNIA ENGINEERING DEPARTMENT SHEET 11 OF 13 SHEETS		
DATE	DATE	DATE
DESCRIPTION	BY	APPROVED
ORIGINAL	P.P.	LLK/GFA
AS BUILT FOR 18-		
Project's Field &		
C.F. Notes	P.P.	LLK/REC-5-8-67
CONTRACTOR	CONST. CO.	DATE STARTED
INSPECTOR	MARTELL	DATE COMPLETED
		12471-4-D

AS BUILT

RICHMOND STREET UPAS STREET TO MYRTLE AVENUE