

AS BUILT DATA

CONSTRUCTED BY: LONG, MARKER (HOWLEY)
 W.O. 22474 (CONSTR) W.O. 148096 (ENGR.)
 PIPE: 6\"/>

GATE VALVES: B.F.V.
 (KIND)

SOIL: (KIND)

STAKED: 6-15-79
 (DATE)

TESTED: 7-30-79
 (DATE)

BACKFILL: (KIND)

NOTE: INCLUDE "CONSTRUCTION RECORD"
 CONNECTIONS BY: CITY FORCE
 W.O. 22475
 PIPE: 6\"/>

GATE VALVES: NONE


BENCH MARK: (MEAN SEA LEVEL DATUM)
 B.M. N.W. B.P. UPAS STREET & RICHMOND STREET
 ELEV. 290.033

REFERENCES:
 FIELD NOTES: SHOREY 5-24-78: 210-1722
 GATE BOOK 0-19
 GAS BOOK 15 PAGE 488 D

IMPROVEMENTS:
 WATER 6917-W 12471-4-D 12471-B-D
 PAVING 2419-L

RETIREMENT:
 703' C.C.I. 1327

SCALE
 1" = 5' VERTICAL
 1" = 50' HORIZONTAL

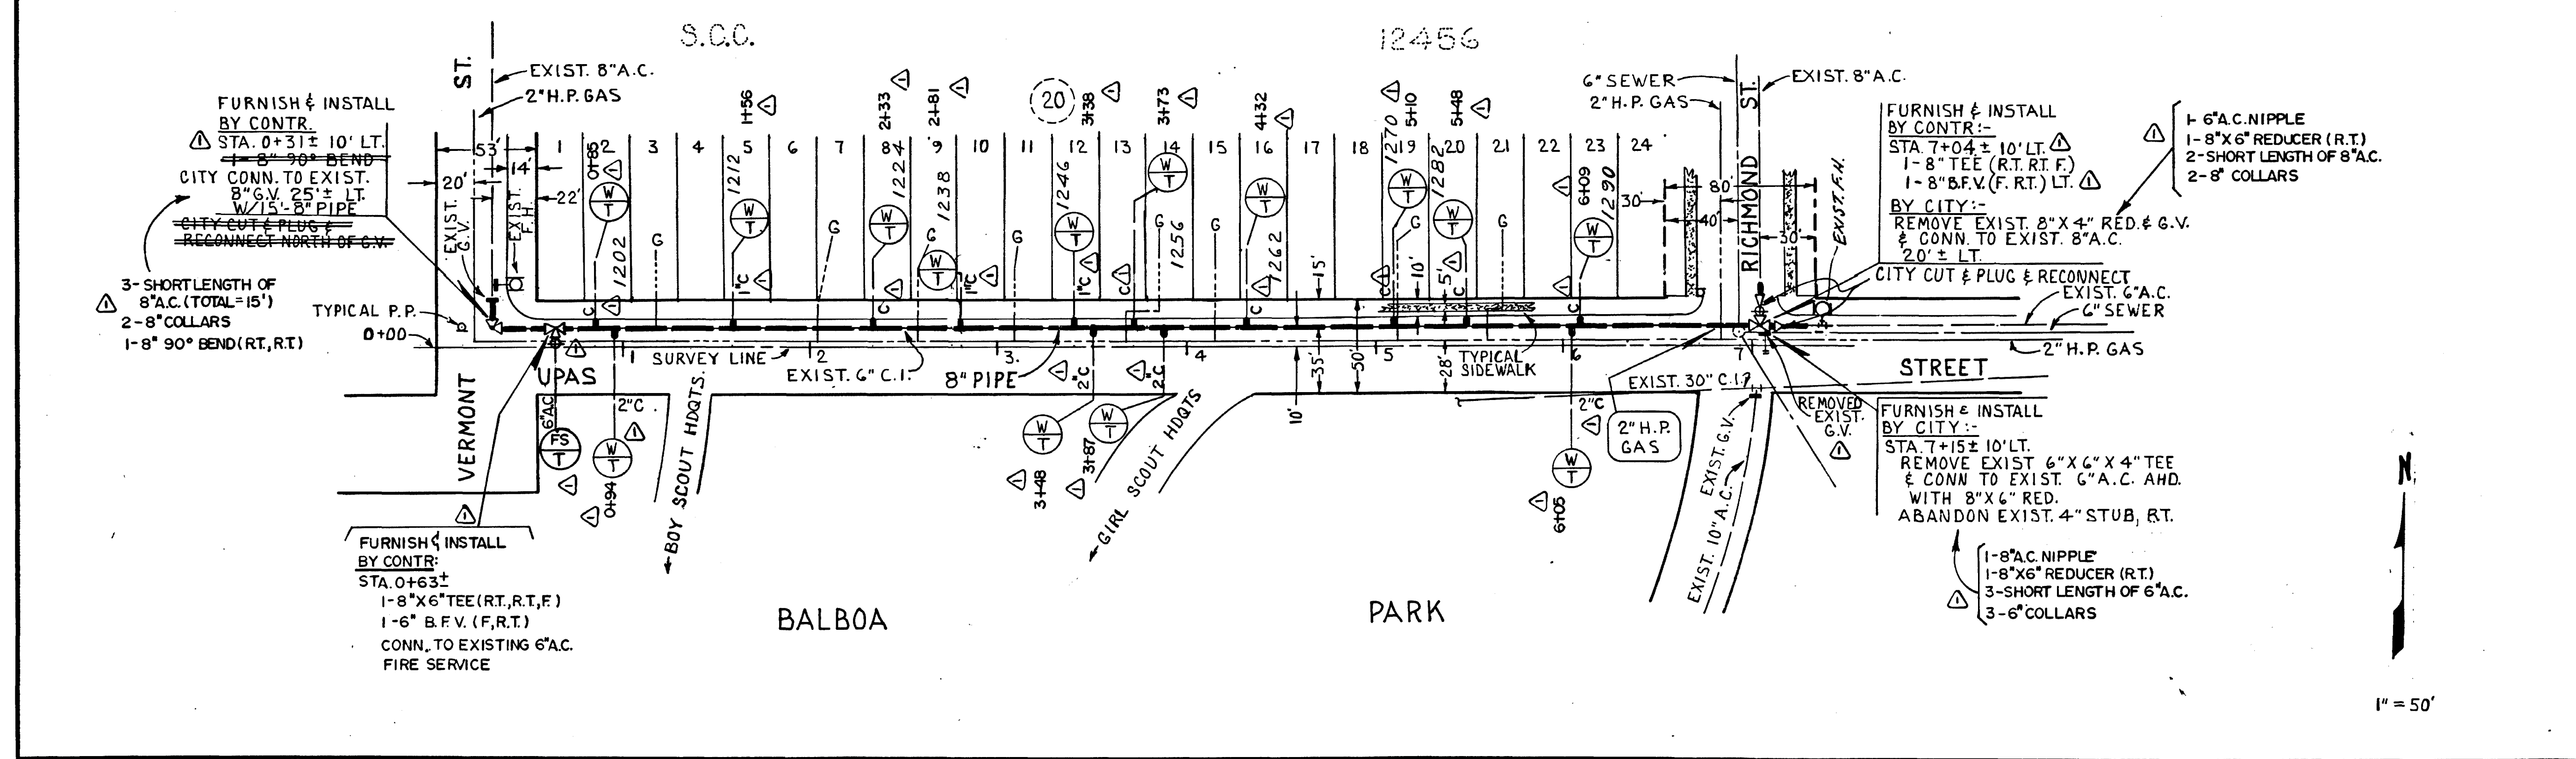

GROUP 418			
UPAS STREET 8\"/> 			
VERMONT STREET TO RICHMOND STREET			
CITY OF SAN DIEGO, CALIFORNIA UTILITIES DEPARTMENT		E.W.O. 148096 U.W.O. 22471	
SHEET 6 OF 8 SHEETS			
UTILITIES DIRECTOR	DATE	DESIGNED & PERMANENT	DATE
DESCRIPTION	BY	APPROVED	FILED
ORIGINAL	BIRCK	R. B. B.	
AS BUILT	J.E.C.	D.S.	
CONSTRUCTION RECORD		CONTROL CERTIFICATION	
LONG, MARKER & HOWLEY		210-1722	
CONTRACTOR: SCHROTBERGER		LAMBERT COORDINATES	
INSPECTOR: SCHROTBERGER		7-23-79	
CONNECTIONS BY: CITY FORCE		DATE COMPLETED 10-5-79	
17821-6-D			

AS BUILT

UPAS ST.

