



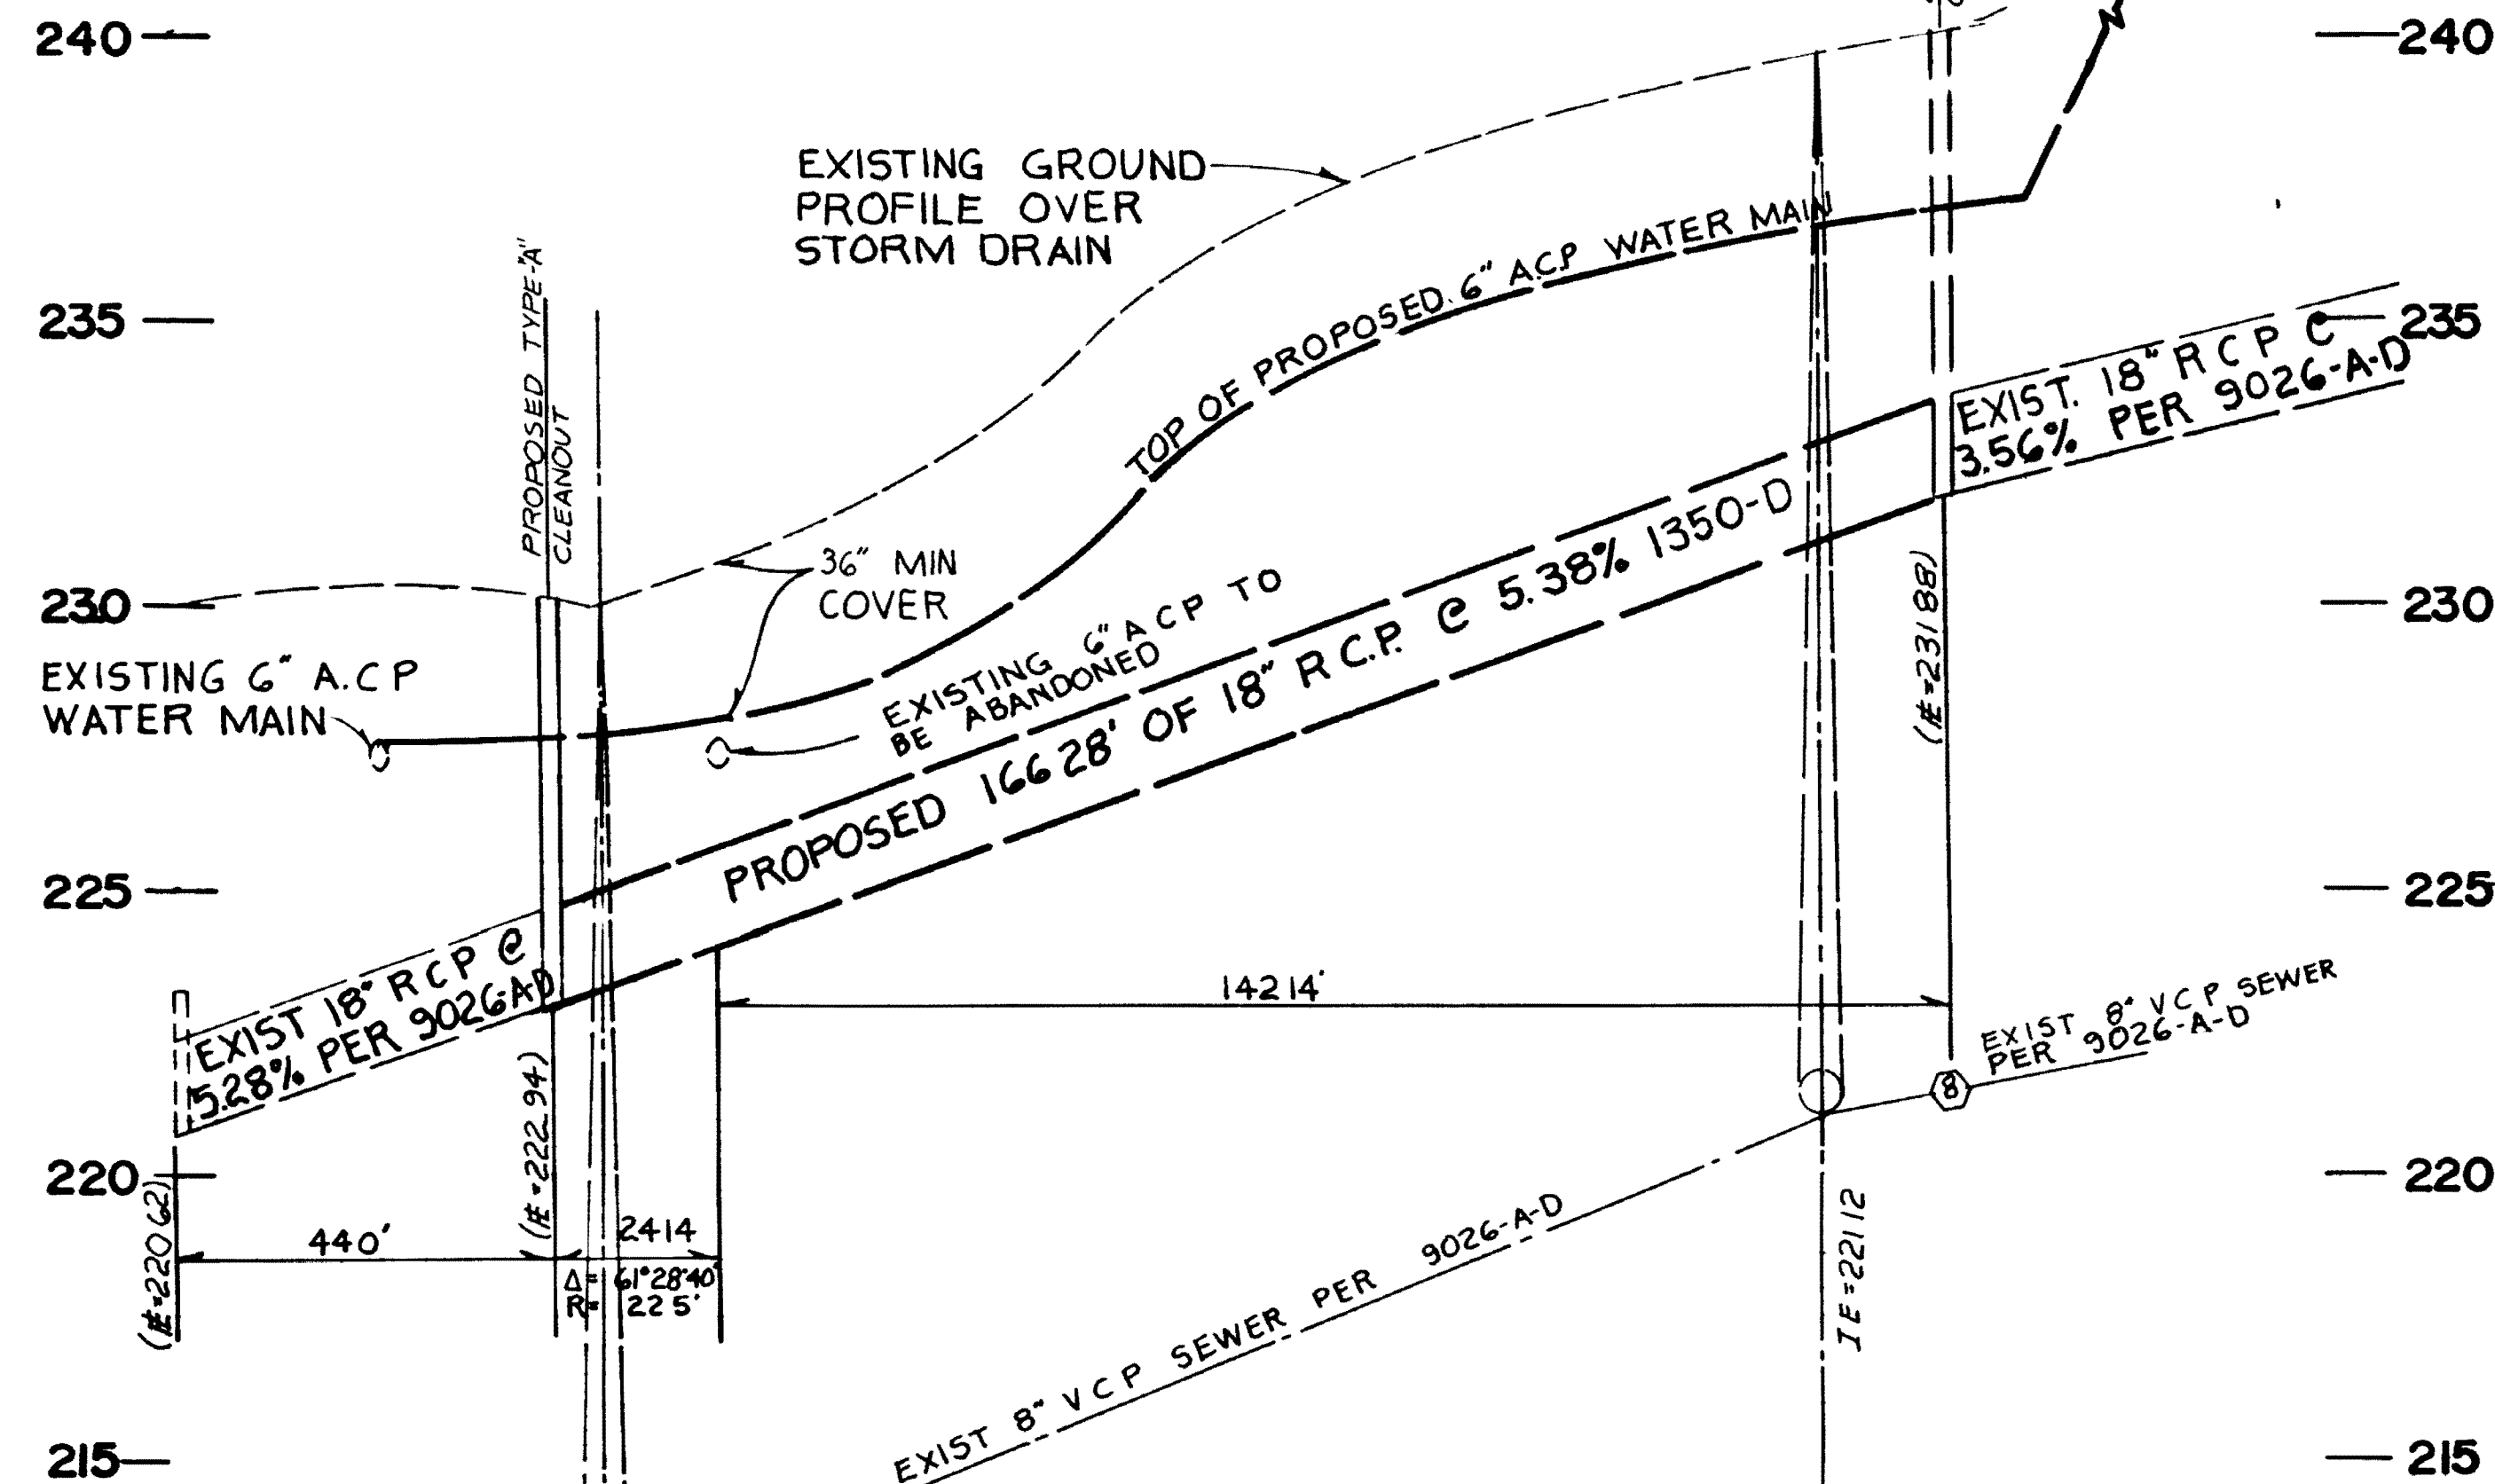

18" R.C.P. STORM DRAIN PROFILE

HORIZONTAL SCALE 1"=20' , VERTICAL SCALE 1"=3'

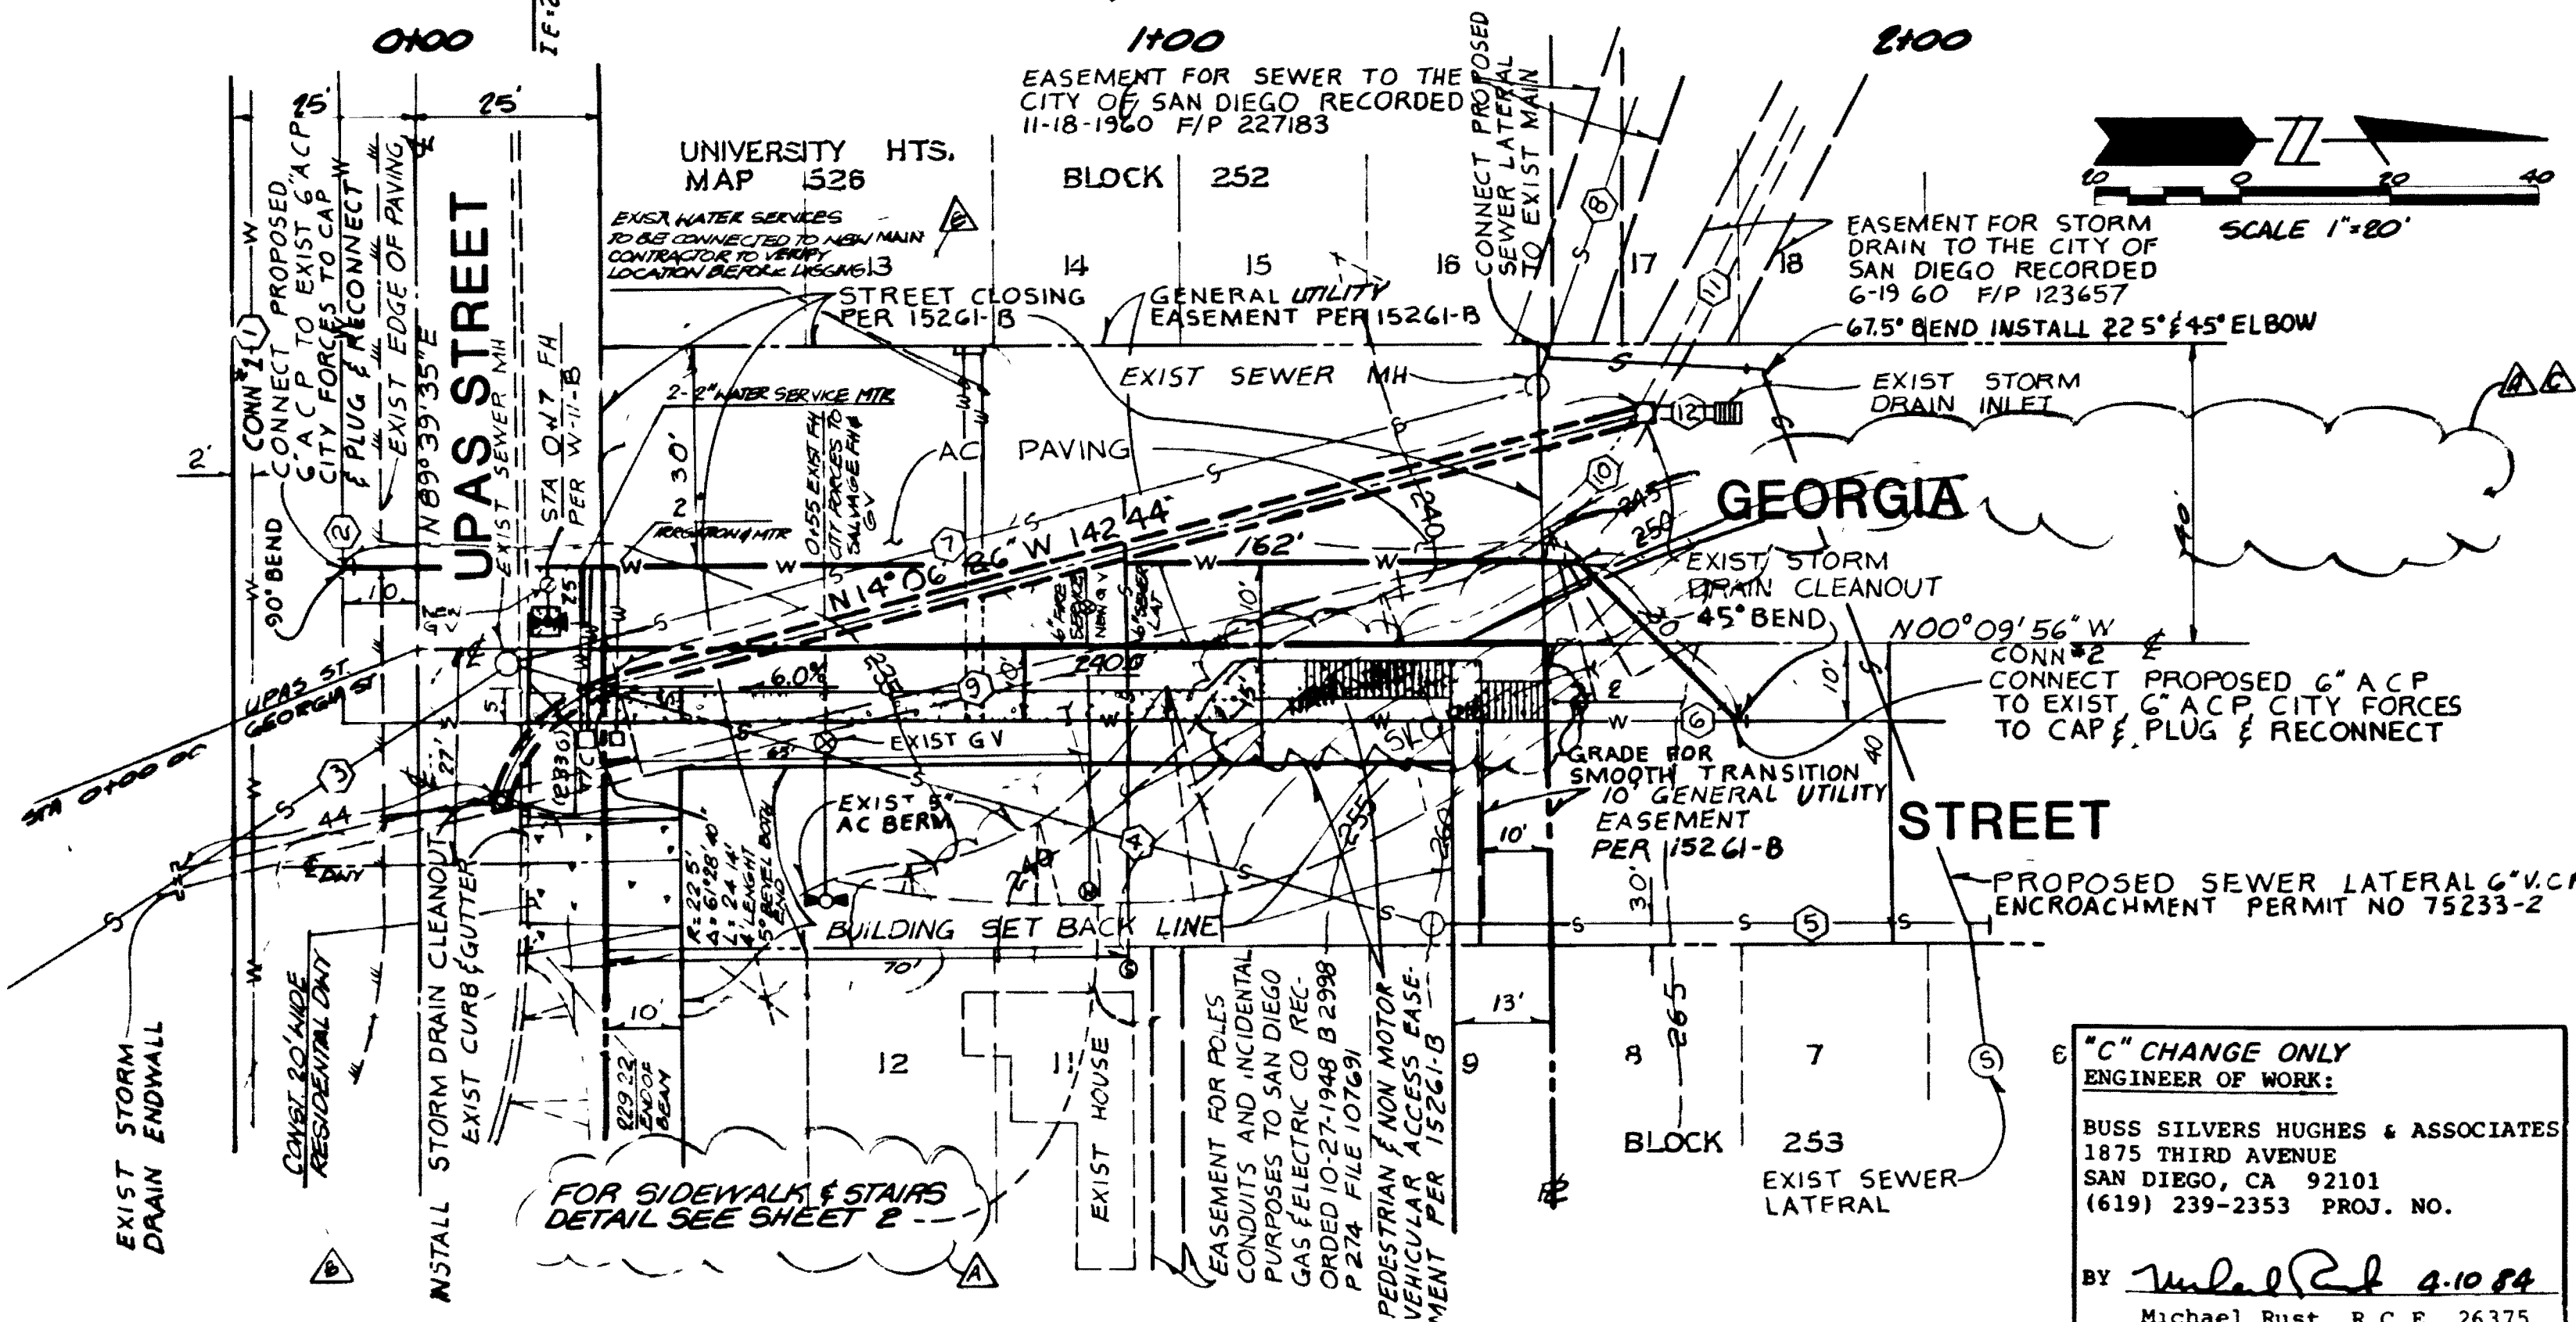

EXISTING UTILITY LINES						
NO	TYPE	REF. MAP NO.	BEARING/DELTA	RADIUS	LENGTH	REMARKS
1	30\" C.P. WATER	9026-D, 9026-A-D			(±20')	PORTION TO BE ABANDONED
2	6\" A.C.P. WATER	9026-D, 9026-A-D				11/2/61
3	6\" V.C.P. SEWER	9026-D, 9026-A-D			(±128')	TO BE ABANDONED
4	6\" V.C.P. SEWER	9026-D, 9026-A-D			(±75')	TO BE ABANDONED
5	6\" V.C.P. SEWER	9026-A-D			(±87')	PORTION TO BE ABANDONED
6	6\" V.C.P. SEWER	9026-A-D				11/2/61
7	6\" V.C.P. SEWER	9026-A-D	N15°19'14\"W	~	(44.46')	1961
8	6\" V.C.P. SEWER	9026-A-D	N71°39'01\"W	~	~	1961
9	6\" V.C.P. SEWER	9026-A-D	N12°34'49\"W	~	(174')	PORTION TO BE ABANDONED
10	6\" V.C.P. SEWER	9026-A-D	(Δ=50°)	(45')	(39.27')	TO BE ABANDONED
11	6\" V.C.P. SEWER	9026-A-D	N62°34'49\"W	~	~	11/2/61
12	6\" V.C.P. SEWER	9026-A-D	N00°10'48\"W	(10')	~	

WORK BY CITY FORCES

CONNECTION #1 \$2,255 6\" WATER MAIN CUT & PLUG & RECONNECT
 #2 \$2,255 6\" WATER MAIN CUT & PLUG & RECONNECT

A.D.T.

UPAS STREET 1,000
 GEORGIA STREET 1000
 WILSHIRE TERRACE 001-DL-SAC

BIGGS ENGINEERING CORPORATION
 CIVIL ENGINEERS • PLANNING CONSULTANTS • SURVEYORS
 121 EAST 31ST STREET, NATIONAL CITY, CALIFORNIA 92050 PH: 744-474-6559

NOTE SEE SHEET 2 & 3 & 4 REVISED SIDEWALK & STAIRS DELETE RETAINING WALL & PROPERTY LINE

WORK TO BE DONE

THE IMPROVEMENTS CONSIST OF THE FOLLOWING WORK TO BE DONE ACCORDING TO THESE PLANS AND THE SPECIFICATIONS AND STANDARD DRAWINGS OF THE CITY OF SAN DIEGO.


STANDARD SPECIFICATIONS

- STANDARD SPECIFICATIONS FOR PUBLIC WORKS CONSTRUCTION (1979 ED) DOCUMENT NO. 766725, FILED NOVEMBER 9, 1979
- STANDARD SPECIAL PROVISIONS, DOCUMENT NO. 767381, FILED NOVEMBER 9, 1979
- CITY OF SAN DIEGO STANDARD SPECIAL PROVISIONS, DOCUMENT NO. 767246, FILED SEPTEMBER 20, 1979

STANDARD DRAWINGS

- REGIONAL STANDARD DRAWINGS, DOCUMENT NO. 767429, FILED DECEMBER 3, 1979
- CITY OF SAN DIEGO STANDARD DRAWINGS, DOCUMENT NO. 767694, FILED MAY 9, 1980

LEGEND	SYMBOL
STREET PAVEMENT SCHEDULE "1"	
A.C. OVERLAY (1-1/2\" AVG.)	
6\" A.C. BERM (TYP. "A")	
GUARD RAIL	
STORM DRAIN	
CATCH BASIN (TYP. "1")	
CLEAN-OUT (TYPE "A")	
CURB OUTLET (MODIFIED)	
CUT-OFF WALL	
6\" A.C.P. WATER MAIN	
FIRE HYDRANT	
SEWER LATERAL	
RETAINING WALL	
SIDEWALK WITH HAND RAILS	
P.C.C. DRIVEWAY	
WATER SERVICE & METER	

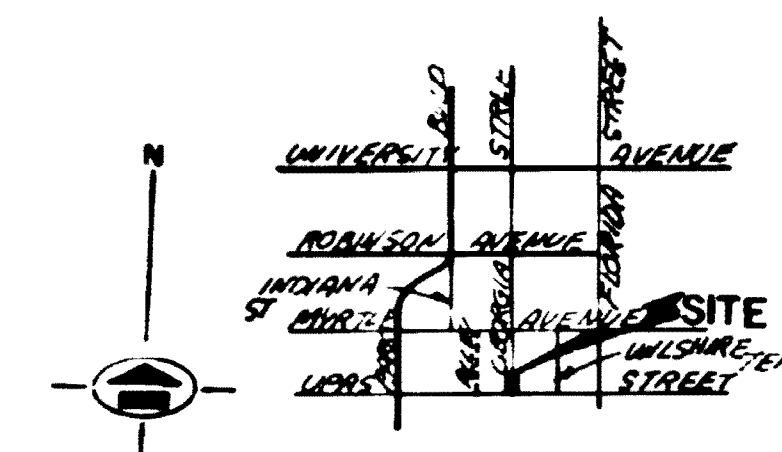

ENGINEERING PERMIT NO. W25902

BENCH MARK	ENGINEER OF WORK
CITY OF SAN DIEGO BENCH MARK NO. 2102725.4 NW COR. FLORIDA STREET & UPAS STREET BRASS PLUG ELEV. 200.974 MSL	DAN S. BIGGS RCE 26112

DATE 7-2-84 PRIVATE CONTRACT JOB NO. 81139

IMPROVEMENT PLAN FOR GEORGIA STREET UTILITIES RELOCATION

CITY OF SAN DIEGO, CALIFORNIA ENGINEERING DEPARTMENT SHEET 1 OF 4 SHEETS	10-02-007 NO. 75233
DESCRIPTION BY APPROVED DATE FILED	
ORIGINAL	
1\" CHANGE BIGGS 12-22-81	
2\" CHANGE BIGGS 12-22-81	
3\" CHANGE BIGGS 12-22-81	
AS BUILT	
CONTRACT NO. 81139 DATE STARTED 7-2-84 DATE COMPLETED 9-2-84	210-1725 20032-1-D

- CHANGE - 1 REVISE SIDEWALK & STAIRS
 2 DELETE RETAINING WALL & PROPERTY LINE
 3 DELETE RETAINING WALL NOTE
 4 ADD SHEET 4
- CHANGE - 1 ADD DRIVEWAY
 2 ADD FIRE SERVICE, WATER SERVICE & IRRIGATION
 3 CONNECT EXIST. WATER SERVICE TO NEW WATER MAIN
 4 ADD SEWER LATERAL

- CHANGE - 1 ADD LEGEND, RELOCATE WORK BY CITY FOR REQ. & A.D.T.
 2 ADD SHEET 3
 3 ADD RETAINING WALL NOTE