

THIS SHEET FOR ADDITIVE ALTERNATE NO. 1 ONLY.

UNIVERSITY HEIGHTS


NOTE: UPAS ST SHALL BE HIGHLINED BY CITY FORCES PRIOR TO BEGINNING OF CONSTRUCTION. CITY TO FURNISH HIGHLINING MATERIAL AND MAKE ALL CONNECTIONS.

- REFERENCES:** THOMAS BROTHER MAP - PG-60
 100' SCALE MAP 210-1722
 GATE BOOK PAGE 6-19
 S.D. GAS & ELECT. CO.
 GAS BOOK -11, PG-276 & BOOK-15, PG-488E
- IMPROVEMENTS:**
 SEWER: 4497-L
 WATER: 5766-L, 2414-L
- PAVING:**
 BENCH MARKS (MEAN SEA LEVEL DATUM)
 B.M. = SWHP UPAS ST & PARK BLVD., EL. 301.896
- FIELD NOTES:**
 1 CROSS-SECTION 210-1719 LINE "F", KELLEY, 3-27-86, W.O. 147125, SHT. OF 18
- RETIREMENTS:**
 385' - 6" CI. - YR. UNK
 320' - 4" CI. - YR. UNK
 1'-FH - 1928

AS BUILT DRAWING
 INSPECTOR: T. PALUSKY
 DATE: 9/18/98

| | |
|--|--|
| SEWER AND WATER GROUP 55 | |
| UPAS ST. | |
| ALLEY WEST TO ALLEY EAST OF PARK BLVD. | |
| ADDITIVE ALTERNATE NO. 1 | |
| CITY OF SAN DIEGO, CALIFORNIA ENGINEERING AND CAPITAL PROJECTS DEPARTMENT DESIGN SHEETS | E.W.G. 64911(SSEWER) UNEG. 64911(SSEWER) |
| DESIGNED BY: <i>[Signature]</i> | DATE: 1-20-97 |
| CHECKED BY: <i>[Signature]</i> | DATE: 2-10-97 |
| ORIGINAL: RA/RR | ASSOCIATE ENGINEER |
| AS BUILT: HW | DATE: 9/18/98 |
| CONSTRUCTION RECORD | |
| CONTRACTOR: P. ARTYMOVICH | DATE STARTED: 8/28/97 |
| INSPECTOR: T. PALUSKY | DATE COMPLETED: 7/26/98 |
| CONNECTED BY: | 210-1722 25163-29-D |

- 1 BY CITY AHEAD OF CONTRACTOR
 STA. 11+95.2, 8' LT. & 37' RT.
 CUT & PLUG, CONNECT TO 16" VALVES
 AFTER NEW MAIN HAS BEEN ACCEPTED
 FURNISH & INSTALL BY CONTRACTOR:
- 2 STA. 11+95.2, 27' RT.
 1- 16" x 8" CROSS (F)
 2- 8" VALVES (F, MJ) BK & AHD
 2- 16" VALVES (F, MJ) LT & RT
 30'-16" PIPE LT.
- 3 STA. 12+41.2, 27' RT.
 1- 8" x 8" TEE (MJ, MJ, F)
 1- 6" F.H. ASSEMBLY & MARKER
- BY CITY AHEAD OF CONTRACTOR:
- 4 STA. 15+05.2, 27' RT.
 CUT & PLUG EX 6" AC
- BY CITY AFTER NEW MAIN HAS BEEN ACCEPTED:
- STA. 15+05.2, 27' RT.
 FURNISH & INSTALL
 1- 6" x 8" RED.
 CONNECT NEW 8" PIPE TO EX. 6" AC.

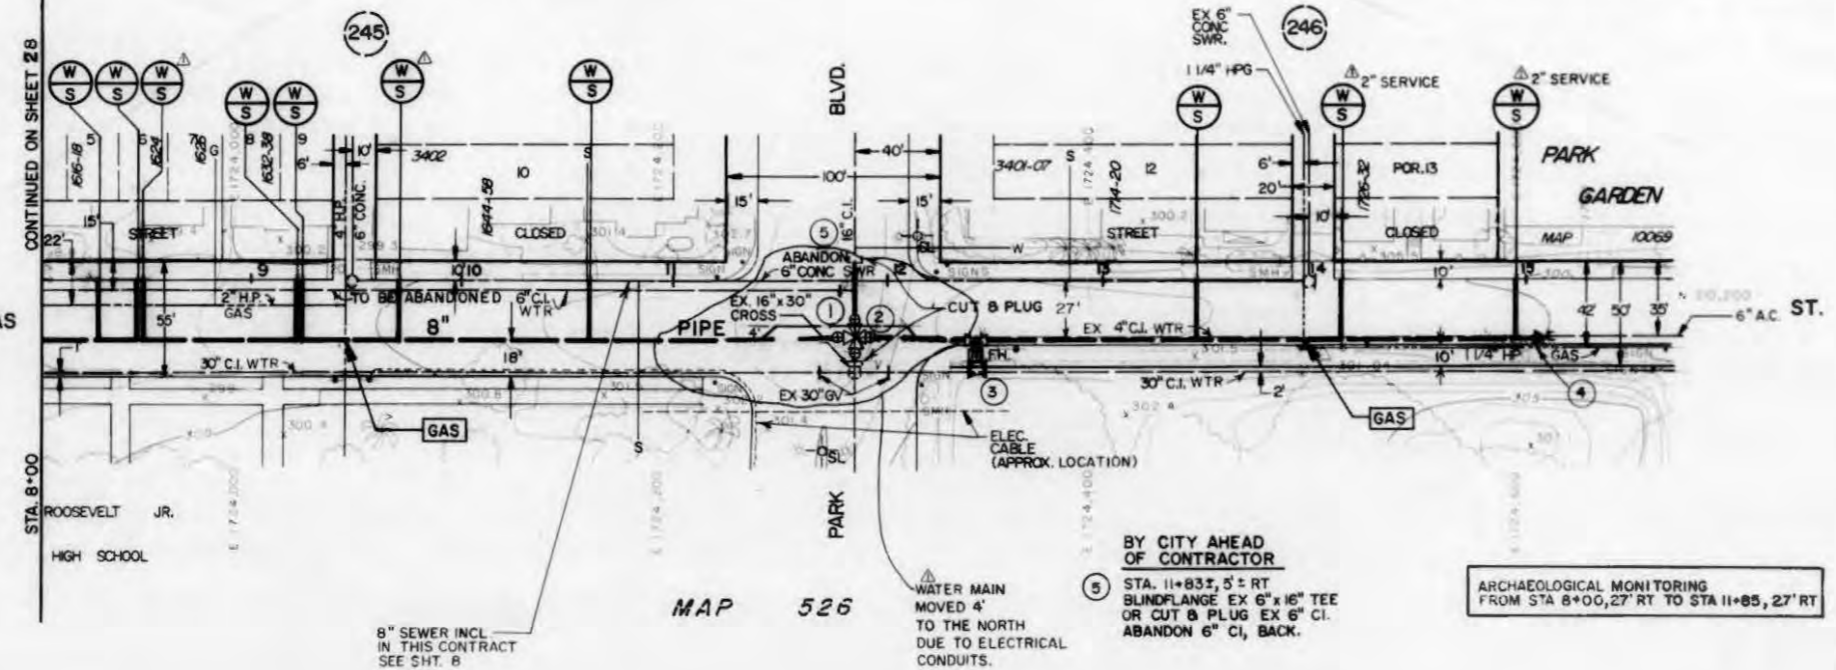

BY CITY AHEAD OF CONTRACTOR
 5 STA. 11+83.5, 5' ± RT
 BLINDFLANGE EX 6" x 16" TEE OR CUT & PLUG EX 6" CI.
 ABANDON 6" CI, BACK.

ARCHAEOLOGICAL MONITORING FROM STA 8+00, 27' RT TO STA 11+85, 27' RT



UPAS STREET

AS-BUILT

FILED FROM THE ORIGINAL. BEST QUALITY OBTAINABLE. EXCESSIVE GRAY BACKGROUND MAY CAUSE A POOR QUALITY REPRODUCTION.

