
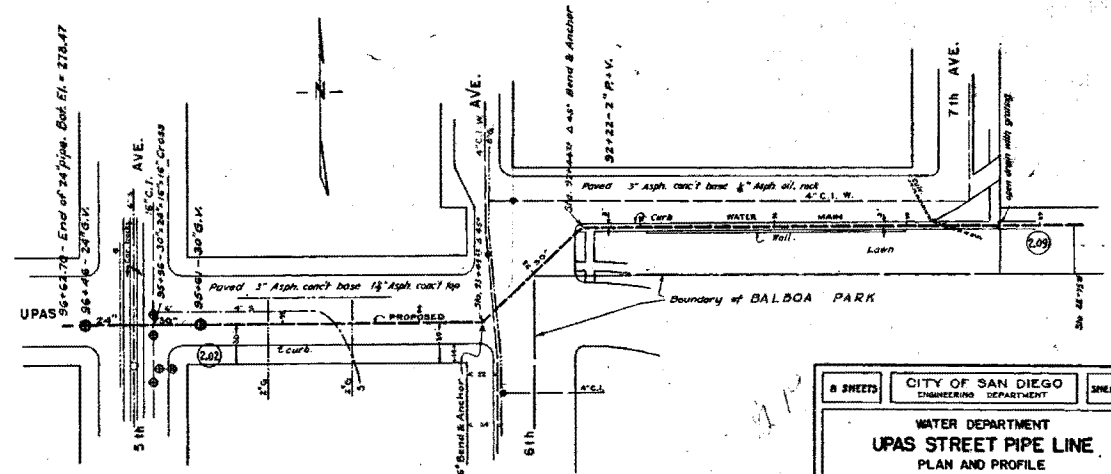


Lead (points 95+81 to 95+46.
(40' gates, 2 at cross.)

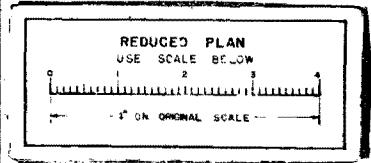

CITY DATUM
ADD 6.119 FEET
TO CONVERT TO
MEAN SEA LEVEL

8 SHEETS	CITY OF SAN DIEGO ENGINEERING DEPARTMENT	SHEET 8
WATER DEPARTMENT UPAS STREET PIPE LINE PLAN AND PROFILE		
APPROVED	DATE 8-12-39	SCALE 1" = 50'
DRAWN BY E. L. G. TRACED BY J. P. P. CHECKED BY J. P. P. T. B. 357 & 8-793	AS BUILT EDITED TO 3-5-40.	DRAWING NUMBER 5769-L

MICROFILMED
JUL 3 1963