


**AS BUILT DATA**  
 CONSTRUCTED: - HAYNES CONST. CO.,  
 W.O. 28774 (CONST.), W.O. 48172 (ENGR.),  
 PIPE: - 6" A.C., "J.M.;  
 GATE VALVES: - MUELLER,  
 SOIL: - GRANULAR,  
 STAKED: - 6-28-60, F.N. E-19, 20,  
 TESTED: - UNAVAILABLE,  
 BACKFILL: - EXISTING, AS ABOVE.  
 CONNECTIONS: - BY CITY FORCE,  
 W.O. 28775,  
 PIPE: - 6" A.C.,  
 GATE VALVES: - NONE.

**BENCH MARKS:** - (City Datum)  
 BM - S.E., B.P., State St. & Thorn St.,  
 El. 187.27';  
 BM - S.E., B.P., India St. & Spruce St.,  
 El. 86.00'.

**NOTE:** -  
 Contractor not to replace  
 existing Surfacing between  
 Sta. 0+00 ± & 3+00 ±.

**References:** -  
 Water Rack, Shts F-20-A & B;  
 & Sewer Bk. 1, Sht. 31;  
 Gate Bk. A - 47;  
 Gas Bk. 2, Shts. 127-29;  
 # 5518 - W. (Water);  
 # 3844 - B, # 3301 - B, (Openings).

**Retirement:** -  
 43' 2" W.I. 1939;  
 1 2" G.V. . .

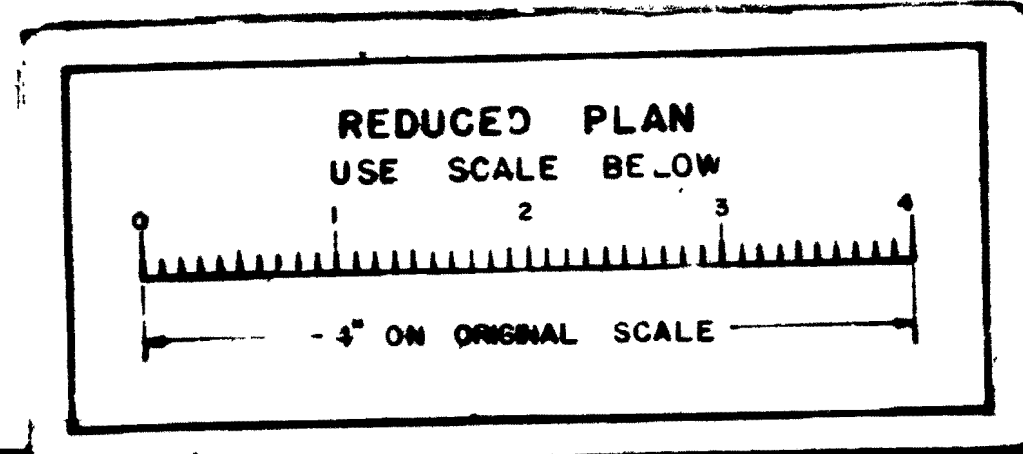

GROUP 31  
 UNION STREET 6" A.C. MAIN  
 THORN STREET TO SASSAFRAS STREET

ENGINEERING W.O. 48172

CITY OF SAN DIEGO  
 ENGINEERING DEPARTMENT

SHEET 9 OF 12 SHEETS  
 8800 - W

PLAN REVISION		APPROVALS FOR	
CHANGE	BY DATE	APPROVAL	SITE
AS BUILT - For Inspection	BOOKY 10-5-60	<i>[Signature]</i>	4/7/60
CONSTRUCTION RECORD		APPROVALS FOR	
JUNE, 1960	JULY, 1960	WATER DEPT.	SEWERAGE
DATE STAKED	DATE COMPLETED	PLANNING DEPT.	DRAINAGE
CONTR. SEE ABOVE	INSPECTOR: D.M.S. TRAVER	ELECTRICAL	HIGHWAY
FIELD BOOK F - 19, 20		STRUCTURAL	GRADES
		TRAFFIC	CONV. DIV.

8924 - D

AS BUILT      MICROFILMED      INDEXED

JUL 1 1960

UNION STREET