

Discussion Item

Botanical Building Naming Opportunities
and Donor Acknowledgement Program

Review of Timeline Important Dates:


- Balboa Park Committee Approval on January 20, 2021.
- Park and Recreation Board Approval on May 20, 2021.
- City Council Resolution Number R-313656.
Date of Final Passage August 3, 2021.

Potential Naming Opportunities:


- | | |
|---|----------------------------------|
| 1. Welcome Gallery | 9. West Patio |
| 2. Central Rotunda | 10. Pergola (Reconstruction) |
| 3. Northern Annex | 11. West Fountain Plaza |
| 4. North Entrance Lobby | 12. East Fountain Plaza |
| 5. Multi Purpose Room (West) | 13. West Gardens |
| 6. Multi Purpose Room (East) | 14. East Gardens |
| 7. <u>West Wing Gardens</u> | 15. Potting Shed Area |
| 8. <u>East Wing Gardens</u> | |

NAMING OPPORTUNITY - BRONZE LETTER INSTALLATION

DATE 9/12/2025

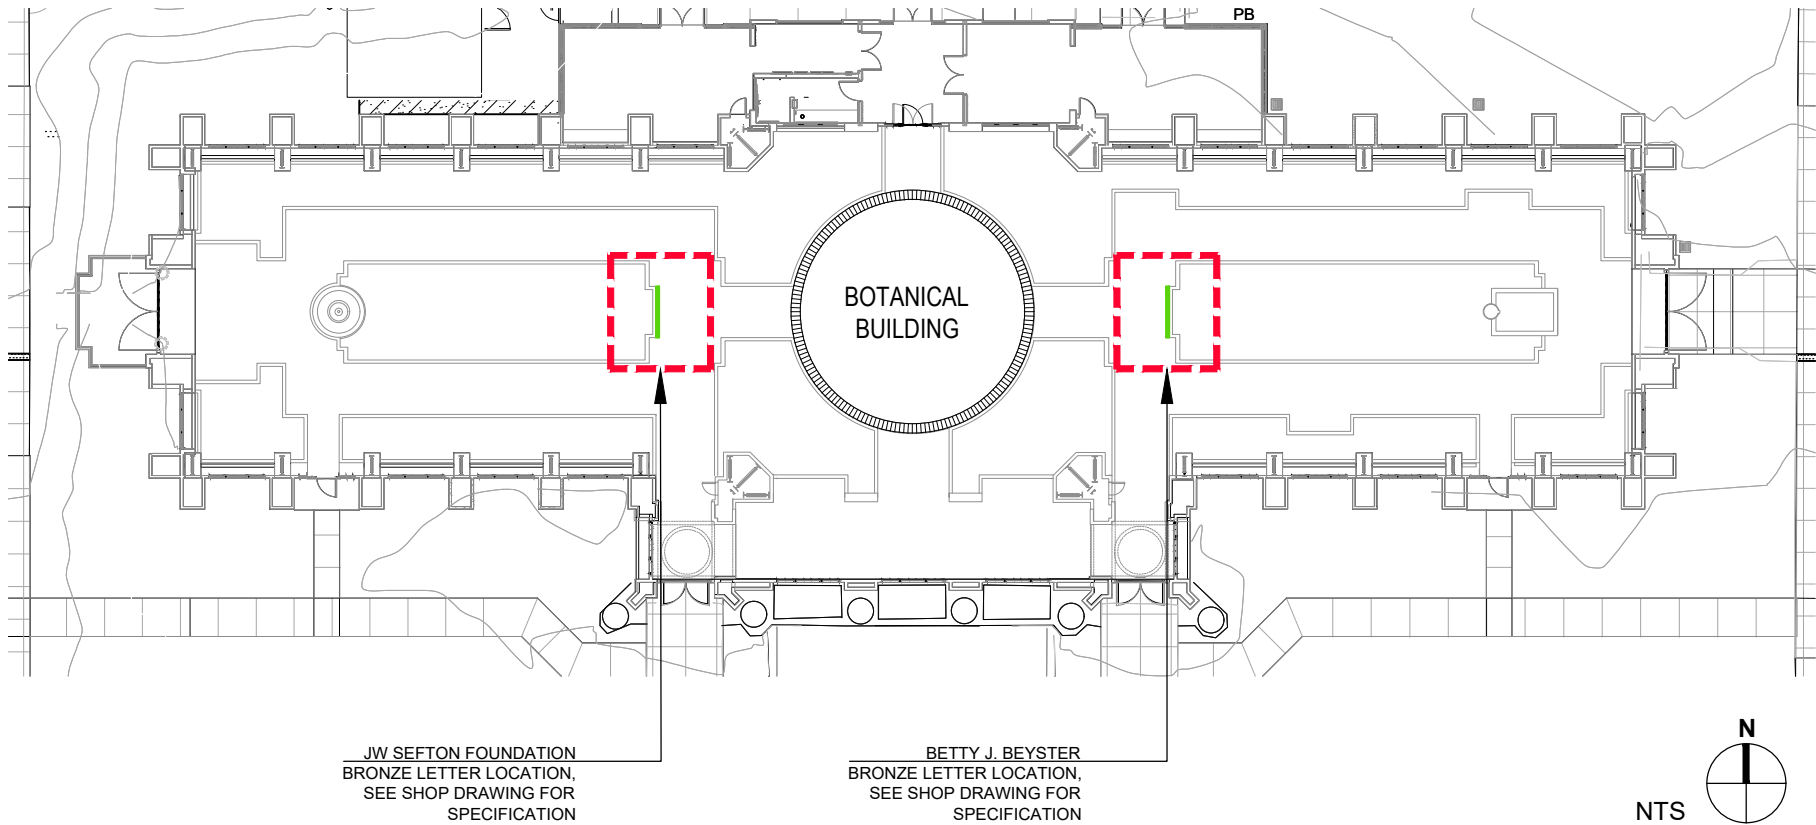

NOTE:
FINAL LOCATION TO BE
COORDINATED WITH FBP

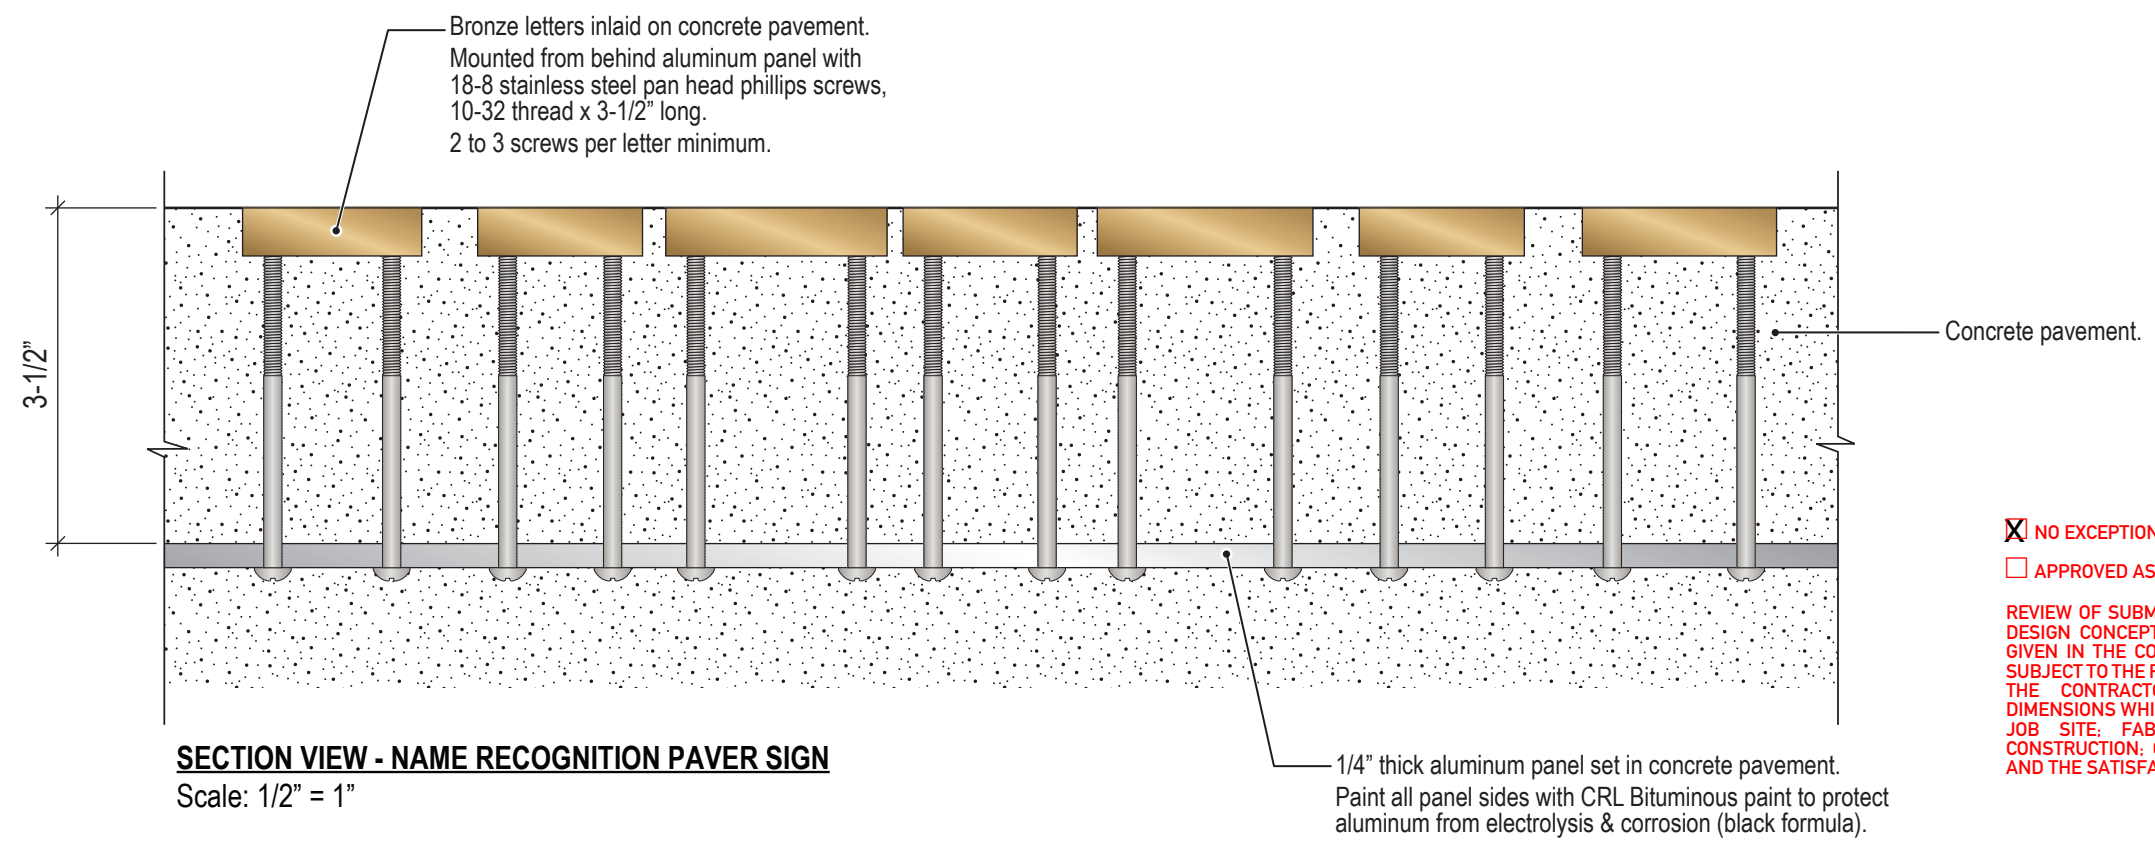

☒ NO EXCEPTIONS TAKEN
☐ APPROVED AS NOTED
☐ REVISE & RESUBMIT
☐ REJECTED


REVIEW OF SUBMITTALS IS FOR GENERAL CONFORMANCE WITH THE DESIGN CONCEPTS OF THE PROJECT AND WITH THE INFORMATION GIVEN IN THE CONSTRUCTION DOCUMENTS. ANY ACTION SHOWN IS SUBJECT TO THE REQUIREMENTS OF THE PLANS AND SPECIFICATIONS. THE CONTRACTOR IS RESPONSIBLE FOR QUANTITIES AND DIMENSIONS WHICH SHALL BE CONFIRMED AND CORRELATED AT THE JOB SITE. FABRICATIONS PROCESSES AND TECHNIQUES OF CONSTRUCTION: COORDINATION FOR THE WORK WITH ALL TRADES AND THE SATISFACTORY PERFORMANCE OF THE WORK.

SPURLOCK
LANDSCAPE ARCHITECTS

FBP-231

SUBMITTAL NO. 6/24/2025

REVIEWED BY DATE

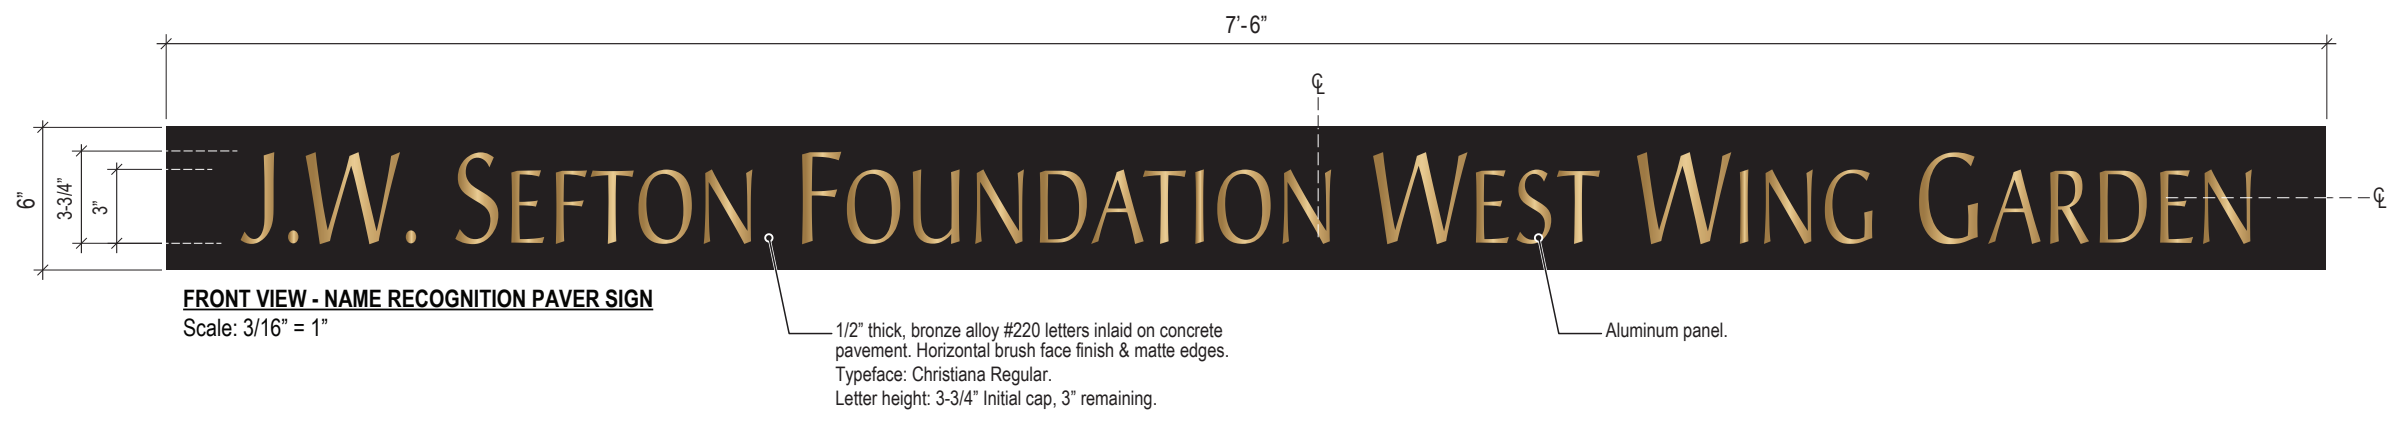

This rendering and design is the property of CA Signs and its use is restricted to the original project for which it was prepared. Any reproduction, publication or reuse by any method, in whole or in part, by others is prohibited without the written consent of CA Signs and is a violation of the law and is subject to legal recourse.
Important note regarding digital colors shown: The colors represented on the layouts/drawings are only representations and may vary from the finished product. For actual samples of any displayed color or combination thereof, please contact your sales representative.




10280 Glenoaks Boulevard
Pacoima, CA 91331-1604
Telephone: 818-899-1888
www.casigns.com

Client Approval:
☐ as submitted
☐ as noted ☐ resubmit
By: _____ Date: _____

Project: Forever Balboa Park
Ref: Paver Letters

Internal Use Only:
Revision ☐ Date: _____
Notes:

Schematic #1
Drawn by: Martin/Chris Date: 06/10/25
Revision ☐ 1 Date: 06/16/25

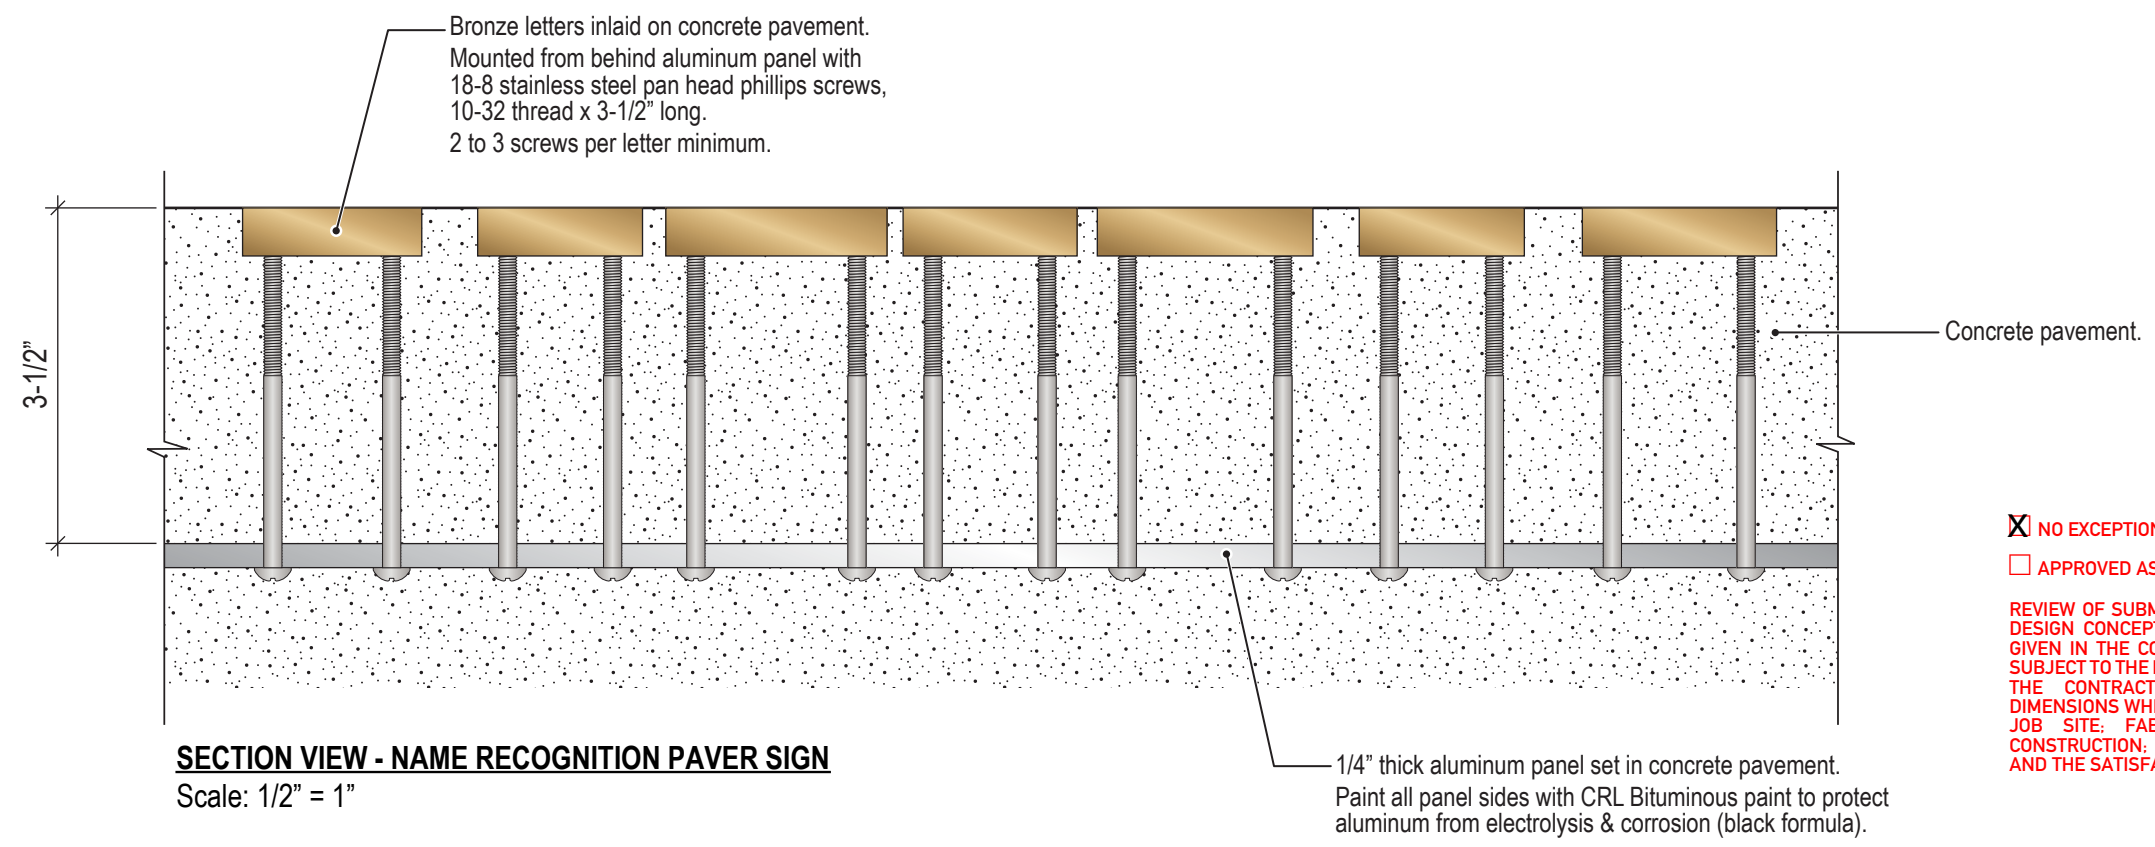

☒ NO EXCEPTIONS TAKEN ☐ REVISE & RESUBMIT
☐ APPROVED AS NOTED ☐ REJECTED

REVIEW OF SUBMITTALS IS FOR GENERAL CONFORMANCE WITH THE DESIGN CONCEPTS OF THE PROJECT AND WITH THE INFORMATION GIVEN IN THE CONSTRUCTION DOCUMENTS. ANY ACTION SHOWN IS SUBJECT TO THE REQUIREMENTS OF THE PLANS AND SPECIFICATIONS. THE CONTRACTOR IS RESPONSIBLE FOR: QUANTITIES AND DIMENSIONS WHICH SHALL BE CONFIRMED AND CORRELATED AT THE JOB SITE; FABRICATIONS PROCESSES AND TECHNIQUES OF CONSTRUCTION; COORDINATION FOR THE WORK WITH ALL TRADES AND THE SATISFACTORY PERFORMANCE OF THE WORK.

SPURLOCK
LANDSCAPE ARCHITECTS


FBP-231

SUBMITTAL NO
Ania Armour

JOB NO.
11/14/2024

REVIEWED BY

DATE

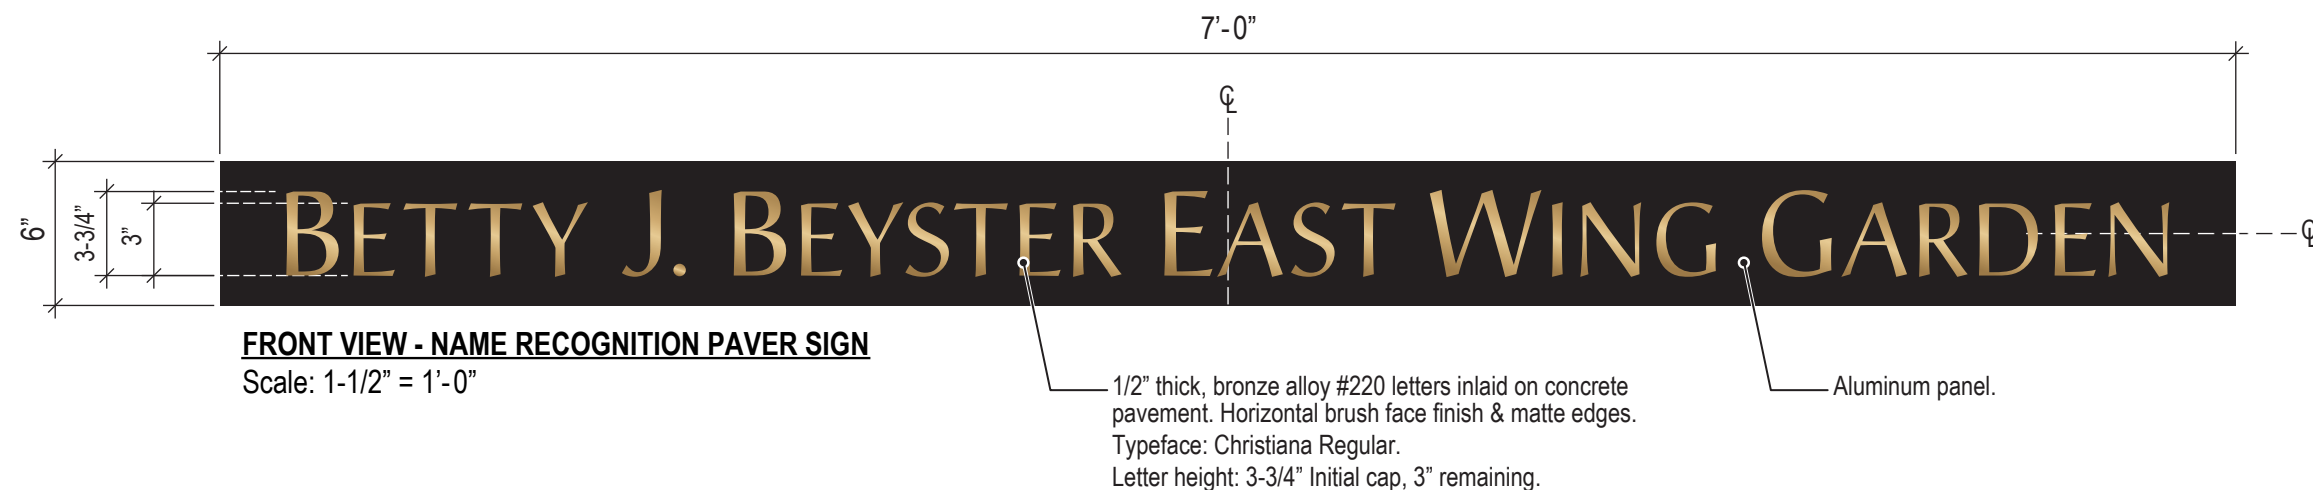

This rendering and design is the property of CA Signs and its use is restricted to the original project for which it was prepared. Any reproduction, publication or reuse by any method, in whole or in part, by others is prohibited without the written consent of CA Signs and is a violation of the law and is subject to legal recourse.
Important note regarding digital colors shown: The colors represented on the layouts/drawings are only representations and may vary from the finished product. For actual samples of any displayed color or combination thereof, please contact your sales representative.



10280 Glenoaks Boulevard
Pacoima, CA 91331-1604
Telephone: 818-899-1888
www.casigns.com

Client Approval:

☐ as submitted
☐ as noted ☐ resubmit

By: _____ Date: _____

Project: Balboa Park Botanical Bldg.

Ref: Donor Recognition Paver

Internal Use Only:

Revision Date: _____
Notes:

Schematic #1

Drawn by: Martin Date: 10/09/24

Revision 2 Date: 11/06/24