



(See Sheet No. 209, also)

(See sheet No. 206, also)

(See Sheet No. 207, also)

ⓐ Portion of Canyon St. closed by Res. 113371, July 28, 1953. (Closing 775)

Check of street names completed September 2, 1931. J. L. M.
J. A. T.

211

210

(See Sheet No 211, also)

Portions of R.L. 191,
192 & 193
A.G. Spalding et ux,
Feb. 10, 1914. Rec. Feb. 16,
1914. 643/131

Portions of R.L. 192 & 193
School of Agriculture, Electric Light Co.,
Aug. 1, 1916. Rec. Aug. 31, 1916. 714/122.
Ord. 7001 May 26, 1917 Names Catalina Blvd.
Ord. 7320 Apr. 21, 1918. to Hill St.
Ord. 7320 Apr. 21, 1918 Names Catalina Blvd.

Check of street names completed August 10, 1921. J. L. M.
J.A.T.

205

209

208

Portions of R.L. 191,
192 & 193
A.G. Spalding et ux,
Feb. 10, 1914. Rec. Feb. 16,
1914. 643/131

Portions of R.L. 191,
192 & 193
A.G. Spalding et ux,
Feb. 10, 1914. Rec. Feb. 16,
1914. 643/131

Point Loma Holding Corporation
Feb. 26, 1945 Rec. Apr. 16, 1945
1850/245 Res. 80670-Apr. 10, 1945
names Varona St. Portions of
Lot 180 laid out and dedicated as
public highways; parcel 1 named Varona
St. Parcel 2 named Catalina Blvd. by
Ord. 2672 (New Series) dated May 11, 1945

Portions of R.L. 191,
192 & 193
A.G. Spalding et ux,
Feb. 10, 1914. Rec. Feb. 16,
1914. 643/131

Portions of R.L. 191,
192 & 193
A.G. Spalding et ux,
Feb. 10, 1914. Rec. Feb. 16,
1914. 643/131

OCEAN

PACIFIC



Check of street

ed August 10, 1931. J. I. M.
J. A. T.

PACIFIC

OCEAN

210

212


213

211

Check of street names completed August 10, 1931. J. L. M.

209

J. A. T.

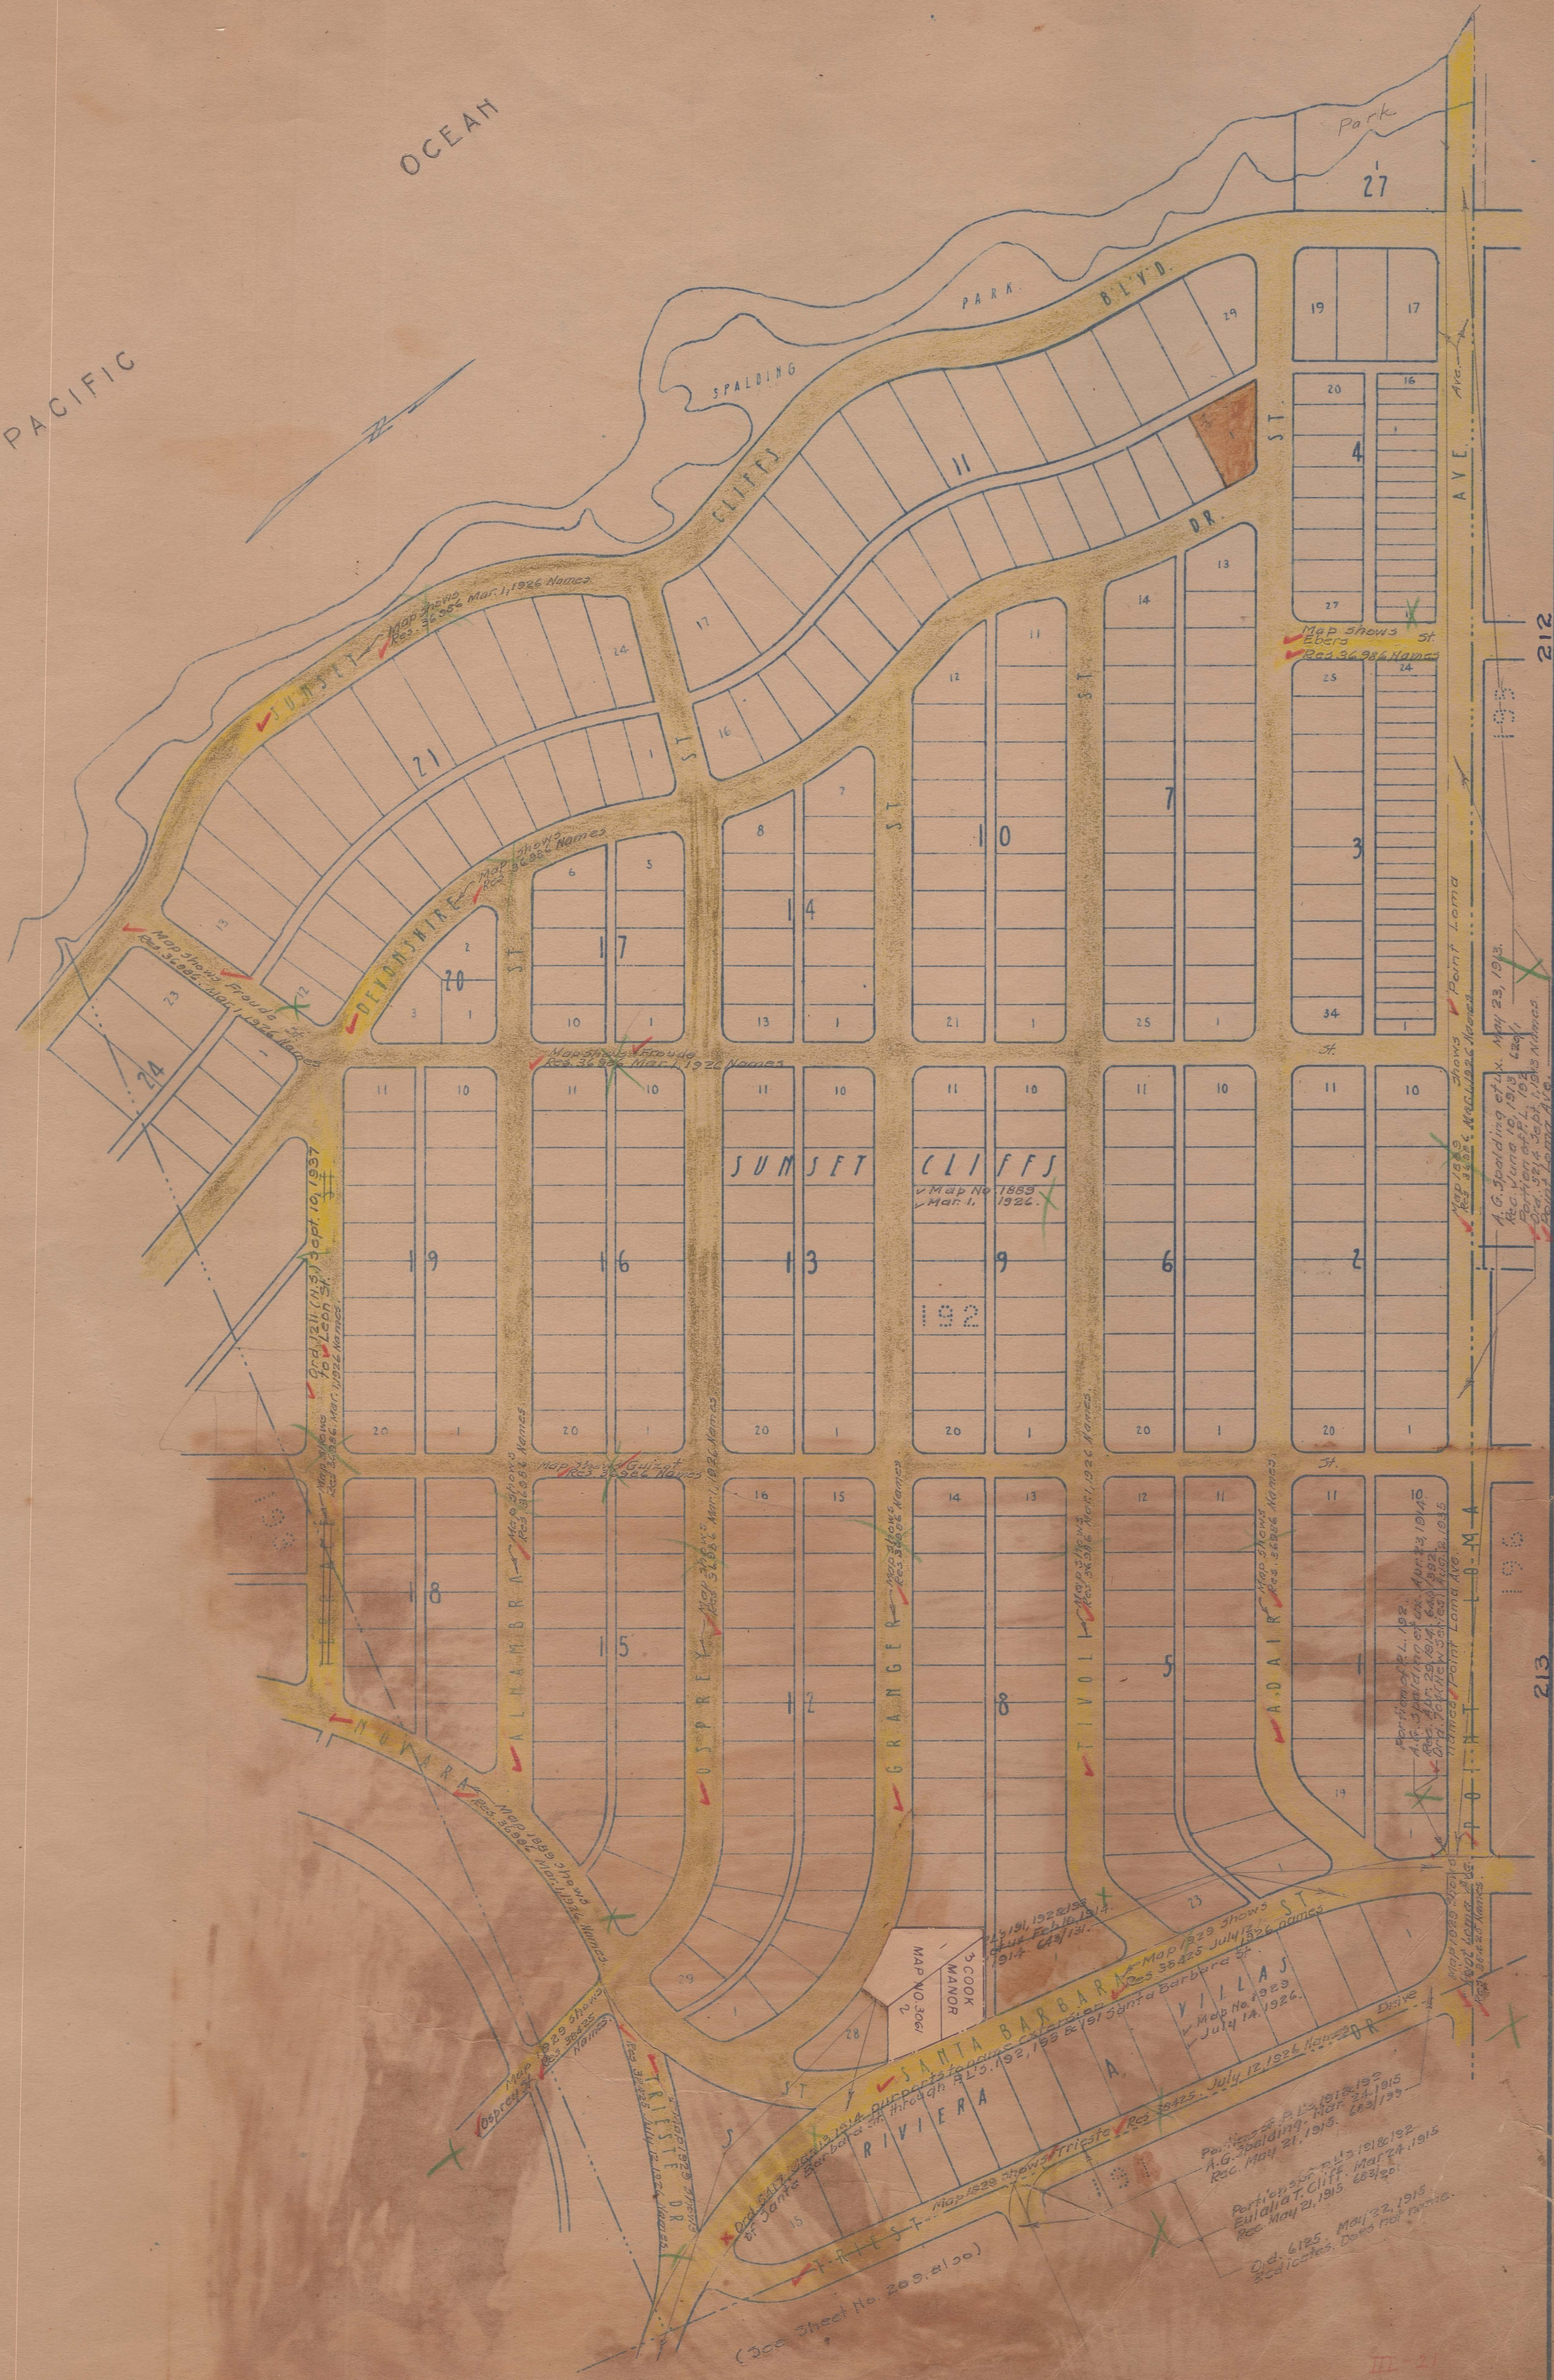

~~DEL~~... ~~MOTTE~~... ~~Motte~~

J. L. M.
J. A. T.

