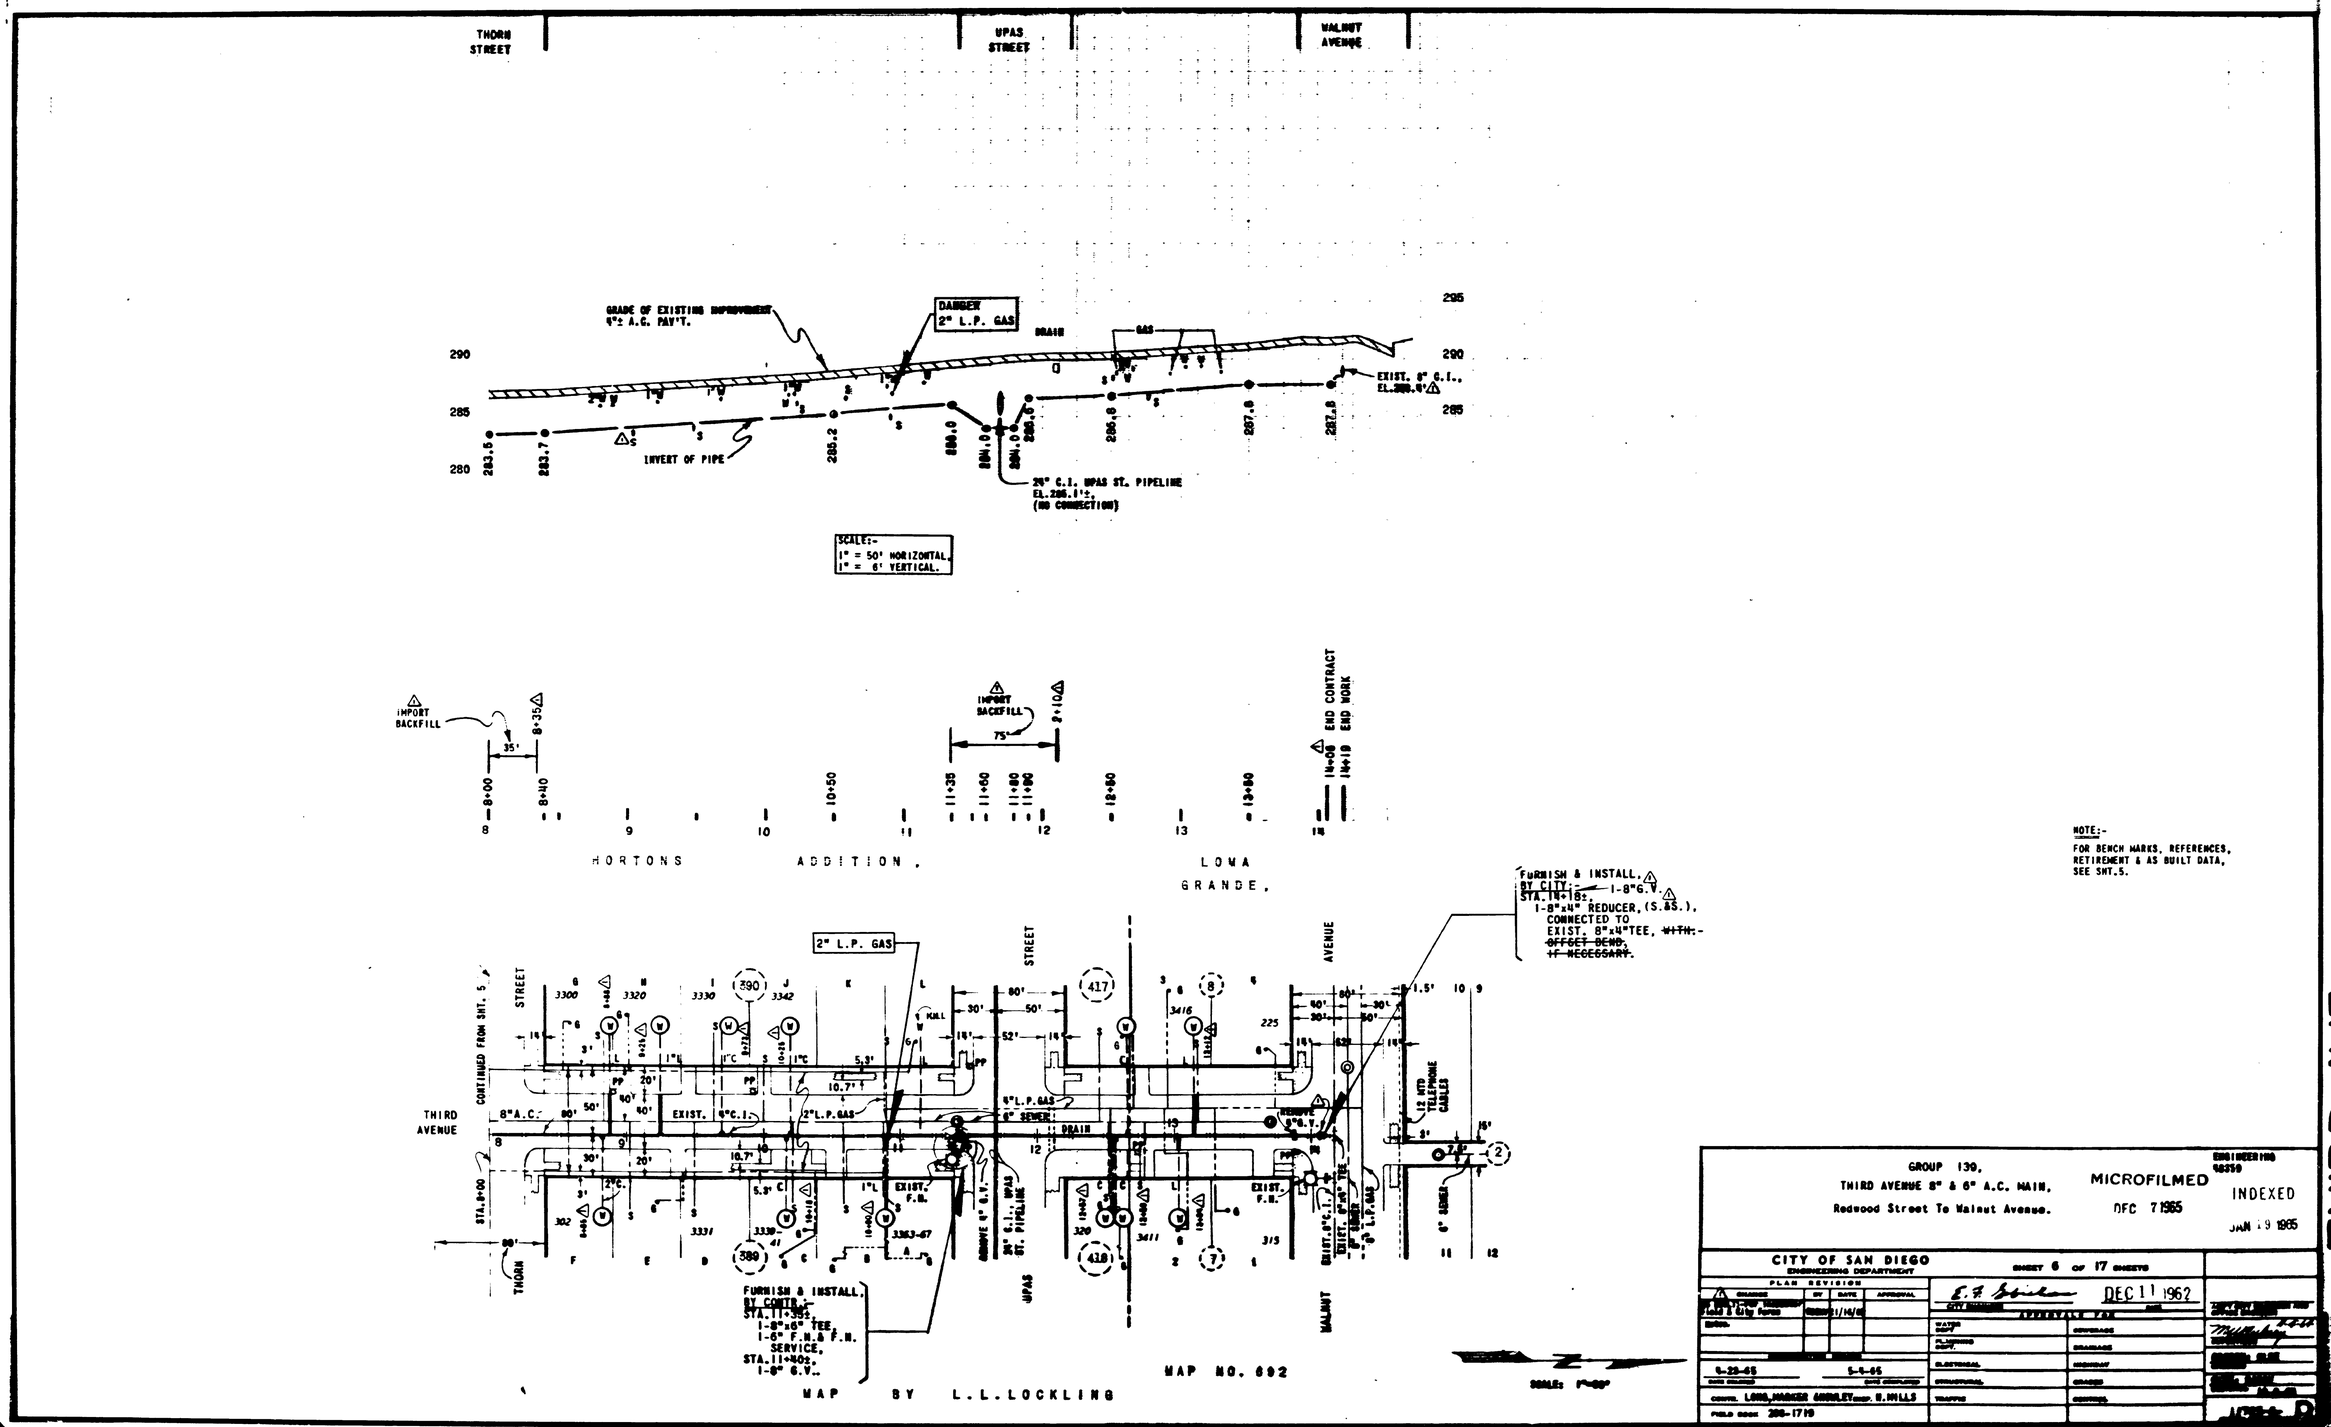

NOTE:-
FOR BENCH MARKS, REFERENCES, RETIREMENT & AS BUILT DATA, SEE SHT.5.

GROUP 139,
THIRD AVENUE 8" & 6" A.C. MAIN,
Redwood Street To Walnut Avenue.

MICROFILMED
DEC 7 1965

ENGINEERING 48359
INDEXED
JAN 19 1965

CITY OF SAN DIEGO
ENGINEERING DEPARTMENT

SHEET 6 OF 17 SHEETS

PLAN REVISION

E. F. Gibson
DEC 11 1962

APPROVALS FOR

WATER DEPT.	COVERAGE
PLANNING DEPT.	DRAINAGE
ELECTRICAL	HIGHWAY
STRUCTURAL	GRADES
TRAFFIC	CONTROL

4-23-65 5-4-65

CONTR. LONG, MARKER & HOWLEY INSP. H. MILLS

FIELD BOOK 206-1719

6-19-8, 6-20-A.

AS BUILT

THIRD AVE., Redwood St. to Walnut Ave..