
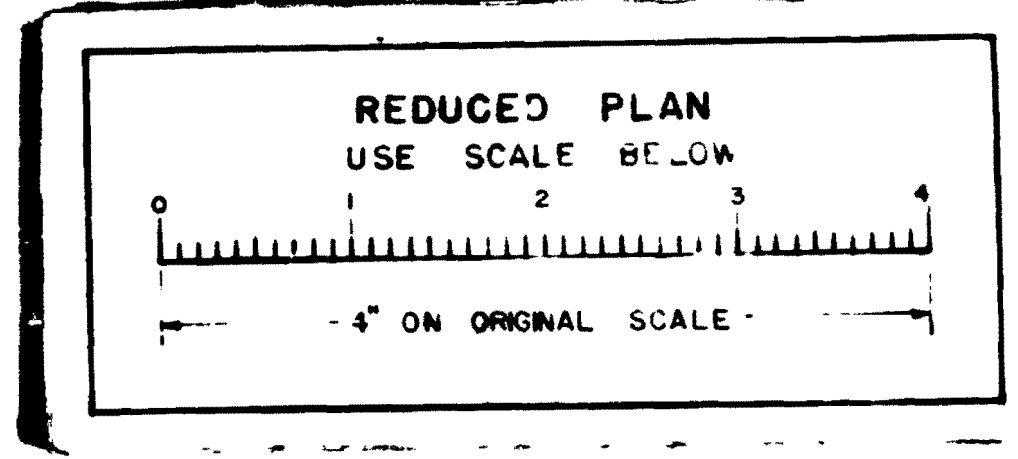
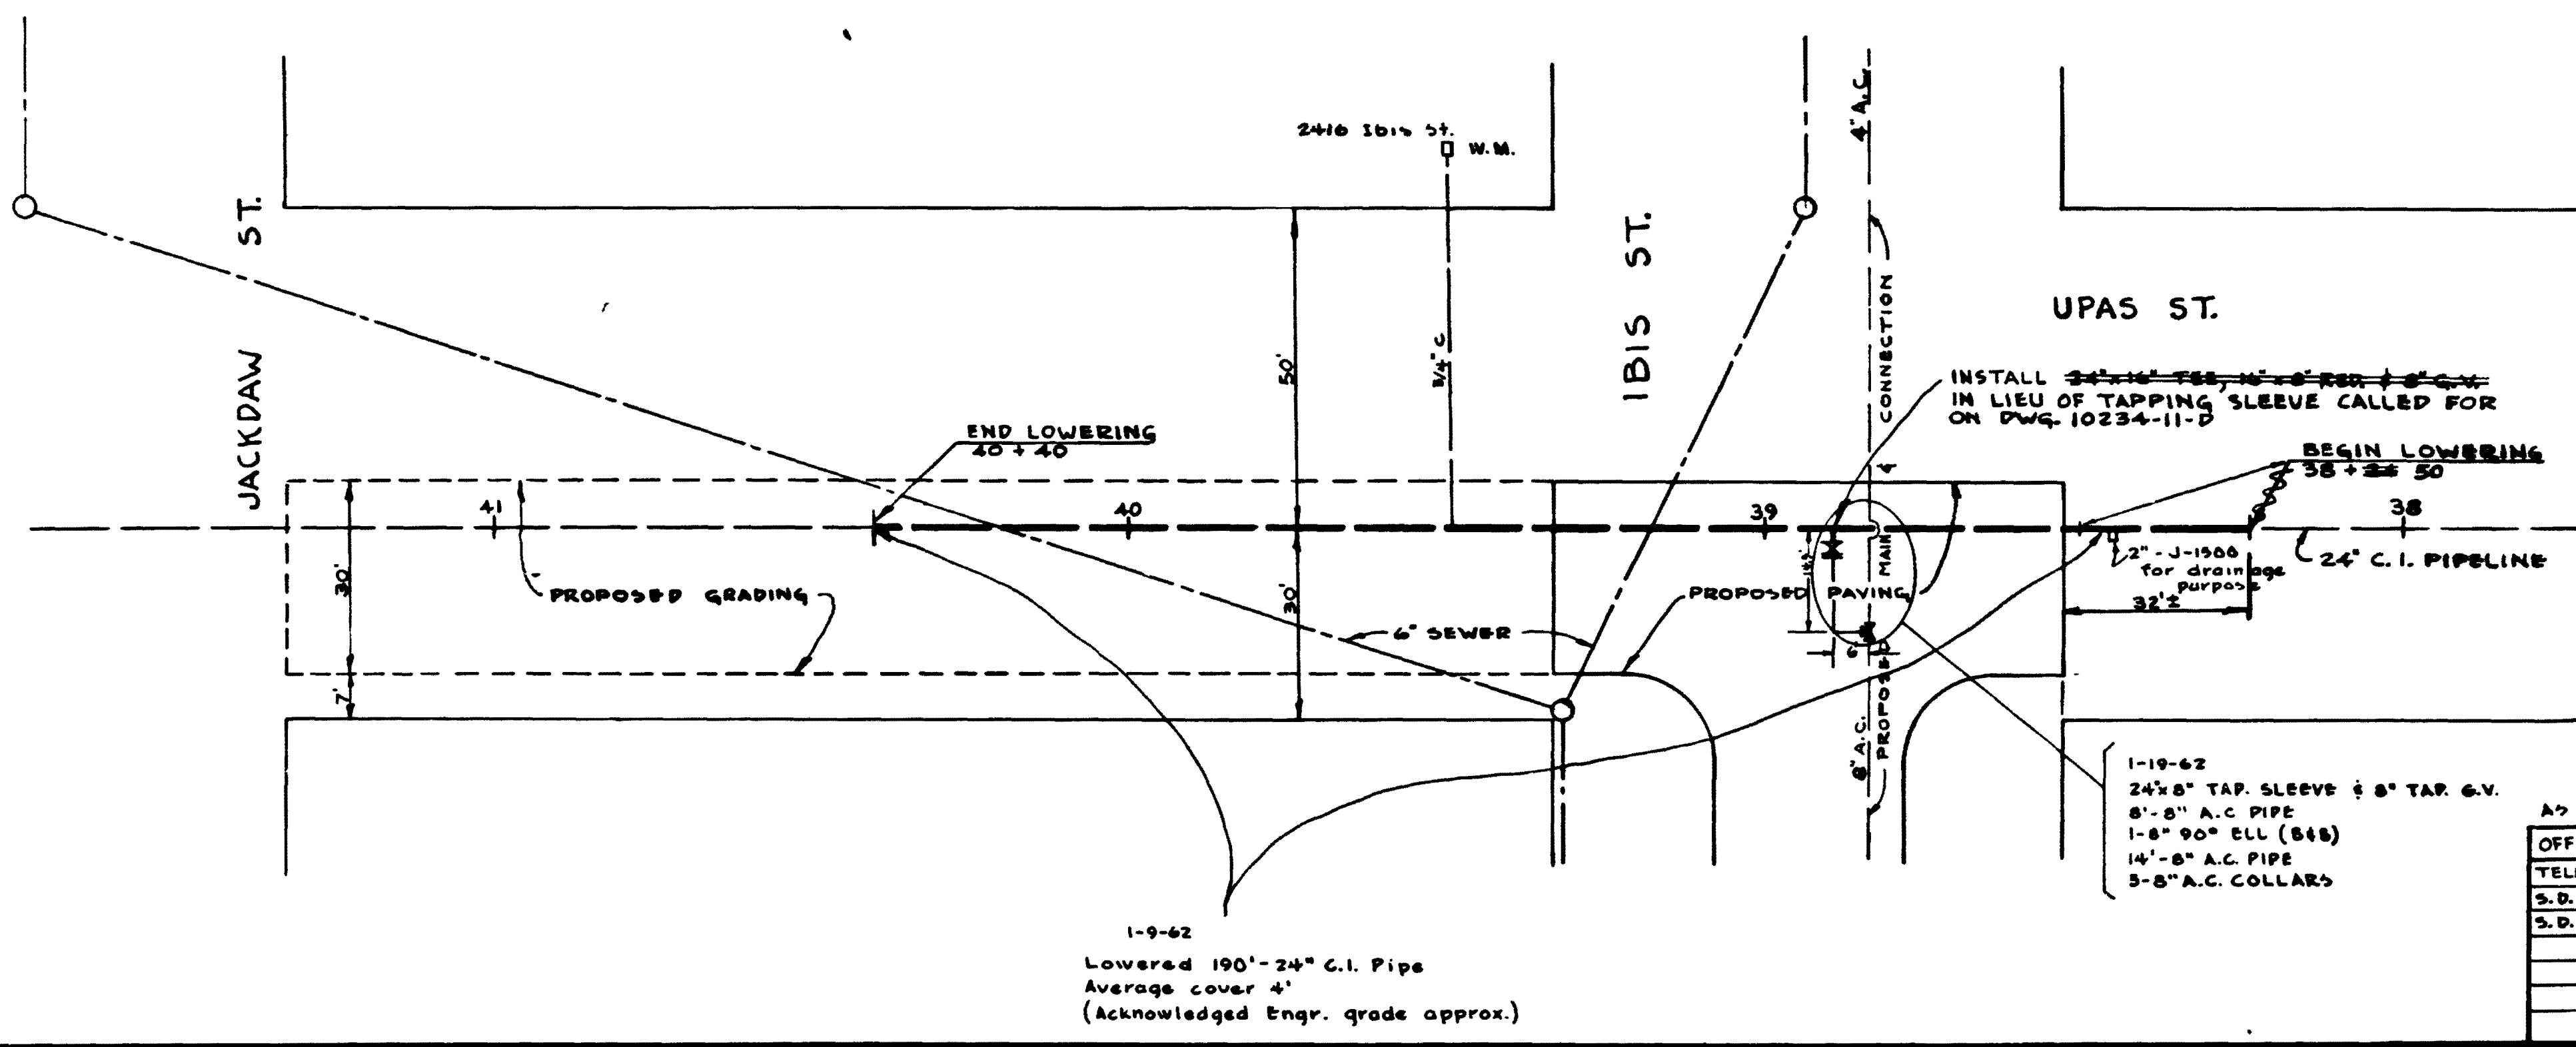


CITY DATUM  
170  
165  
160  
155  
150  
145

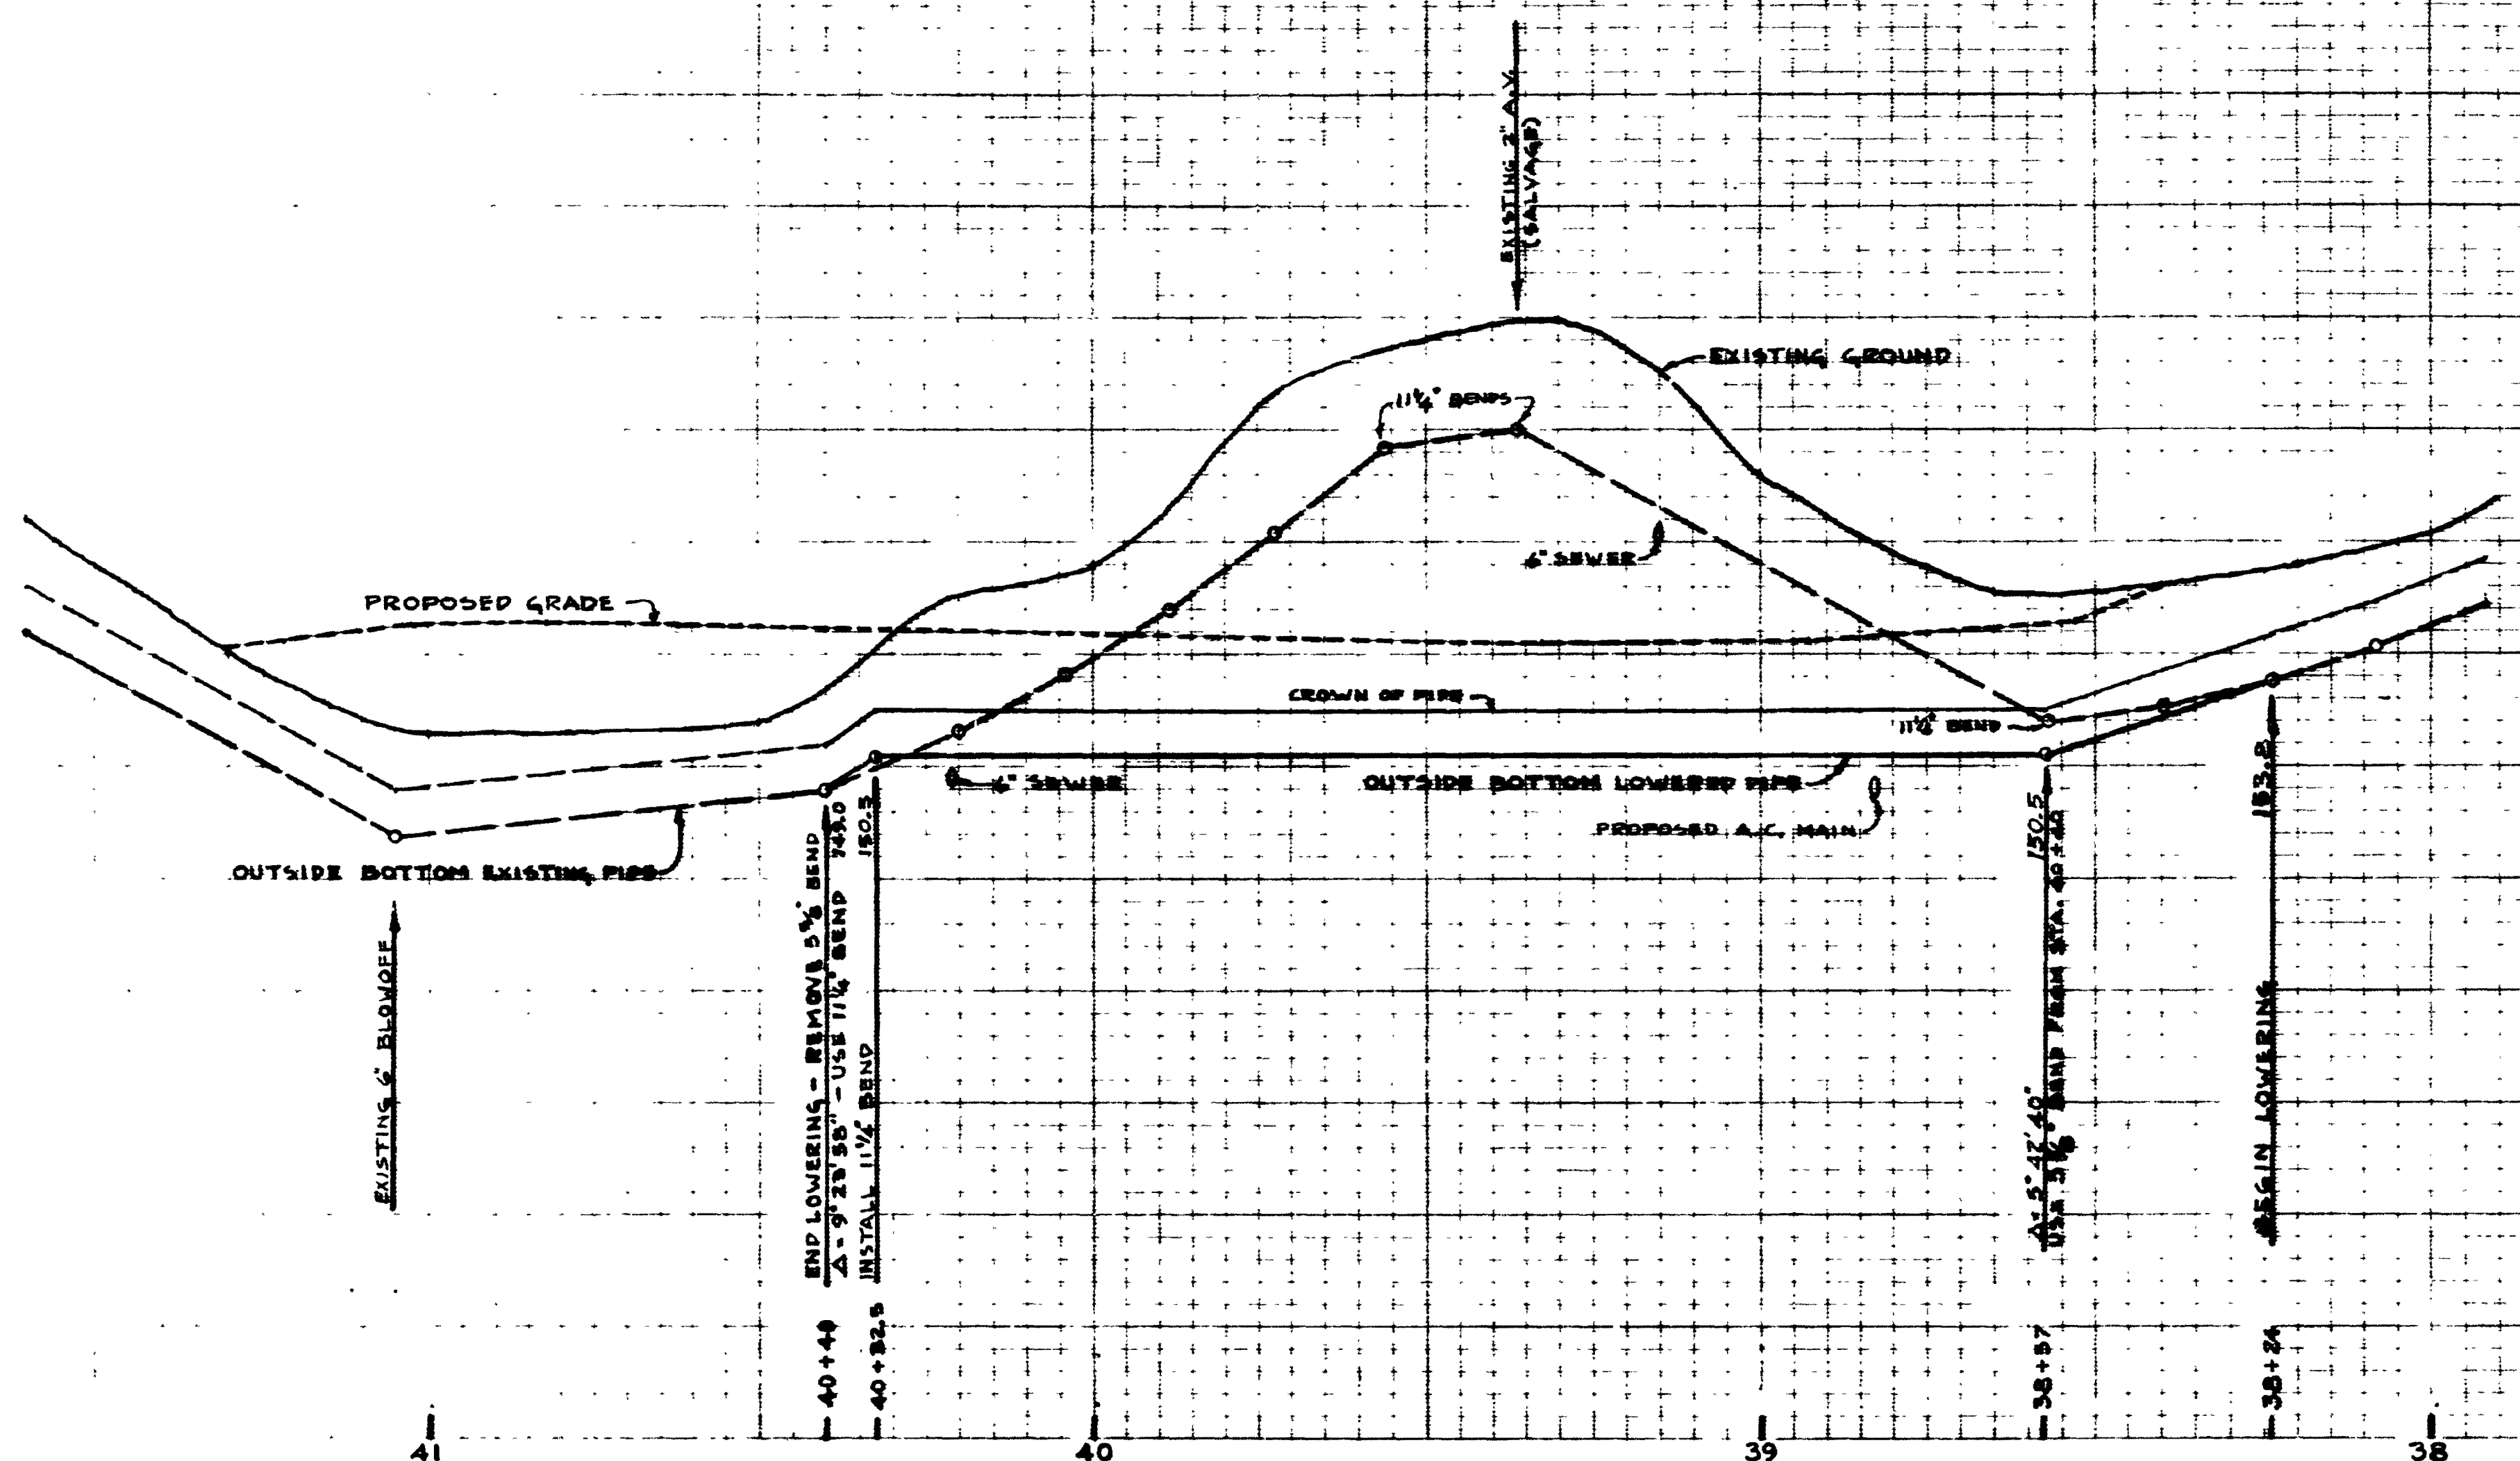

SCALE: 1" = 20' HORIZ.  
1" = 6' VERT.

REV DWG 5928-L & 10234-11-D CITY FORCE WORK

### UPAS STREET PIPELINE LOWERING AT IBIS STREET

CITY OF SAN DIEGO  
ENGINEERING DEPARTMENT

SHEET 1 OF 1 SHEETS  
W.D. NO. 48277

CHANGE	BY	DATE	APPROVAL

PLANNING REVISION: 8.7 Garrison 12/29/61

DATE STARTED	DATE COMPLETED	CONSTRUCTION RECORD	APPROVALS FOR

OFFICE CHECK	INITIAL	DATE
TELEPHONE CO.	PL	12/14/61
S.D. ELECTRIC CO.	P	12/21/61
S.D. GAS CO.	AK	12/21/61

WATER DEPT	SEWERAGE	PLANNING DEPT	DRAINAGE	ELECTRICAL	HIGHWAY	STRUCTURAL	GRADES	TRAFFIC	CONTROL

1-9-62  
Lowered 190'-24" C.I. Pipe  
Average cover 4'  
(Acknowledged Engr. grade approx.)

1-19-62  
24"x8" TAP SLEEVE & 8" TAP G.V.  
8"-8" A.C. PIPE  
1-8" 90° ELL (S16)  
14"-8" A.C. PIPE  
3-8" A.C. COLLARS

A7 BUILT 2-28-62 H.W.

10381-1 D

INDEXED  
JUN 1962