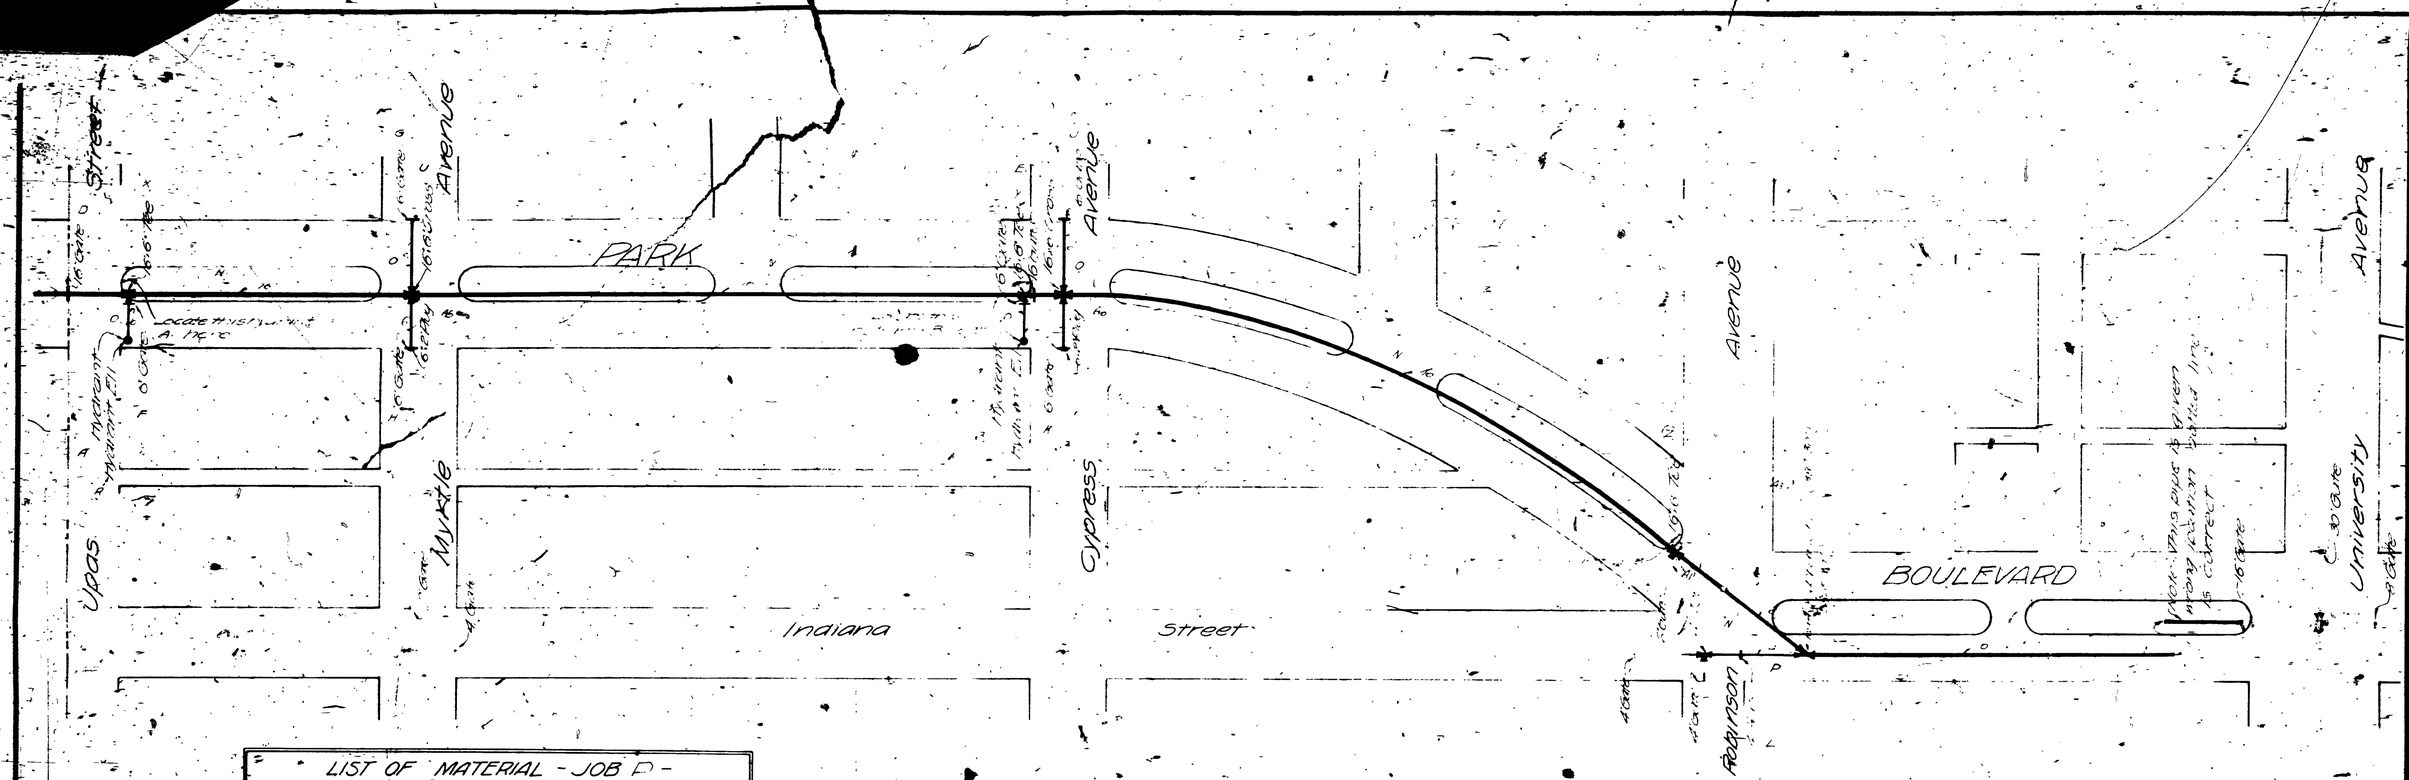

LIST OF MATERIAL - JOB P -

ITEM	NAME	SIZE	STREET	ORDER	INSPECTED	SET	REMARKS
A	Hydrant	6"-2 wo	Upas				
B	"	6"-2	Cypress				
D	Gate	16"	Upas				
E	"	16"	Cypress				
F	"	6"	Upas				Hydrant
G	"	6"	Myrtle				Lateral
H	"	6"	"				"
I	"	6"	Cypress				Hydrant
J	"	6"	"				Lateral
K	"	6"	"				"
L	"	4"	Robinson				
N	Pipe	16"	Pan. Boul				2628
O	"	6"	" "				408
P		4"	Indiana				120
R	Hyd. Ell.	6"	Upas				
S	" "	6"	Cypress				
U	Cross	16"x6"	Myrtle				
	"	16"x6"	Cypress				
X	Tee	16"x6	Upas				Hydrant
Y	"	16"x6"	Cypress				"
Z	"	16"x6	Robinson				"
A1	"	4"	"				
A3	Y Branch	16"x4"	Robinson				Y-38°30'
A5	Plug	6"x2"	Myrtle				
A6	"	6"x2"	Cypress				
A7							

REDUCED PLAN
USE SCALE BELOW
0 1 2 3 4
1 ON ORIGINAL SCALE

WATER DEPARTMENT
SAN DIEGO, CALIF.
PARK BOULEVARD Job P.
BETWEEN UNIVERSITY & PARK
SCALE 1"=100' DATE FEB. 5, 1913
APPROVED BY HYDRAULIC ENG. H. A. Whitney
APPROVED BY SUPERINTENDENT H. Ptay

A-8-L