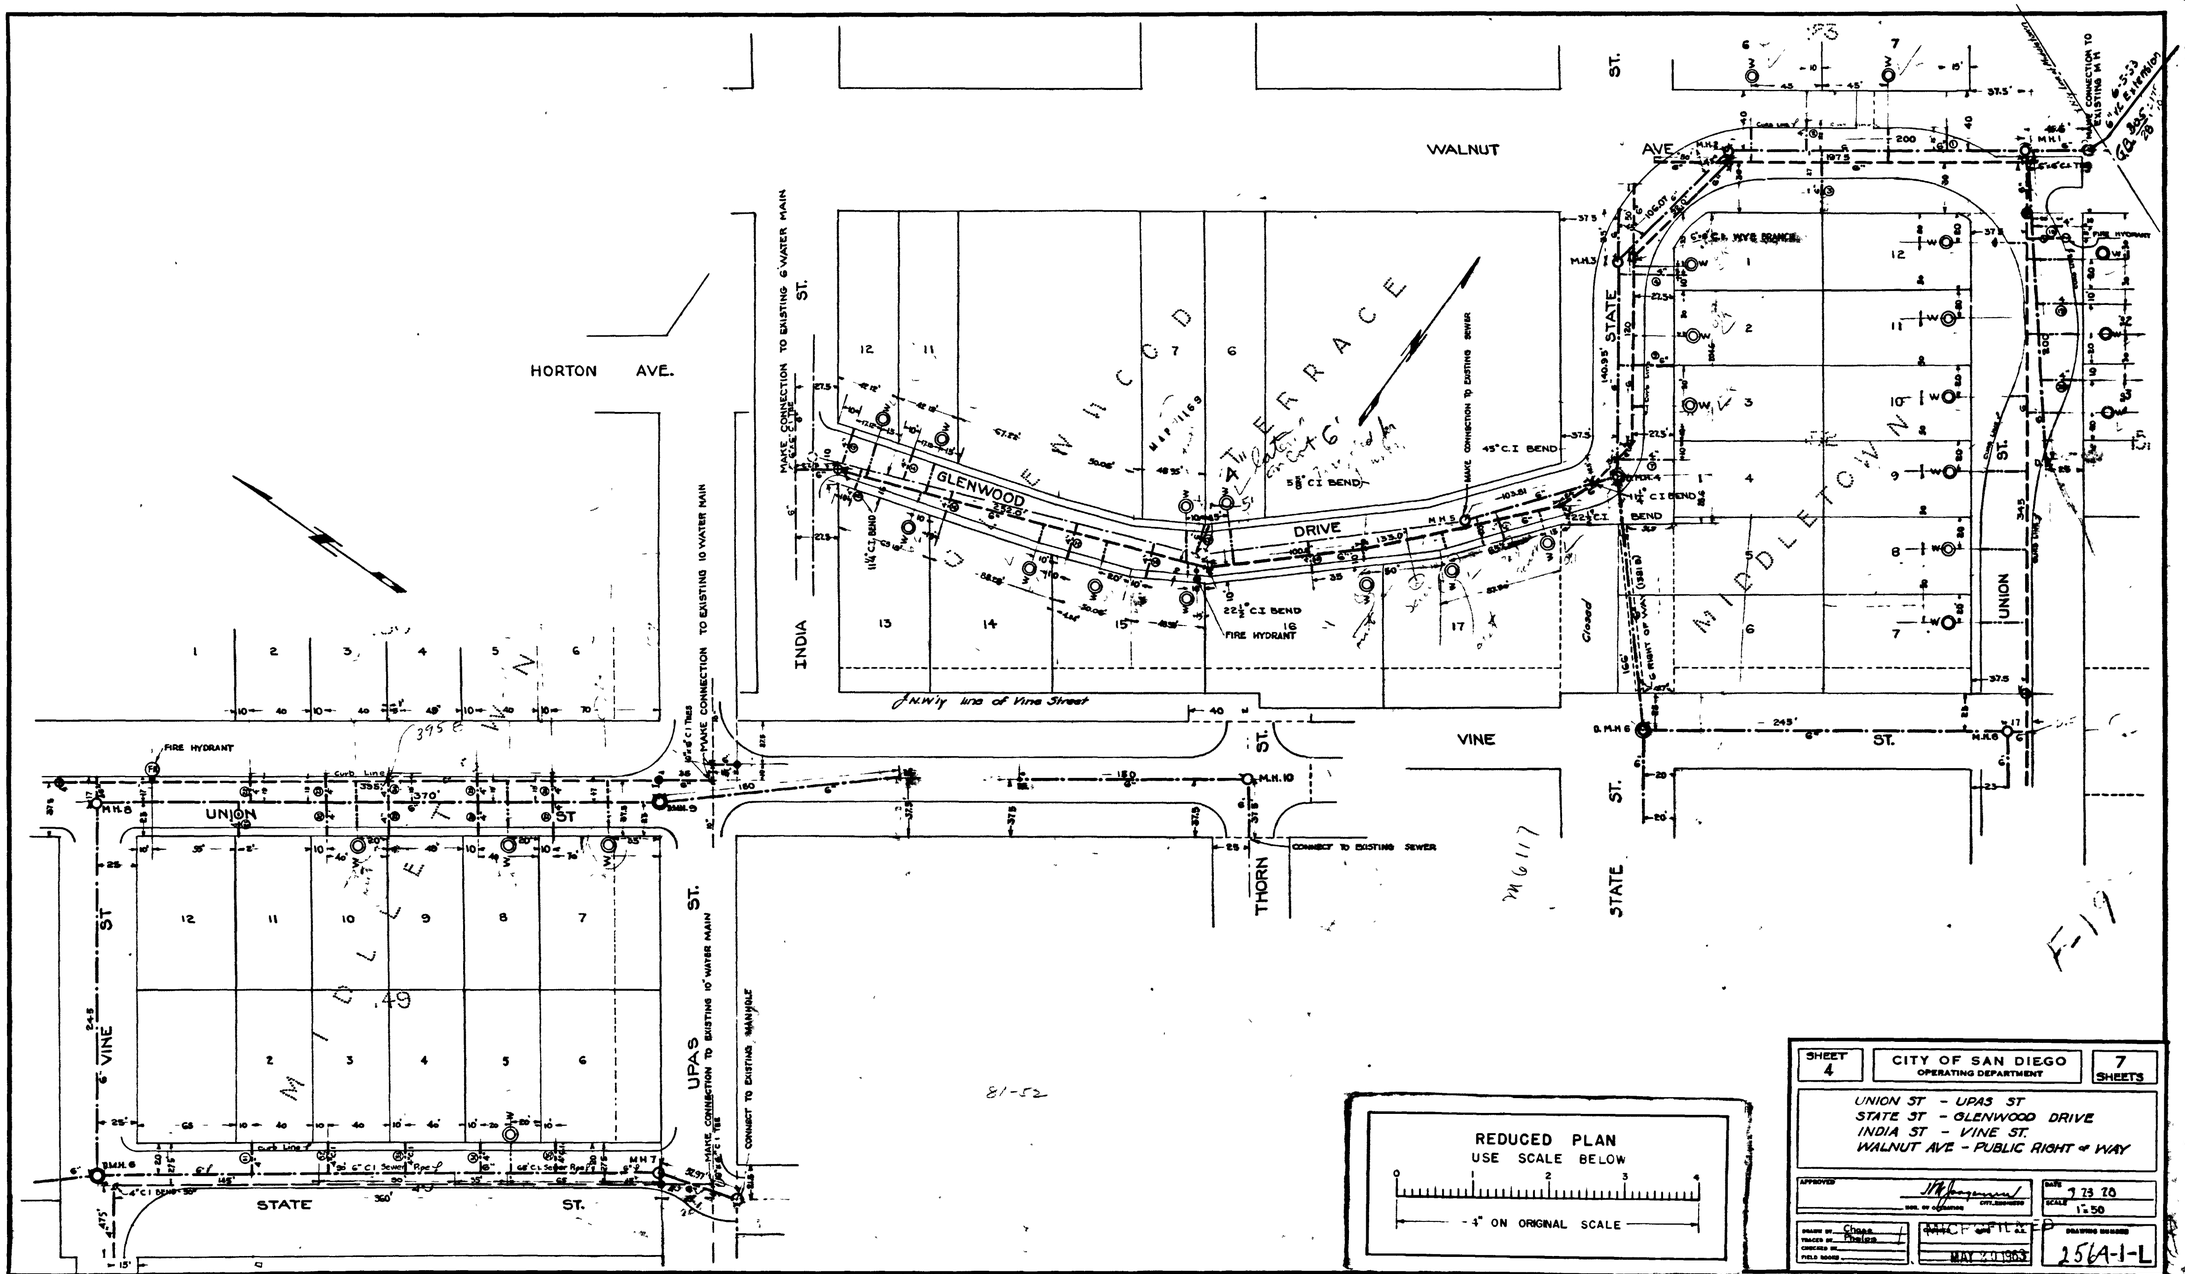
WALNUT AVE
HORTON AVE.
INDIA ST.
GLENWOOD DRIVE
GLENWOOD TERRACE
MIDDLETOWN
STATE ST.
UNION ST.
VINE ST.
THORN ST.
UPAS ST.
MAKE CONNECTION TO EXISTING 6" WATER MAIN
MAKE CONNECTION TO EXISTING 10" WATER MAIN
MAKE CONNECTION TO EXISTING SEWER
CONNECT TO EXISTING SEWER
CONNECT TO EXISTING MANHOLE
FIRE HYDRANT
N.W'ly line of Vine Street
REDUCED PLAN
USE SCALE BELOW
4" ON ORIGINAL SCALE
SHEET 4
CITY OF SAN DIEGO
OPERATING DEPARTMENT
7 SHEETS
UNION ST - UPAS ST
STATE ST - GLENWOOD DRIVE
INDIA ST - VINE ST.
WALNUT AVE - PUBLIC RIGHT of WAY
DATE 9 23 28
SCALE 1"=50
DRAWING NUMBER 256A-1-L
MAY 20 1963
F-19