


CONTRACTOR: ROYAL PIPELINE CO.  
 CONSTRUCTED: MAY 11, 1955  
 PIPE: 6" ASBESTOS CEMENT, CLASS 150 - FURNISHED BY CONTR.  
 VALVES & FITTINGS: " "  
 TEST PRESSURE: VISUAL 225 p.s.i.  
 WORK DONE BY CONTR. ON W.O. 26644  
 " " " CITY " W.O. 26645

BENCH MARK:  
 B.M. - S.E.S.P. India & Upas  
 Elev. 83.93'

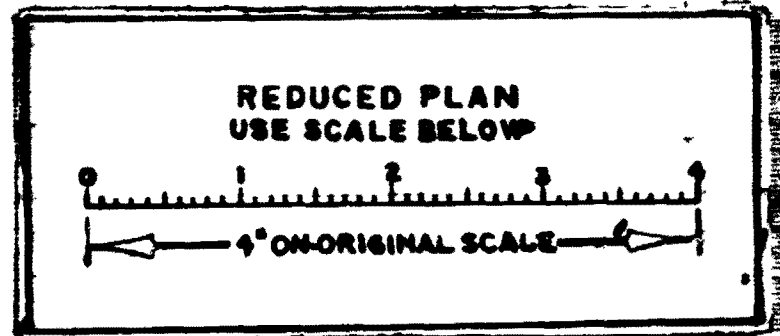

LEGEND


	Proposed water main
	Proposed gate valve
	Existing tee, G.V. & cross
	water service lateral
	Fire hydrant assembly
	Gas main
	Sewer main & manhole
	Pavement
	Barricade

OFFICE CHECK	INITIAL	DATE
County Surveyor		
City Engineer	CRL	8-1-54
S. D. Gas & Electric Co.	ARW	8-2-54
City Engineer	W.A.	8-2-54
Street Grades		
Water Distribution		
Public Works		
Field (City Engr.)	EFB	8/1/54

Ref. Page:  
 Profile 106,  
 5525-L (Upas St. P.L. Ext.),  
 Gate No. 1-47,  
 Sewer No. 1, Sht. 20,  
 Sewer No. 5, Shts. 494, 496,  
 Gas No. 2, Sht. 123, 126.

SPEC NO 63

CITY OF SAN DIEGO CALIFORNIA WATER DEPARTMENT			
SMALL WATER MAIN REPLACEMENTS, 1953-54			
COLUMBIA STREET 6" A C MAIN THORN STREET TO UPAS STREET			
RECOMMENDED:	APPROVED:		
<i>W.C. Brown</i>	<i>W.C. Brown</i>		
ENGINEER	DIRECTOR		
DATE: JULY, 1954	TRACED:	DATE: CITY	CHECKED:
DRANN, R.R.R.	SCALE: 1" = 50' HORIZONTAL 1" = 6' VERTICAL		
GROUP 16	SHEET 1 OF 1 SHEETS DWG NO 6500-W		

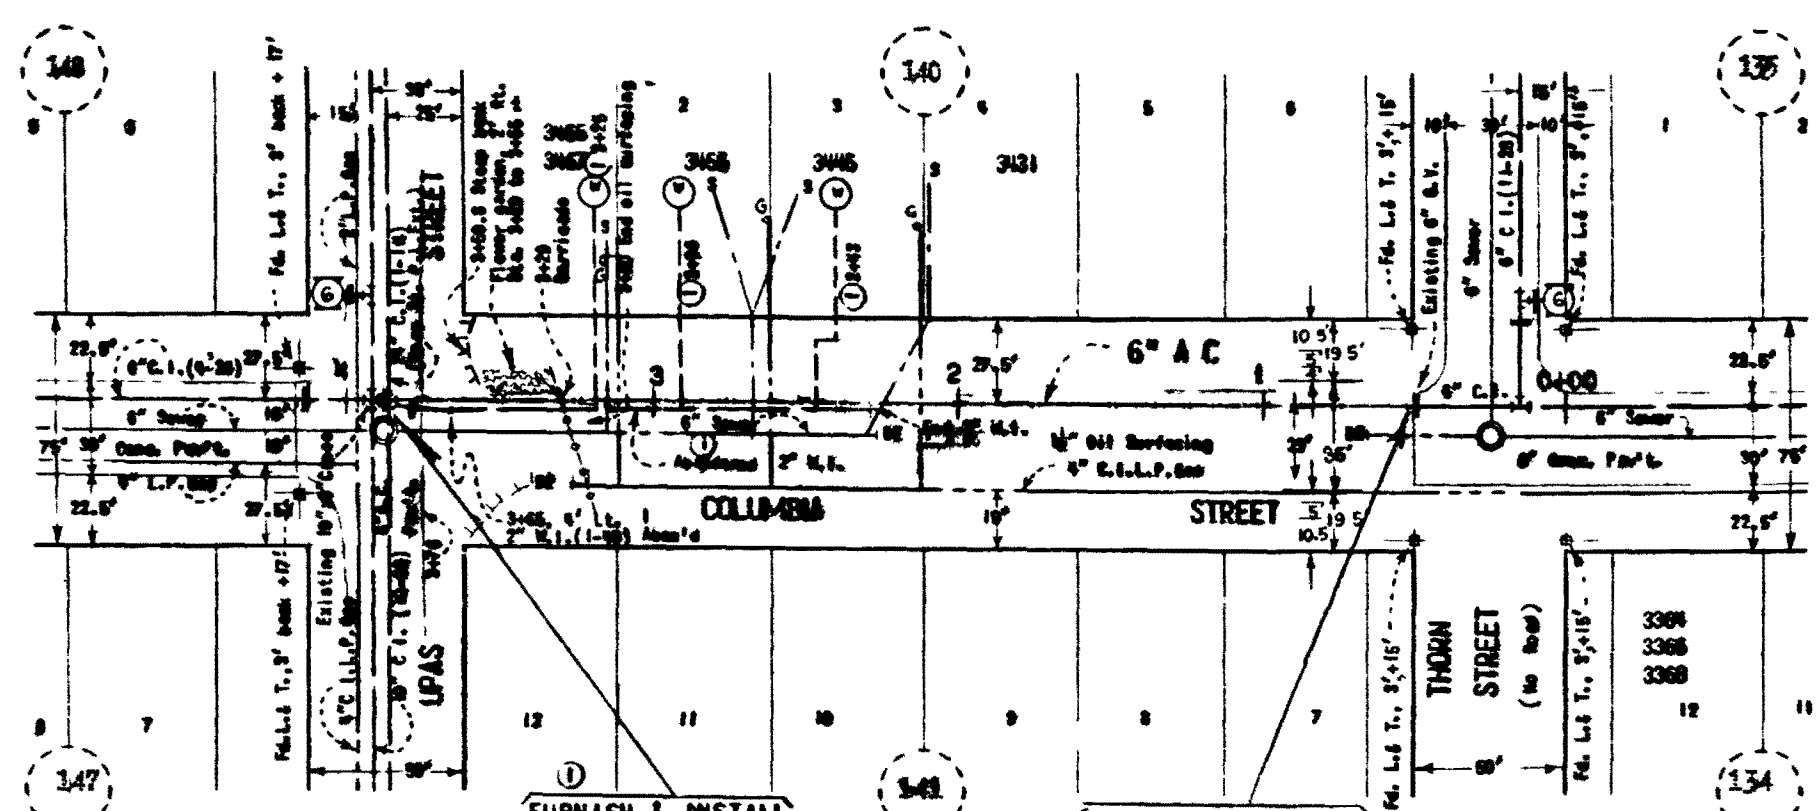

FURNISH & INSTALL  
 BY CITY:  
 STA. 3+06±  
 1-6" G.V.  
 7'-6" A.C. PIPE  
 2-6" 11 1/2" BENDS USED  
 TO MAKE GRADE OF EXISTING PIPE

BY CITY:  
 CONNECTED TO NEW  
 MAIN WITH 4"-6"  
 A.C. PIPE

JACKSON PART 3A MAP