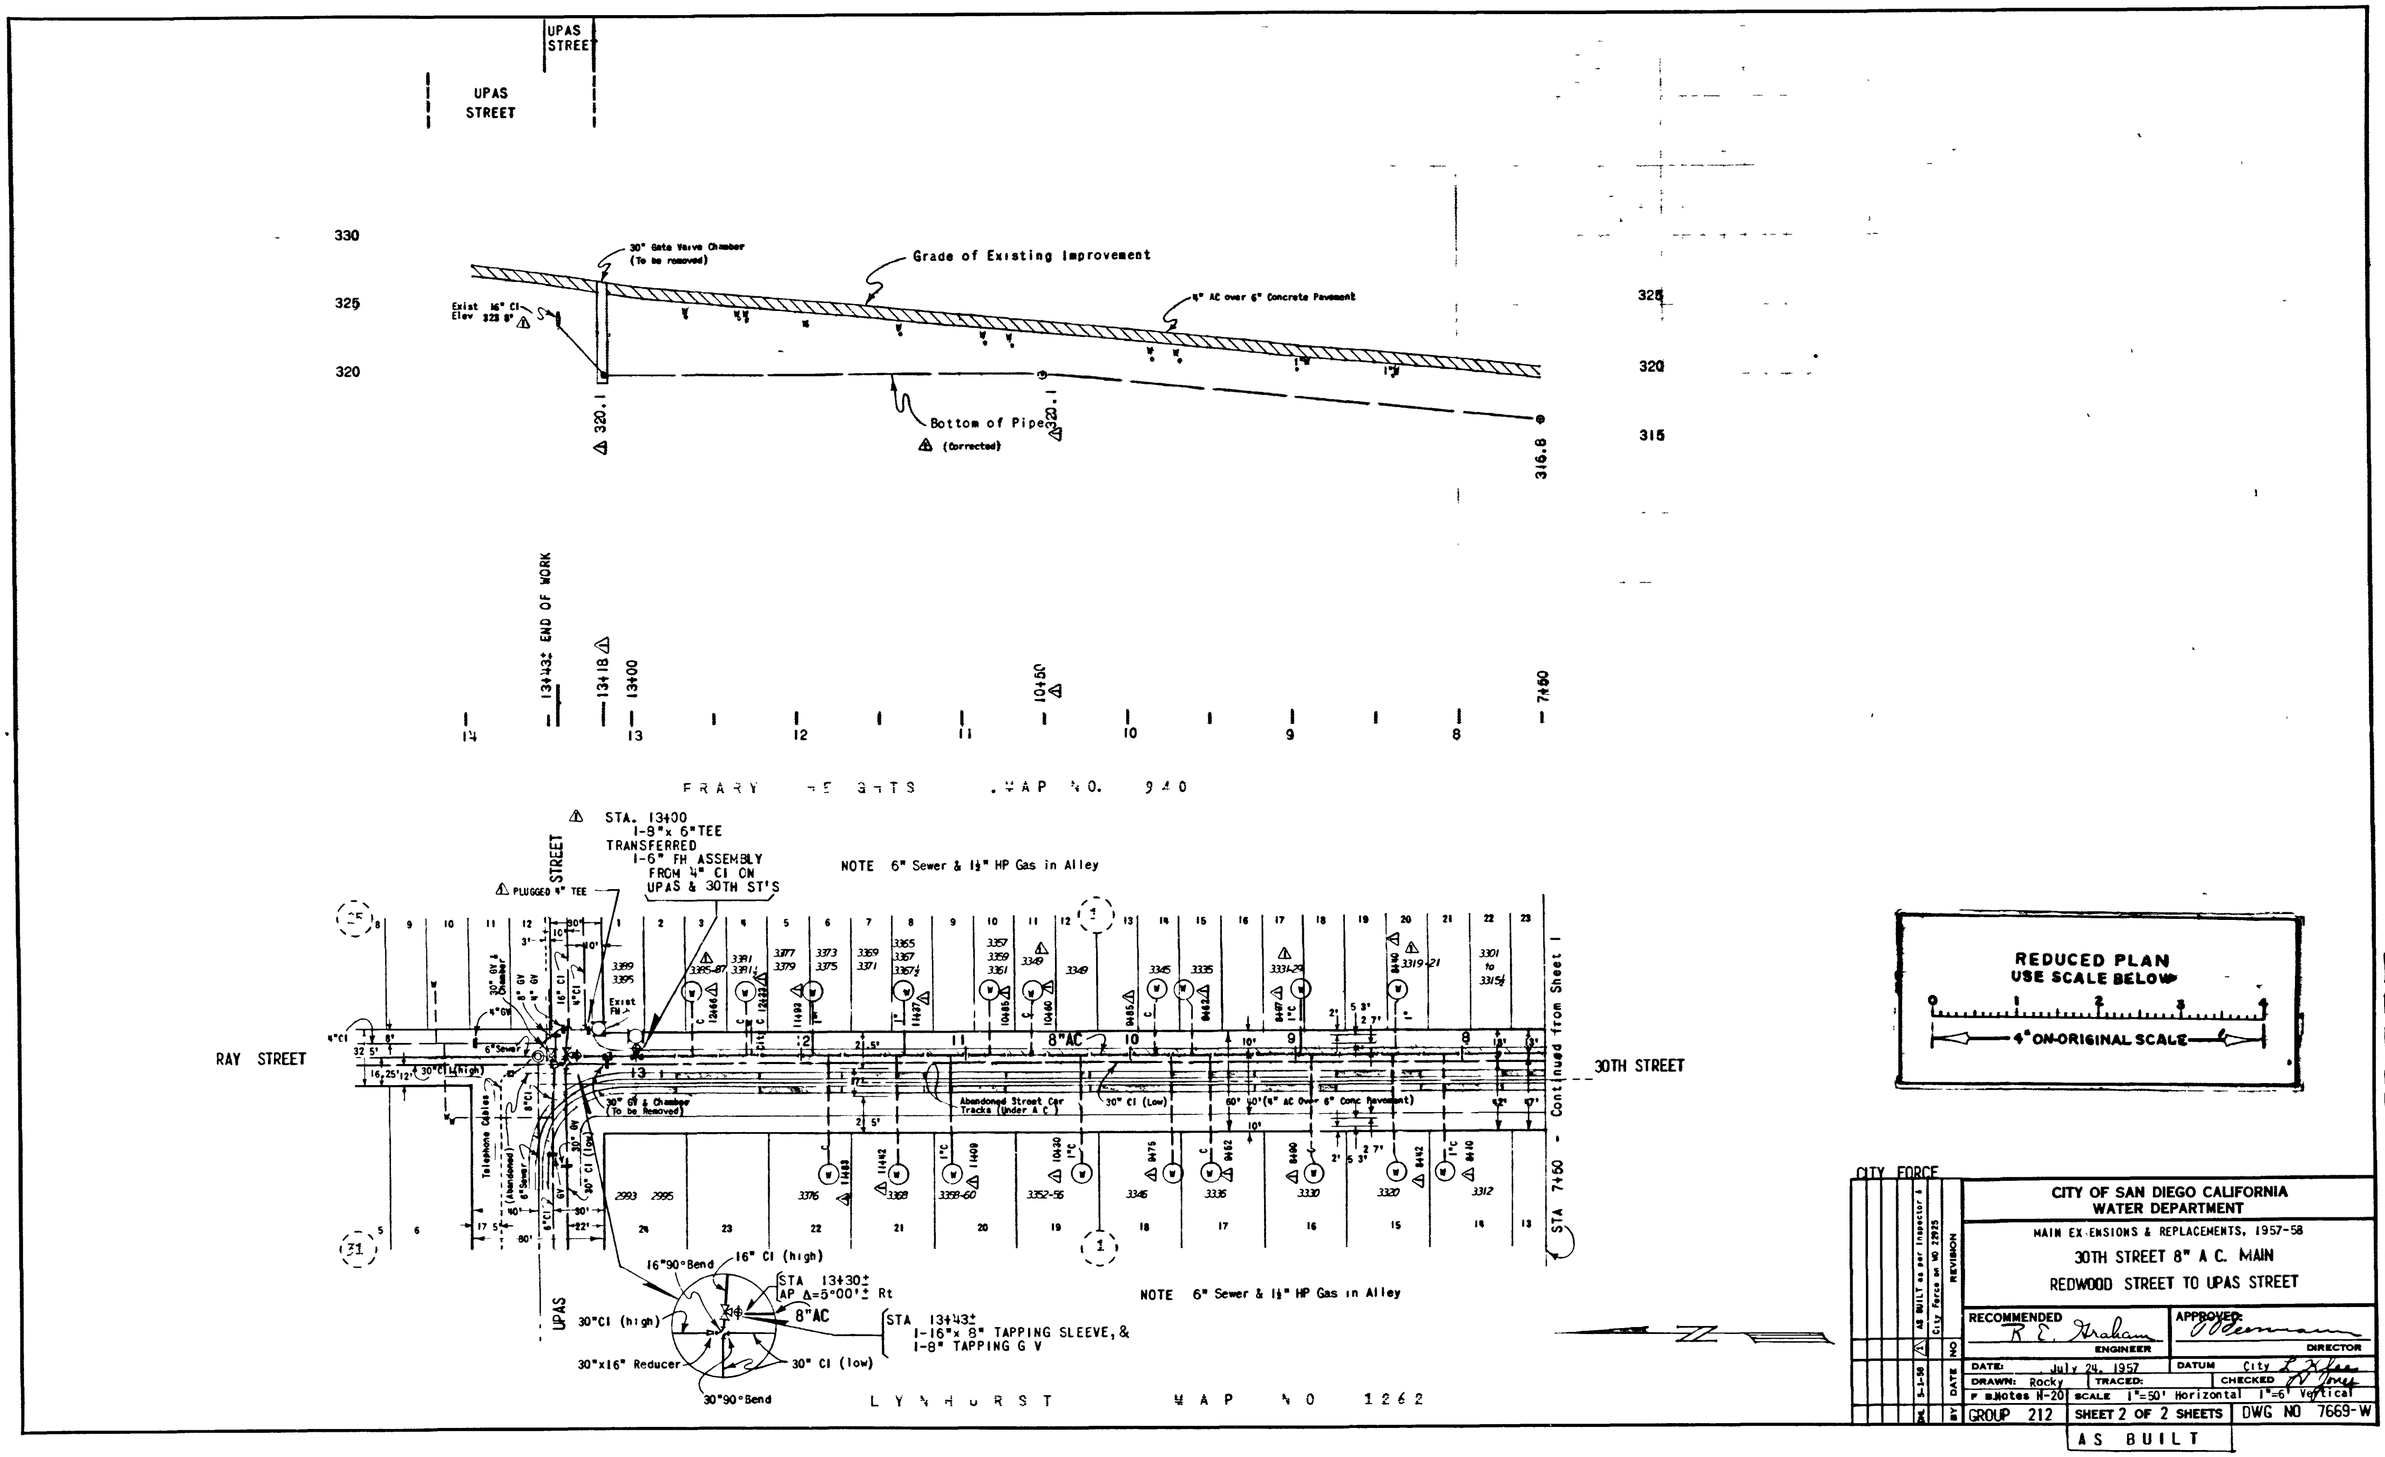

CITY FORCE

NO	DATE	REVISION
1	5-1-58	AS BUILT as per Inspector & City Force on WO 22925

CITY OF SAN DIEGO CALIFORNIA
WATER DEPARTMENT

MAIN EXTENSIONS & REPLACEMENTS, 1957-58

30TH STREET 8" A C. MAIN
REDWOOD STREET TO UPAS STREET

RECOMMENDED R. E. Graham ENGINEER
APPROVED DIRECTOR

DATE: July 24, 1957 DATUM City
DRAWN: Rocky TRACED: CHECKED
F. Notes H-20 SCALE 1"=50' Horizontal 1"=6' Vertical
GROUP 212 SHEET 2 OF 2 SHEETS DWG NO 7669-W
AS BUILT

MICROFILMED
JAN 29 1964