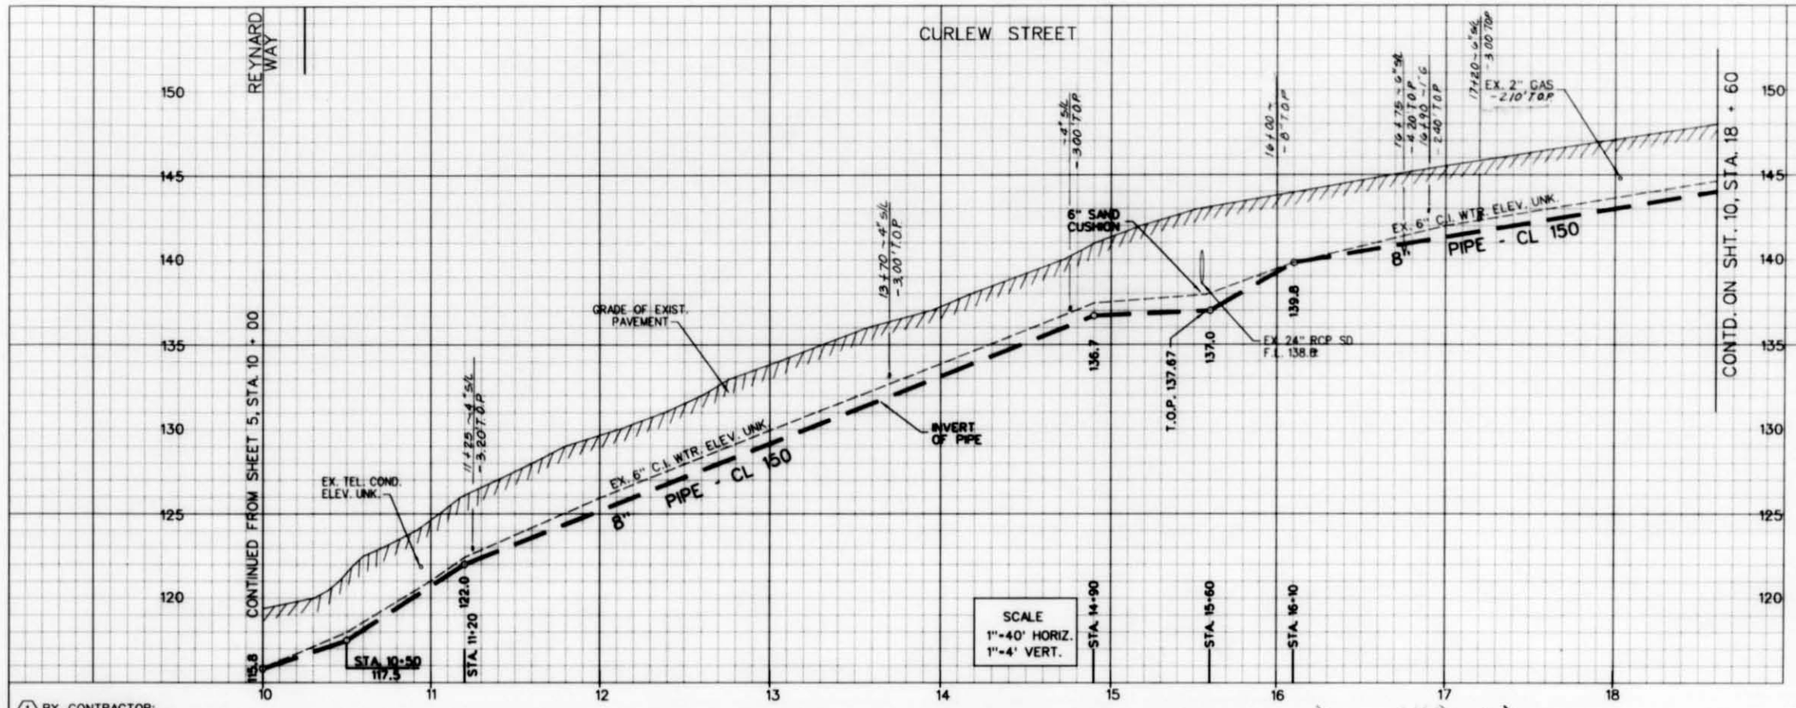

NOTE: MINIMUM 3' COVER ON TOP OF PIPE

PROPOSED PIPE DATA TABLE				
NO.	Δ /BEARING	RADIUS	LENGTH	REMARKS
1	N69°54'21"W		13.29'±	8" PIPE BY CONTRACTOR
2	N89°47'42"W		129.76'	8" PIPE BY CONTRACTOR
3	N53°24'40"E		167.80'	8" PIPE BY CONTRACTOR
4	N35°39'54"E		238.33'	8" PIPE BY CONTRACTOR
5	N24°43'30"E		256.21'	8" PIPE BY CONTRACTOR
6	N00°27'24"W		62.16'	8" PIPE BY CONTRACTOR

COORDINATE TABLE			
NO.	NORTHING	EASTING	DESCRIPTION
SHP2	210081.9015	1717701.2302	22½° BEND
SHP3	210081.8342	1717720.0429	TEE
SHP4	210081.4371	1717830.9900	22½° & 11¼° BEND
SHP5	210181.4593	1717965.7241	22½° BEND
SHP6	210375.0894	1718104.6825	11¼° BEND
SHP7	210398.0716	1718115.2652	TEE
SHP8	210607.8163	1718211.8474	22½° BEND

REFERENCE:

BENCH MARK: SWBP REYNARD WAY AND OTSEGO DRIVE
ELEVATION = 138.566 MSL
FIELD NOTES: WENWORTH 3-16-89, W.O. 181021W, 1715915
INDEX 210-1716
WATER: 2126-L, 2127-1-L
SEWER: 7062-2-D, 7063-3-D, 7064-4-D, 1034-3-D, 1035-4-D, 2126-L, 2127-1-L, 2127-L
STORM DRAIN: 366-L, 367-1-L, 2126-L, 2127-L, 10802-2-D, 13602-3-D, 13602-4-D,
GAS: 2-155, 2-157A, 2-184A
ELECTRIC: 210-1717.5
CABLE TV: 210-716
TELEPHONE: 184008
IMPROVEMENTS:
WATER GATE BOOK: F-19
SEWER GATE BOOK: F-19
100' SCALE: 210-1716
THOMAS BROS.: 1268, J-6

NOTE:
CURLEW STREET
REYNARD WAY TO SLOANE AVE., SHALL BE HIGHLINED BY CITY FORCES PRIOR TO START OF CONSTRUCTION. CITY TO FURNISH HIGHLINING MATERIAL AND MAKE ALL CONNECTIONS.

RETIREMENT:

850' 6" C.I. 1927
1- 6" F.H. 1927
850' 6" CONC. PIPE (ABANDON)

(1) BY CONTRACTOR:
FURNISH & INSTALL
STA. 10 + 05.74
1- 8" 22½° BEND (MJ)

(2) BY CONTRACTOR:
FURNISH & INSTALL
STA. 10 + 24.55
1- 8"X6" TEE (MJ,MJ,F)
1- 6" F.H. ASSEMBLY (W-10)

(3) BY CONTRACTOR:
FURNISH & INSTALL
STA. 11 + 35.50
1- 8" 22½° BEND (MJ,F)
1- 8" 11¼° BEND (F,MJ)

(4) BY CONTRACTOR:
FURNISH & INSTALL
STA. 13 + 03.30
1- 8" 22½° BEND (MJ)

(5) BY CONTRACTOR:
FURNISH & INSTALL
STA. 15 + 41.63
1- 8" 11¼° BEND (MJ)

(6) BY CONTRACTOR:
FURNISH & INSTALL
STA. 15 + 66.93
1- 8"X6" TEE (MJ,MJ,F)
1- NEW 6" F.H. ASSEMBLY (W-10)

(7) BY CONTRACTOR:
FURNISH & INSTALL
STA. 17 + 97.84
1- 8" 22½° BEND (MJ)

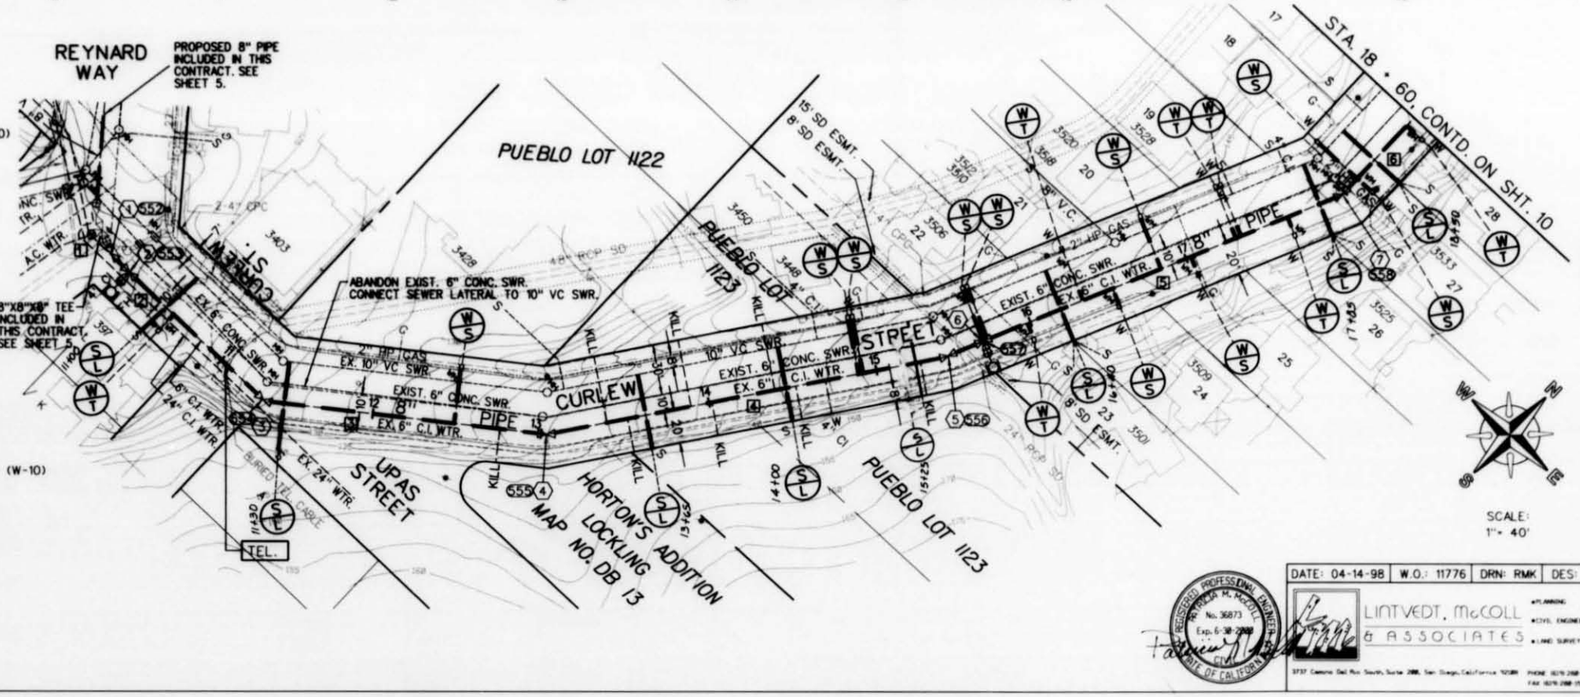

DATE: 04-14-98 | W.O.: 11776 | DRN: RMK | DES: KM

LINTVEDT, McCOLL & ASSOCIATES

WATER AND SEWER GROUP 487

CURLEW STREET

REYNARD WAY TO S/O BROOKES AVENUE
MIDDLETOWN AREA

CITY OF SAN DIEGO, CALIFORNIA
ENGINEERING & CAPITAL IMPROVEMENTS DEPARTMENT
SHEET 9 OF 62 SHEETS

WATER W.O. 181021
SEWER W.O. 171331

APPROVED: for DEPUTY DIRECTOR — DATE 4/30/98
SECTION HEAD
ASSOCIATE ENGINEER

DESCRIPTION	BY	APPROVED	DATE	FILMED
ORIGINAL	LMA			
AS-BUILT	LMA		4/13/05	05 07-08

CONTROL CERTIFICATION: 210-1716
NAD83 COORDINATES: 25858-9-D

CONTRACTOR ORION CONSTR. DATE STARTED 02-09-99
INSPECTOR MICHAEL NINN DATE COMPLETED 12-15-00

AS - BUILT

CURLEW STREET

f: \ustation\776\776-09wr.dgn
plot @ 1"=40'

FILMED FROM THE ORIGINAL. BEST QUALITY OBTAINABLE. EXCESSIVE GRAY BACKGROUND MAY CAUSE A POOR QUALITY REPRODUCTION.