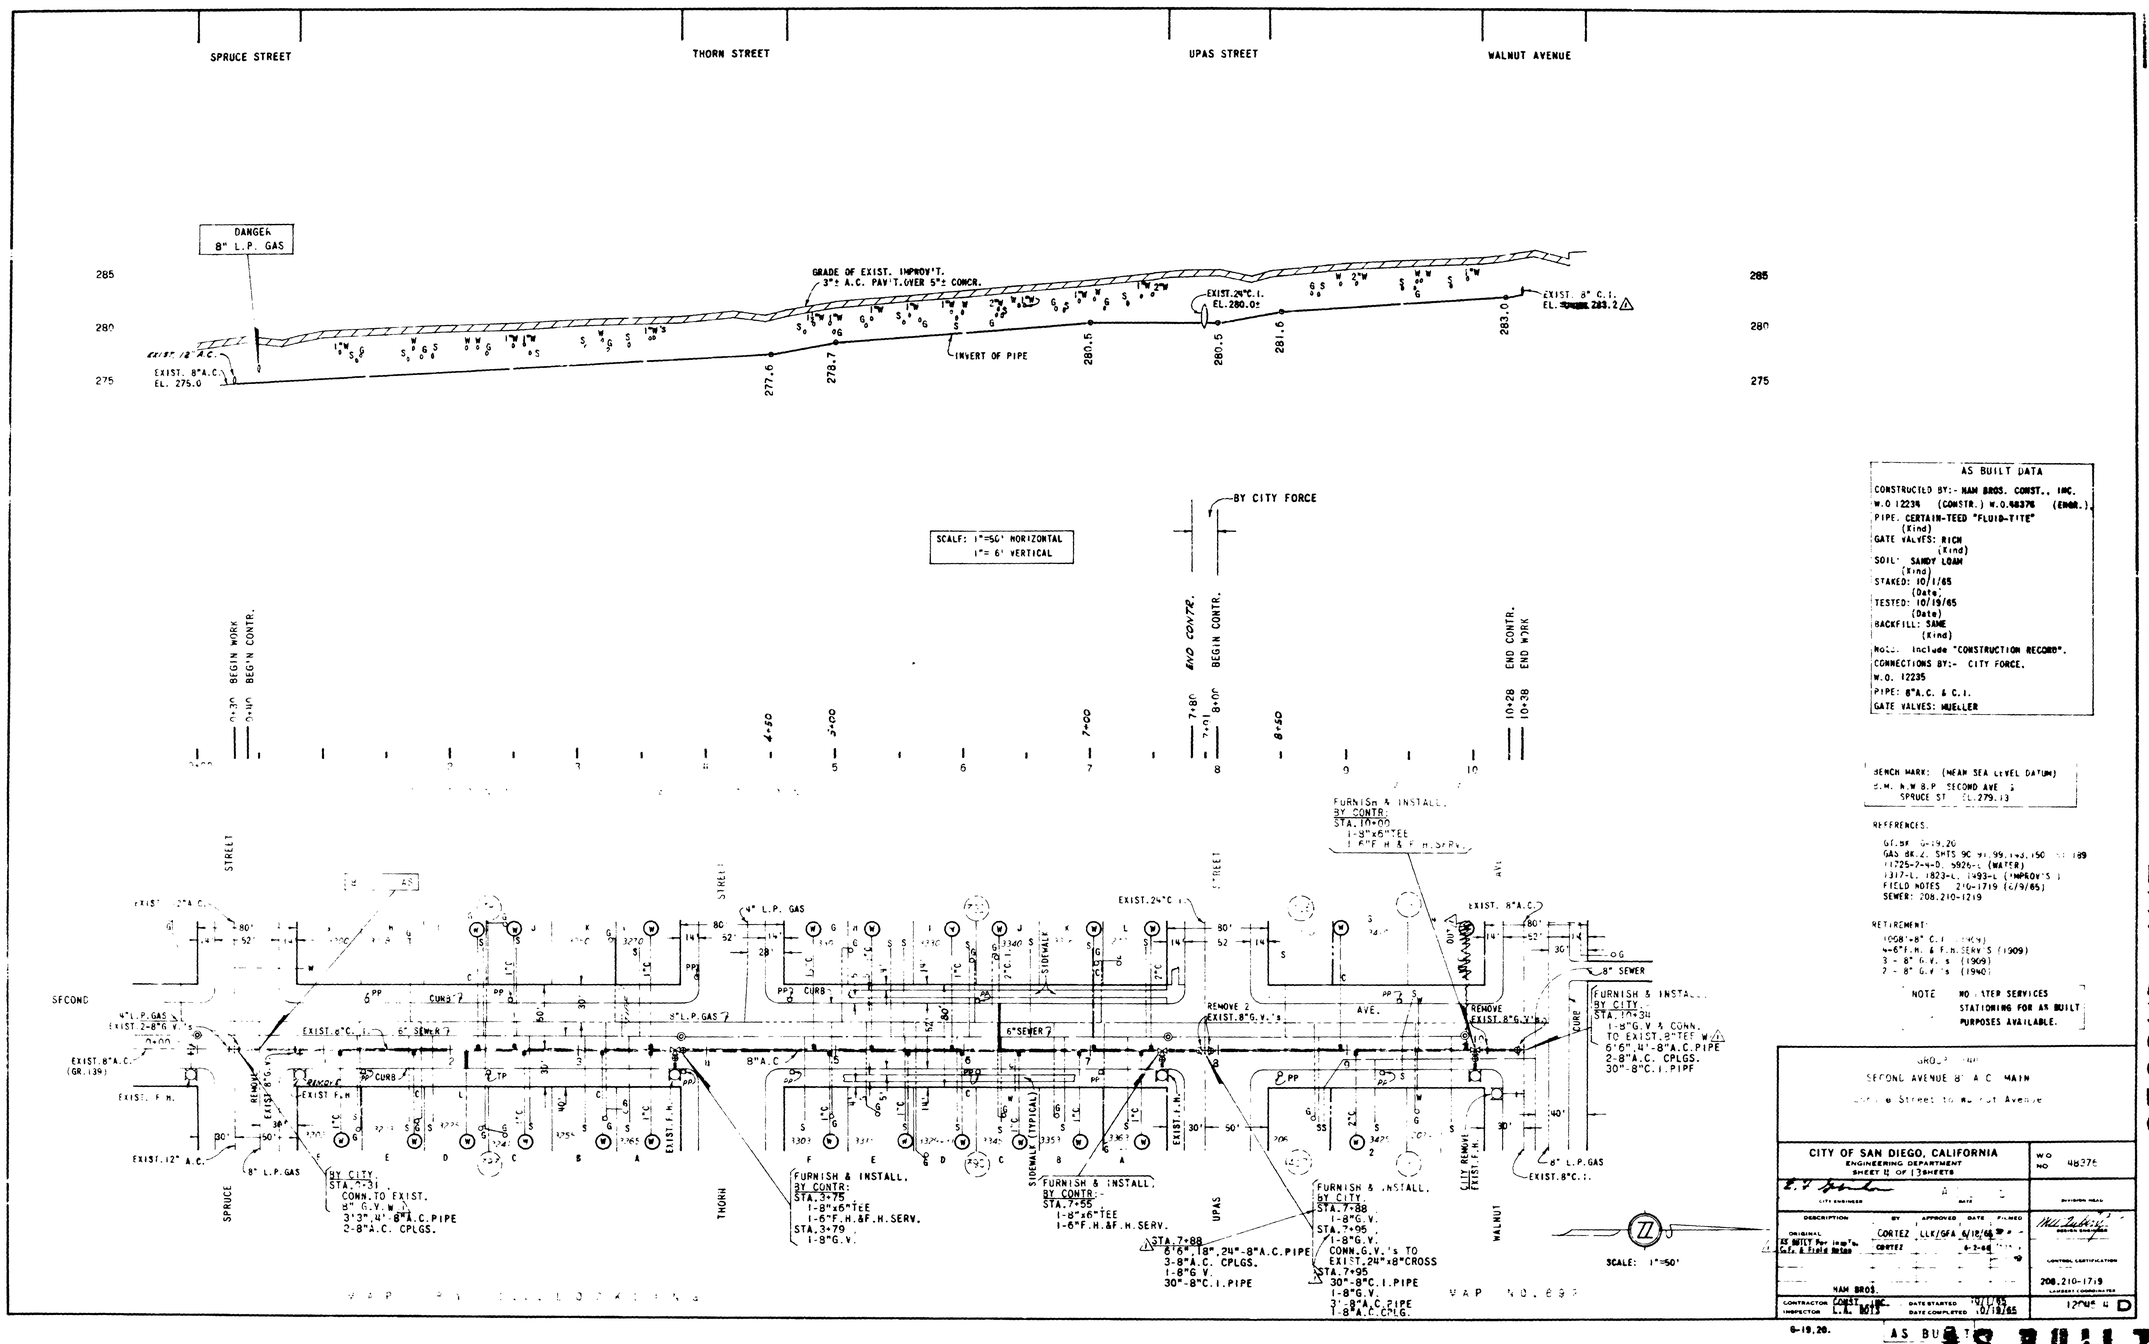
SPRUCE STREET
THORN STREET
UPAS STREET
WALNUT AVENUE
DANGER
8" L.P. GAS
GRADE OF EXIST. IMPROV'T.
3"± A.C. PAV'T. OVER 5"± CONCR.
EXIST. 24"C.I.
EL. 280.0±
EXIST. 8" C.I.
EL. 283.2
EXIST. 12" A.C.
EXIST. 8"A.C.
EL. 275.0
INVERT OF PIPE
277.6
278.7
280.5
280.5
281.6
283.0
285
280
275
SCALE: 1"=50' HORIZONTAL
1"= 6' VERTICAL
BY CITY FORCE
END CONTR.
BEGIN CONTR.
BEGIN WORK
END CONTR.
END WORK
SECOND
SPRUCE
THORN
UPAS
WALNUT
AVE.
4" L.P. GAS
8" SEWER
6" SEWER
8"A.C.
CURB
SIDEWALK
EXIST. F.H.
EXIST. 12" A.C.
8" L.P. GAS
EXIST. 8"C.I.
REMOVE & EXIST. 8"G.V.'s
FURNISH & INSTALL. BY CITY. STA. 10+34 1-8"G.V. & CONN. TO EXIST. 8"TEE W 6"6", 4"-8"A.C. PIPE 2-8"A.C. CPLGS. 30"-8"C.I. PIPE
FURNISH & INSTALL. BY CITY. STA. 3+75 CONN. TO EXIST. 8" G.V.W. 3'3", 4"-8"A.C. PIPE 2-8"A.C. CPLGS.
FURNISH & INSTALL. BY CONTR: STA. 3+75 1-8"x6"TEE 1-6"F.H.&F.H.SERV. STA. 3+79 1-8"G.V.
FURNISH & INSTALL. BY CONTR:- STA. 7+55 1-8"x6"TEE 1-6"F.H.&F.H.SERV.
FURNISH & INSTALL. BY CONTR. STA. 7+80 1-8"x6"TEE 1-6"F.H.&F.H.SERV.
STA. 7+88 6"6", 18", 24"-8"A.C. PIPE 3-8"A.C. CPLGS. 1-8"G.V. 30"-8"C.I. PIPE
FURNISH & INSTALL. BY CITY. STA. 7+88 1-8"G.V. STA. 7+95 1-8"G.V. CONN. G.V.'s TO EXIST. 24"x8"CROSS STA. 7+95 30"-8"C.I. PIPE 1-8"G.V. 3'-8"A.C. PIPE 1-8"A.C. CPLG.
SCALE: 1"=50'
AS BUILT DATA
CONSTRUCTED BY:- NAM BROS. CONST., INC.
W.O. 12234 (CONSTR.) W.O. 48376 (ENGR.)
PIPE: CERTAIN-TEED "FLUID-TITE"
GATE VALVES: RICH
SOIL: SANDY LOAM
STAKED: 10/1/65
TESTED: 10/19/65
BACKFILL: SAME
NOTE: Include "CONSTRUCTION RECORD".
CONNECTIONS BY:- CITY FORCE.
W.O. 12235
PIPE: 8"A.C. & C.I.
GATE VALVES: MUELLER
BENCH MARK: (MEAN SEA LEVEL DATUM)
B.M. N.W. B.P. SECOND AVE. & SPRUCE ST. EL. 279.13
REFERENCES.
GAS 8K.2. SHTS 9C 99.143.150
11725-2-4-D 5926-L (WATER)
1317-L 1823-L 1493-L (IMPROV'S)
FIELD NOTES 210-1719 (6/9/65)
SEWER: 208.210-1219
RETIREMENT:
1-8"G.V.'s (1909)
NOTE NO WATER SERVICES STATIONING FOR AS BUILT PURPOSES AVAILABLE.
SECOND AVENUE 8" A.C. MAIN
Spruce Street to Walnut Avenue
CITY OF SAN DIEGO, CALIFORNIA
ENGINEERING DEPARTMENT
SHEET 11 OF 13 SHEETS
W.O. NO. 48376
CITY ENGINEER
DIVISION HEAD
DESCRIPTION BY APPROVED DATE FILMED
ORIGINAL CORTEZ LLK/GFA 6/12/66
AS BUILT Per Inst. Cir. & Field Notes CORTEZ 6-2-68
NAM BROS.
CONTRACTOR CONST. INC.
INSPECTOR L.K. BOYD
DATE STARTED 10/1/65
DATE COMPLETED 10/19/65
208.210-1719
12048 D
SECOND AVE.
AS BUILT