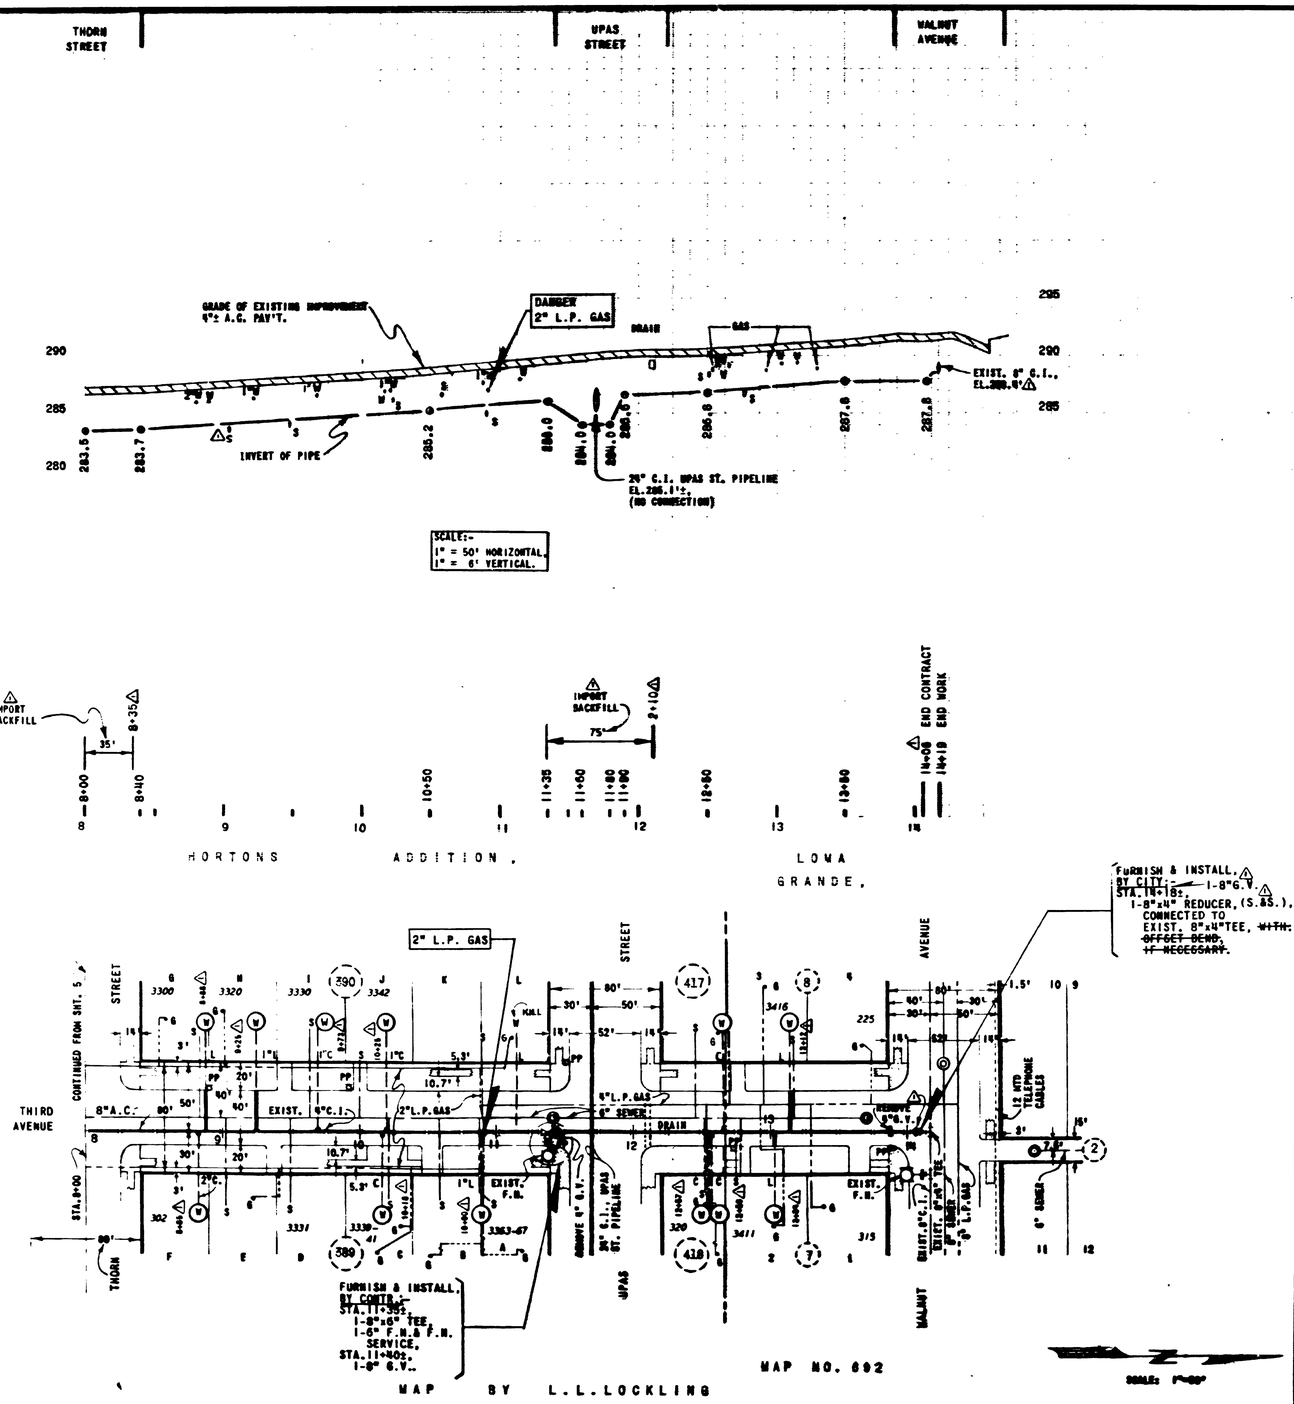

NOTE:-
FOR BENCH MARKS, REFERENCES, RETIREMENT & AS BUILT DATA, SEE SHT.5.

GROUP 139,
THIRD AVENUE 8" & 6" A.C. MAIN,
Redwood Street To Walnut Avenue.

MICROFILMED
DEC 7 1965

ENGINEERING 46350
INDEXED
JAN 19 1965

CITY OF SAN DIEGO
ENGINEERING DEPARTMENT
SHEET 6 OF 17 SHEETS

PLAN REVISION

DRAWING	BY	DATE	APPROVAL
Plans & City Forms		11/14/61	

E. F. Strickland DEC 11 1962
CITY ENGINEER — APPROVALS FOR — DATE

WATER DIST.	COVERAGE
PLANNING DIST.	DRAINAGE
ELECTRICAL	HIGHWAY
STRUCTURAL	GRADES
TRAFFIC	CONTROL

6-23-65 — DATE DRAWN
5-4-65 — DATE COMPLETED
CONTR. LONG, MARKER & MOSLEY — INSP. B. HILLS
FIELD BOOK 288-1719

6-19-B, 6-20-A.

AS BUILT

THIRD AVE., Redwood St. to Walnut Ave..