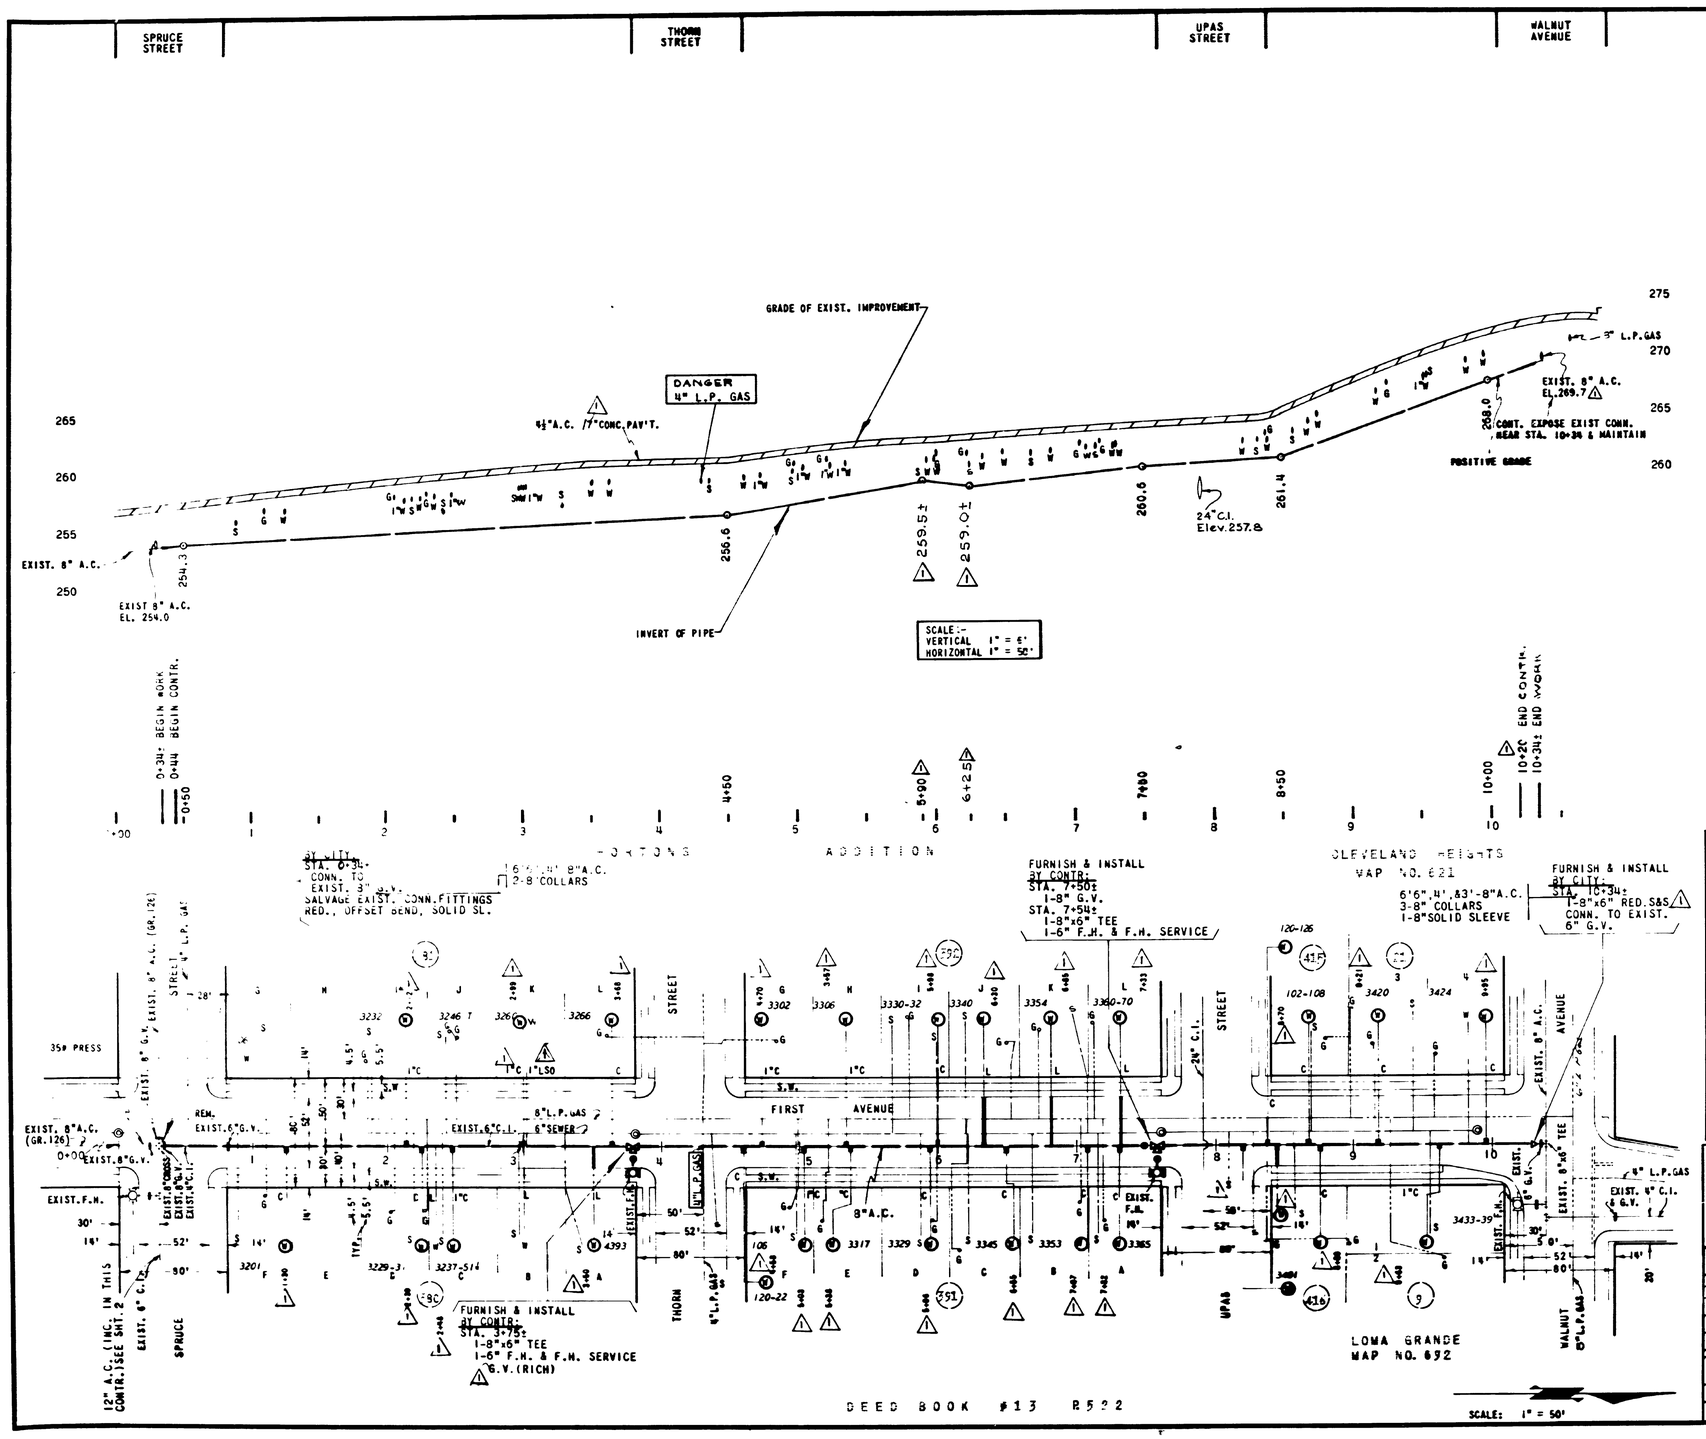

AS BUILT DATA
CONSTRUCTED BY: LONG,MARKER & HOWLEY CONST.CO.
W.O.28574 (CONSTR.), W.O.48359 (ENGR.)
PIPE: JOHN-MANVILLE "RING-TITE" (KIND)
GATE VALVES: RICH (KIND)
SOIL: RED & GRANULAR WITH ROCKS (KIND)
STAKED: 3/18/65 (DATE)
TESTED: 4/28/65 (DATE)
BACKFILL: 976' IMPORT (KIND)
NOTE: INCLUDE "CONSTRUCTION RECORD"
CONNECTIONS BY: CITY FORCE
W.O. 28575
PIPE: 8"A.C.
GATE VALVES: NONE

BENCH MARK (MEAN SEA LEVEL DATUM)
N.E. B.P. 1st AVE. & SPRUCE ST.
ELEV. 259.08

REFERENCES:
SEWER BK. #4; SHT. 215, BK. 4; SHT. 54
GAS BK. #2; SHT. 89, 99, 100, 141, 151, 152, 188 & 189
GATE BK.: SHT. G-20, G-19
10, 412-2-D GR 126 WATER:0+30 SOUTH, IN FIRST AVE
10, 412-3-D GR 126 WATER IN SPRUCE ST.
1930-L WATER & PAVE. IN FIRST AVE.
5926-L WATER X-ING @ UPAS ST.

FIELD NOTES 208 & 210-1719 W.O. 48359
1st. AVE. SPRUCE ST. TO WALNUT AVE.

RETIREMENT:
46' - 4" CI - 27
9 54' - 6" CI - 27
1 - 6" GV - 27
2 - 6" FH & FH SERVICE - 27

MICROFILMED
DEC 7 1965

GROUP 139
FIRST AVENUE 8" A.C. MAIN
SPRUCE STREET TO WALNUT AVENUE

ENGINEERING W.O. 48359

CITY OF SAN DIEGO
ENGINEERING DEPARTMENT
SHEET 3 OF 17 SHEETS

PLAN REVISION

CHANGE	BY	DATE	APPROVAL
AS BUILT As per Insp. Field & C.F. Notes	P.P.	11/19/65	LLK/GA

CONSTRUCTION RECORD
4-15-65 DATE STARTED
4-28-65 DATE COMPLETED
CONTR LONG,MARKER & HOWLEY CONST. CO. INSP H.MILLS
FIELD 208 & 210-1719

E. F. Gibelman DEC 1 1965
CITY ENGINEER DATE
APPROVALS FOR
WATER DEPT. | SEWERAGE
PLANNING DEPT. | DRAINAGE
ELECTRICAL | HIGHWAY
STRUCTURAL | GRADES
TRAFFIC | CONTROL

ASS'T CITY ENGINEER AND OFFICE ENGINEER
11-4-64
SUPERVISOR
CROSBY - KLEE
CHECKED
KLEE - PALMING
DESIGNED 8/7/64
11725-3- D

G-20-A & G-19-D

AS BUILT

FIRST AVENUE SPRUCE STREET TO WALNUT AVENUE

AS BUILT