24 TO 1 REDUCTION

# 29TH STREET UPAS STREET TO DWIGHT STREET

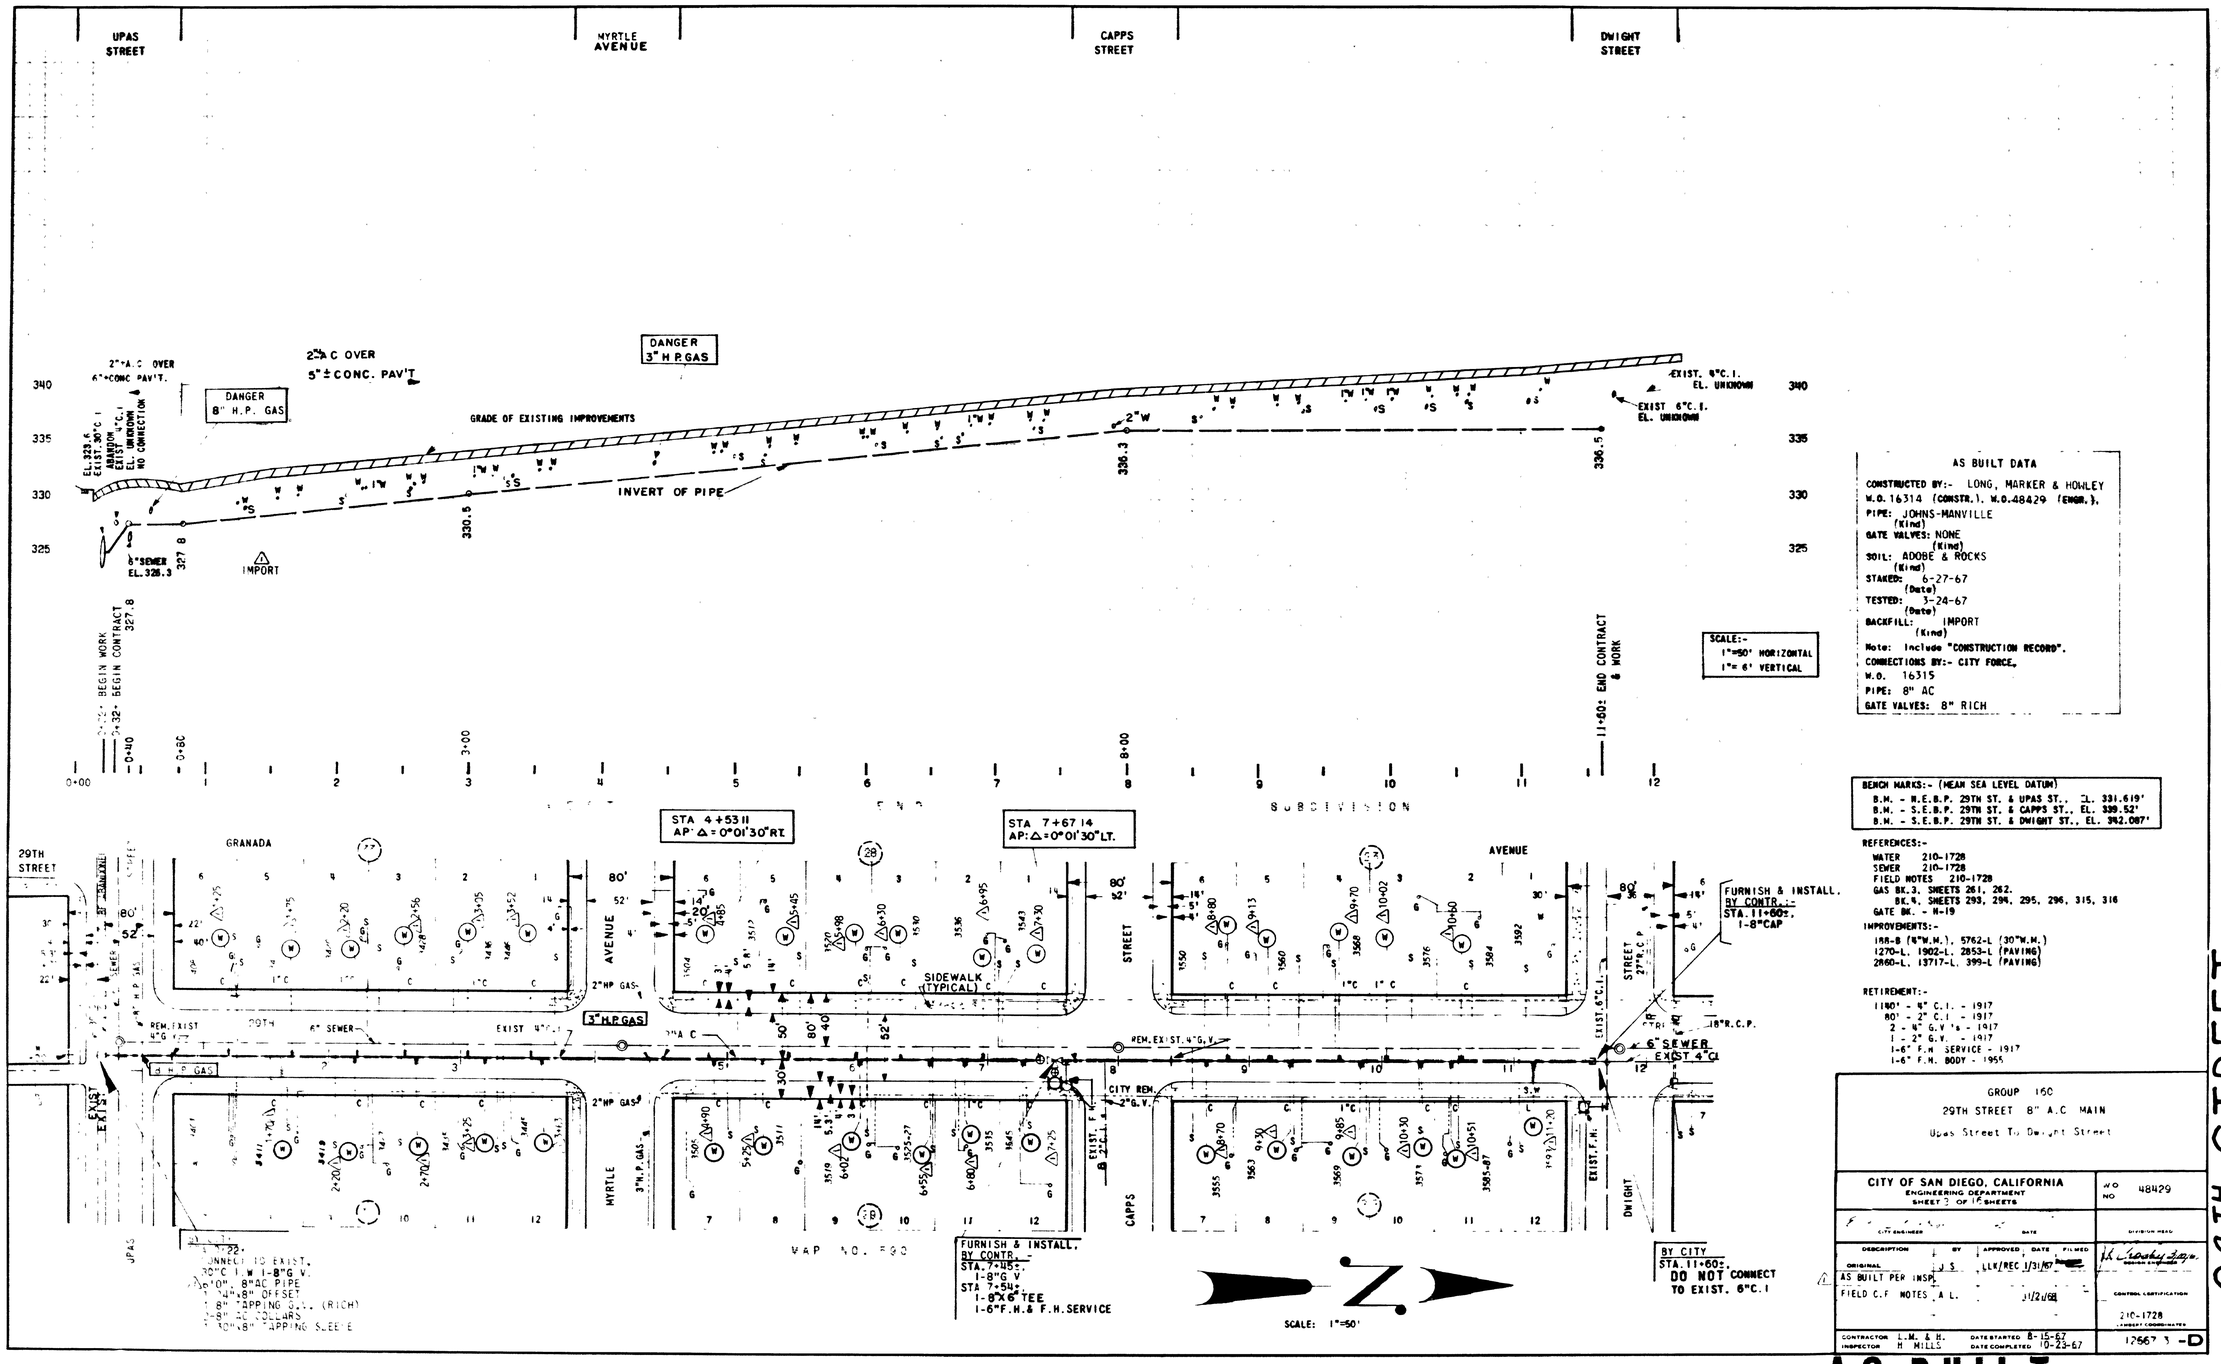


**AS BUILT DATA**

CONSTRUCTED BY:- LONG, MARKER & HOWLEY
W.O. 16314 (CONSTR.). W.O. 48429 (ENGR.).
PIPE: JOHNS-MANVILLE (Kind)
GATE VALVES: NONE (Kind)
SOIL: ADOBE & ROCKS (Kind)
STAKED: 6-27-67 (Date)
TESTED: 3-24-67 (Date)
BACKFILL: IMPORT (Kind)
Note: Include "CONSTRUCTION RECORD".
CONNECTIONS BY:- CITY FORCE.
W.O. 16315
PIPE: 8" AC
GATE VALVES: 8" RICH

**BENCH MARKS:- (MEAN SEA LEVEL DATUM)**

B.M. - N.E.B.P. 29TH ST. & UPAS ST., EL. 331.619'
B.M. - S.E.B.P. 29TH ST. & CAPP'S ST., EL. 339.52'
B.M. - S.E.B.P. 29TH ST. & DWIGHT ST., EL. 342.087'

**REFERENCES:-**

WATER 210-1728
SEWER 210-1728
FIELD NOTES 210-1728
GAS BK.3, SHEETS 261, 262.
BK.4, SHEETS 293, 294, 295, 296, 315, 316
GATE BK. - H-19

**IMPROVEMENTS:-**

188-B (8"W.M.), 5762-L (30"W.M.)
1270-L. 1902-L. 2853-L (PAVING)
2860-L. 13717-L. 399-L (PAVING)

**RETIREMENT:-**

1180' - 8" C.I. - 1917
80' - 2" C.I. - 1917
2 - 4" G.V 's - 1917
1 - 2" G.V. - 1917
1-6" F.H. SERVICE - 1917
1-6" F.H. BODY - 1955

GROUP 160
29TH STREET 8" A.C MAIN
Upas Street To Dwight Street

| CITY OF SAN DIEGO, CALIFORNIA ENGINEERING DEPARTMENT SHEET 3 OF 16 SHEETS | W.O. NO. 48429 |
|---|---|
| CITY ENGINEER / DATE | DIVISION HEAD |
| DESCRIPTION / BY / APPROVED / DATE / FILMED | |
| ORIGINAL / J.S. / LLK/REC 1/31/67 | |
| AS BUILT PER INSP. / A.L. / 11/2/68 | CONTROL CERTIFICATION 210-1728 |
| CONTRACTOR L.M. & H. / INSPECTOR H. MILLS | DATE STARTED 8-15-67 / DATE COMPLETED 10-23-67 |
| | 12667 3 -D |

**AS BUILT**