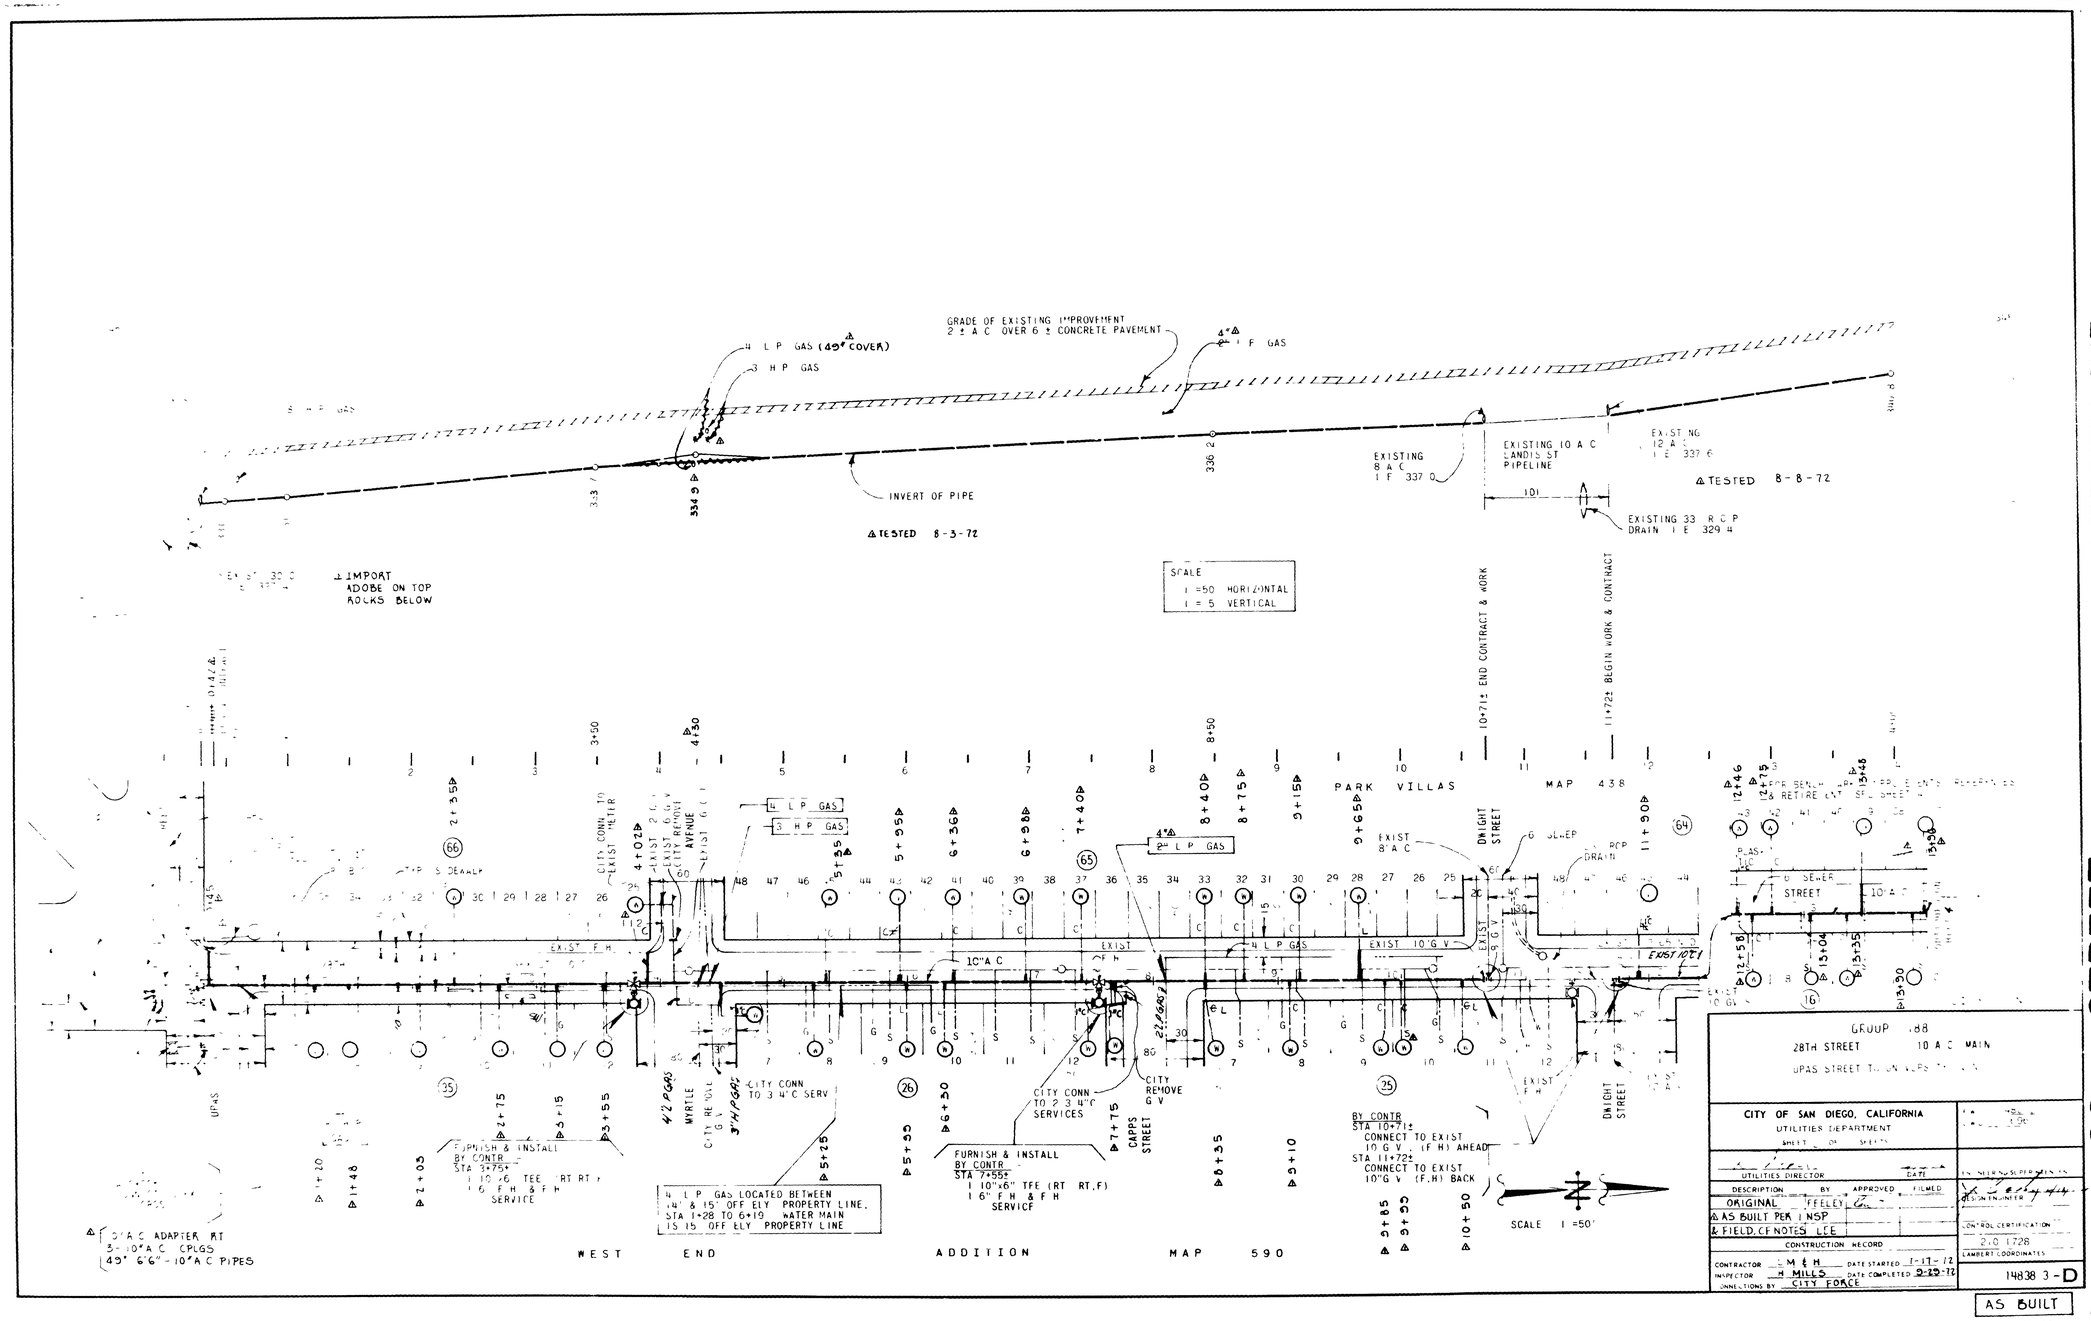
28TH STREET-UPAS ST. TO UNIVERSITY AVE.
GRADE OF EXISTING IMPROVEMENT
2 ± A C OVER 6 ± CONCRETE PAVEMENT
4 L P GAS (49" COVER)
3 H P GAS
4" 1 F GAS
INVERT OF PIPE
TESTED 8-3-72
EXISTING 8 A C 1 F 337 0
EXISTING 10 A C LANDIS ST PIPELINE
TESTED 8-8-72
EXISTING 33 R C P DRAIN 1 E 329 4
IMPORT ADOBE ON TOP ROCKS BELOW
SCALE
1 =50 HORIZONTAL
1 = 5 VERTICAL
10+71± END CONTRACT & WORK
11+72± BEGIN WORK & CONTRACT
PARK VILLAS
MAP 438
DWIGHT STREET
EXIST 8" A C
4 L P GAS
3 H P GAS
4" 2" L P GAS
10"A C
EXIST F H
EXIST 10" G V
EXIST 10" G
CITY CONN TO 3 4" C SERV
CITY CONN TO 2 3 4" C SERVICES
CITY REMOVE G V
CAPPS STREET
MYRTLE
UPAS
FURNISH & INSTALL BY CONTR STA 3+75± 1 10 x 6 TEE RT RT 1 6 F H & F H SERVICE
FURNISH & INSTALL BY CONTR STA 7+55± 1 10"x6" TEE (RT RT,F) 1 6" F H & F H SERVICE
4 L P GAS LOCATED BETWEEN 14' & 15' OFF ELY PROPERTY LINE. STA 1+28 TO 6+19 WATER MAIN 15 15 OFF ELY PROPERTY LINE
5" A C ADAPTER RT 3-10" A C CPLGS 49' 6" 6" - 10" A C PIPES
BY CONTR STA 10+71± CONNECT TO EXIST 10 G V (F H) AHEAD STA 11+72± CONNECT TO EXIST 10"G V (F,H) BACK
SCALE 1 =50'
WEST END ADDITION MAP 590
GROUP 188
28TH STREET 10 A C MAIN
UPAS STREET TO UNIVERSITY AVE.
CITY OF SAN DIEGO, CALIFORNIA
UTILITIES DEPARTMENT
UTILITIES DIRECTOR
DESCRIPTION BY APPROVED FILMED
ORIGINAL FEELEY
AS BUILT PER INSP & FIELD, CF NOTES LCE
CONSTRUCTION RECORD
CONTRACTOR M & H DATE STARTED 1-17-72
INSPECTOR H MILLS DATE COMPLETED 9-29-72
CONNECTIONS BY CITY FORCE
CONTROL CERTIFICATION
2.0 1728
LAMBERT COORDINATES
148838 3 - D
AS BUILT
1-24-73