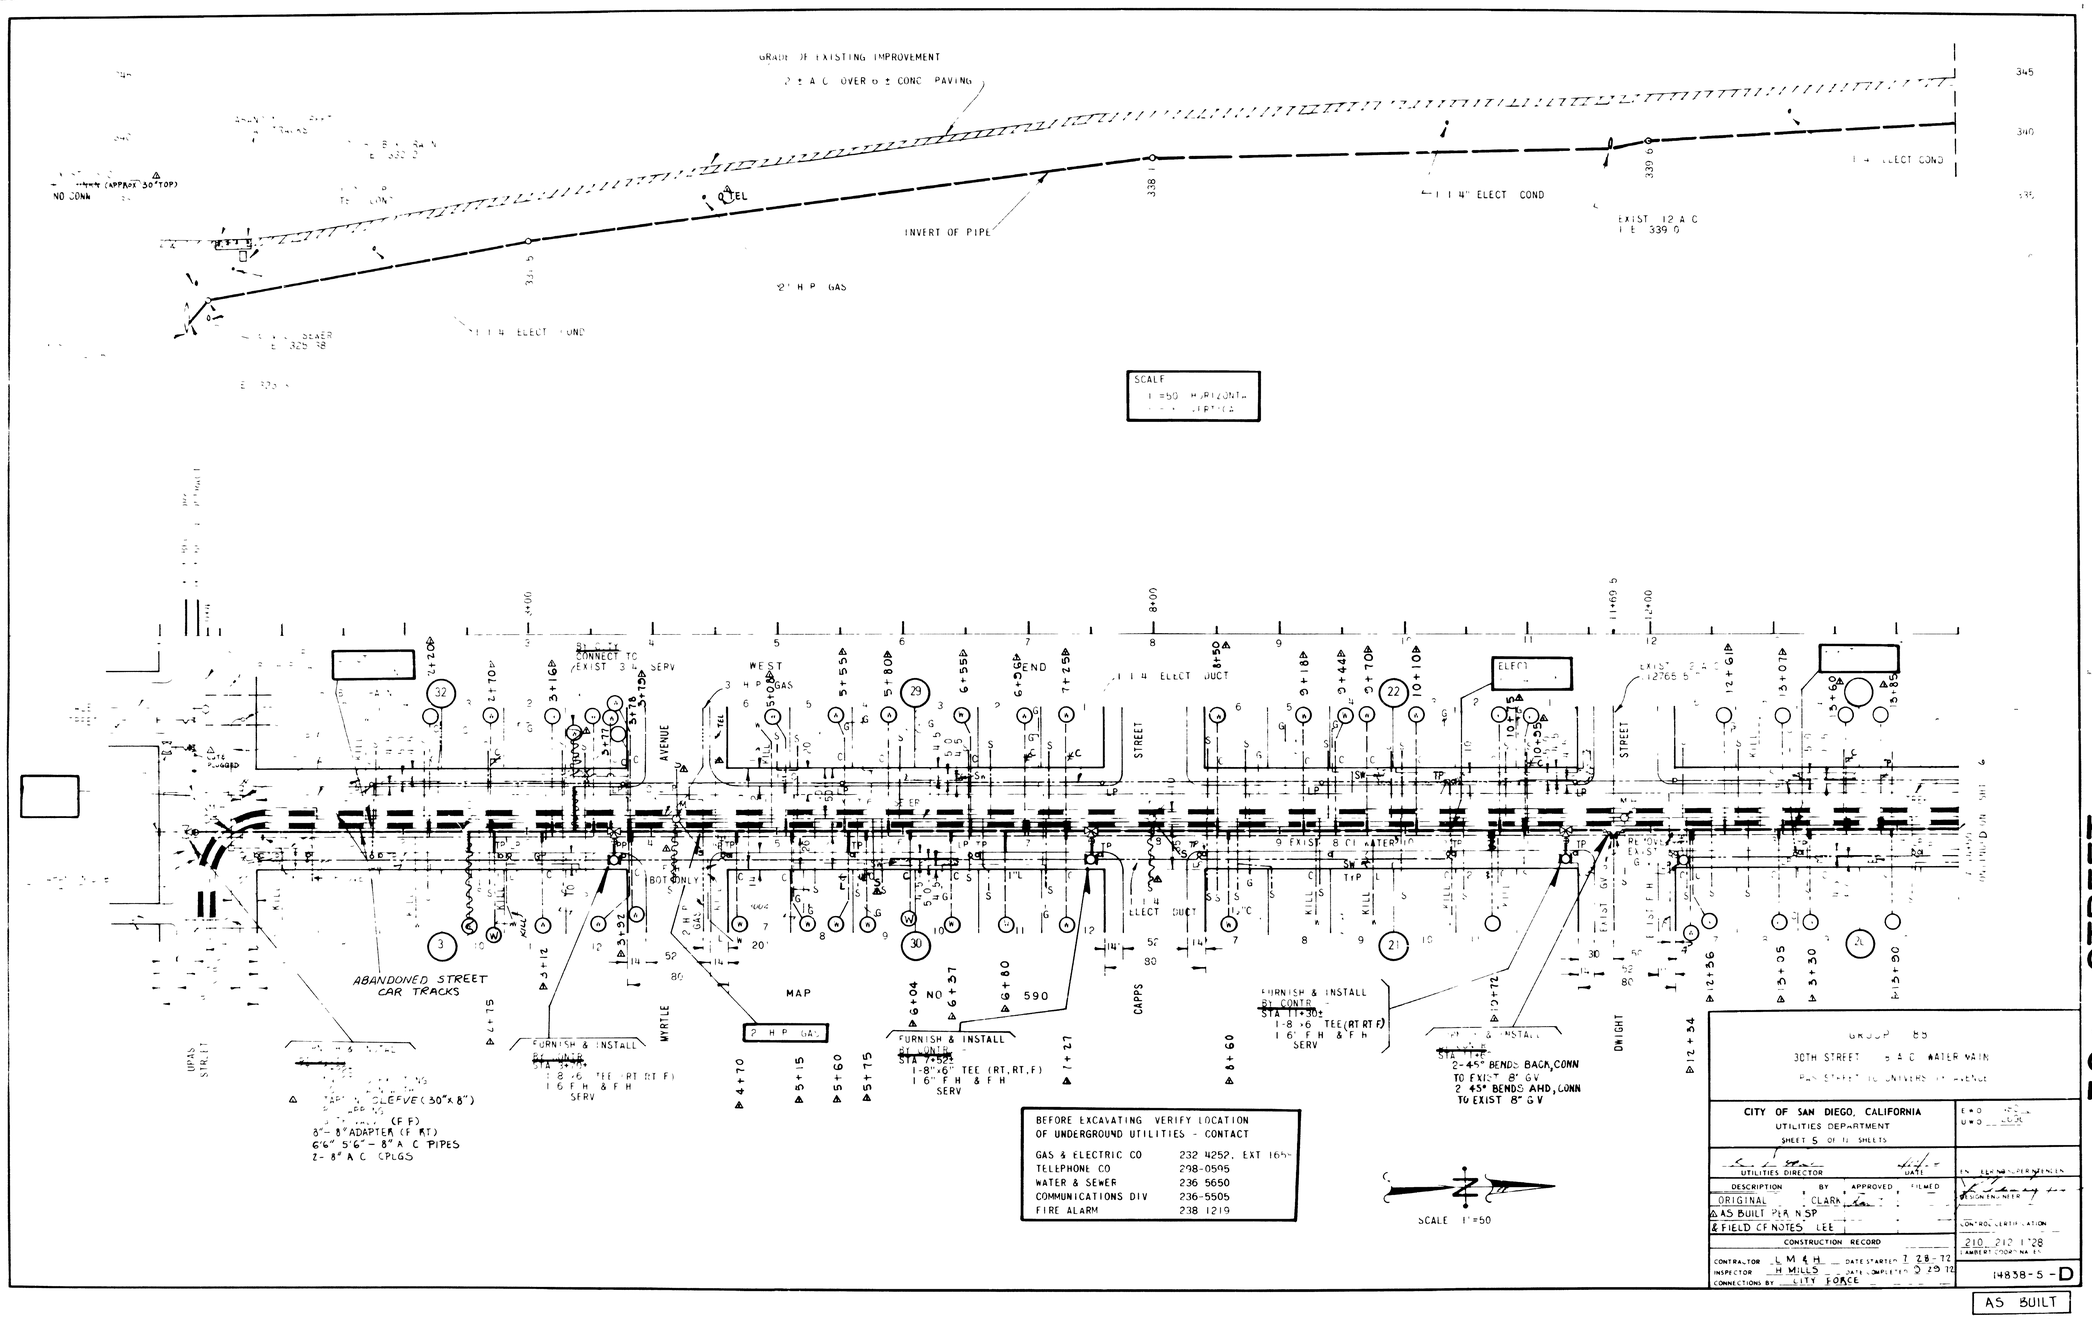

BEFORE EXCAVATING VERIFY LOCATION OF UNDERGROUND UTILITIES - CONTACT

GAS & ELECTRIC CO	232 4252, EXT 165
TELEPHONE CO	298-0595
WATER & SEWER	236 5650
COMMUNICATIONS DIV	236-5505
FIRE ALARM	238 1219

GROUP 85
30TH STREET 6 A C WATER MAIN
PAS STREET TO UNIVERSITY AVENUE

CITY OF SAN DIEGO, CALIFORNIA
UTILITIES DEPARTMENT
SHEET 5 OF 11 SHEETS

UTILITIES DIRECTOR — DATE

DESCRIPTION	BY	APPROVED	FILMED
ORIGINAL	CLARK		
△ AS BUILT PER N SP			
& FIELD CF NOTES LEE			

CONSTRUCTION RECORD
CONTRACTOR L M & H DATE STARTED 7 28 72
INSPECTOR H MILLS DATE COMPLETED 9 29 72
CONNECTIONS BY CITY FORCE

E = 0
U = 0

ENGINEERING SUPERINTENDENT
DESIGN ENGINEER
CONTROL CERTIFICATION
210 212 1728
LAMBERT COORDINATES

14838-5-D

AS BUILT
1-24-73