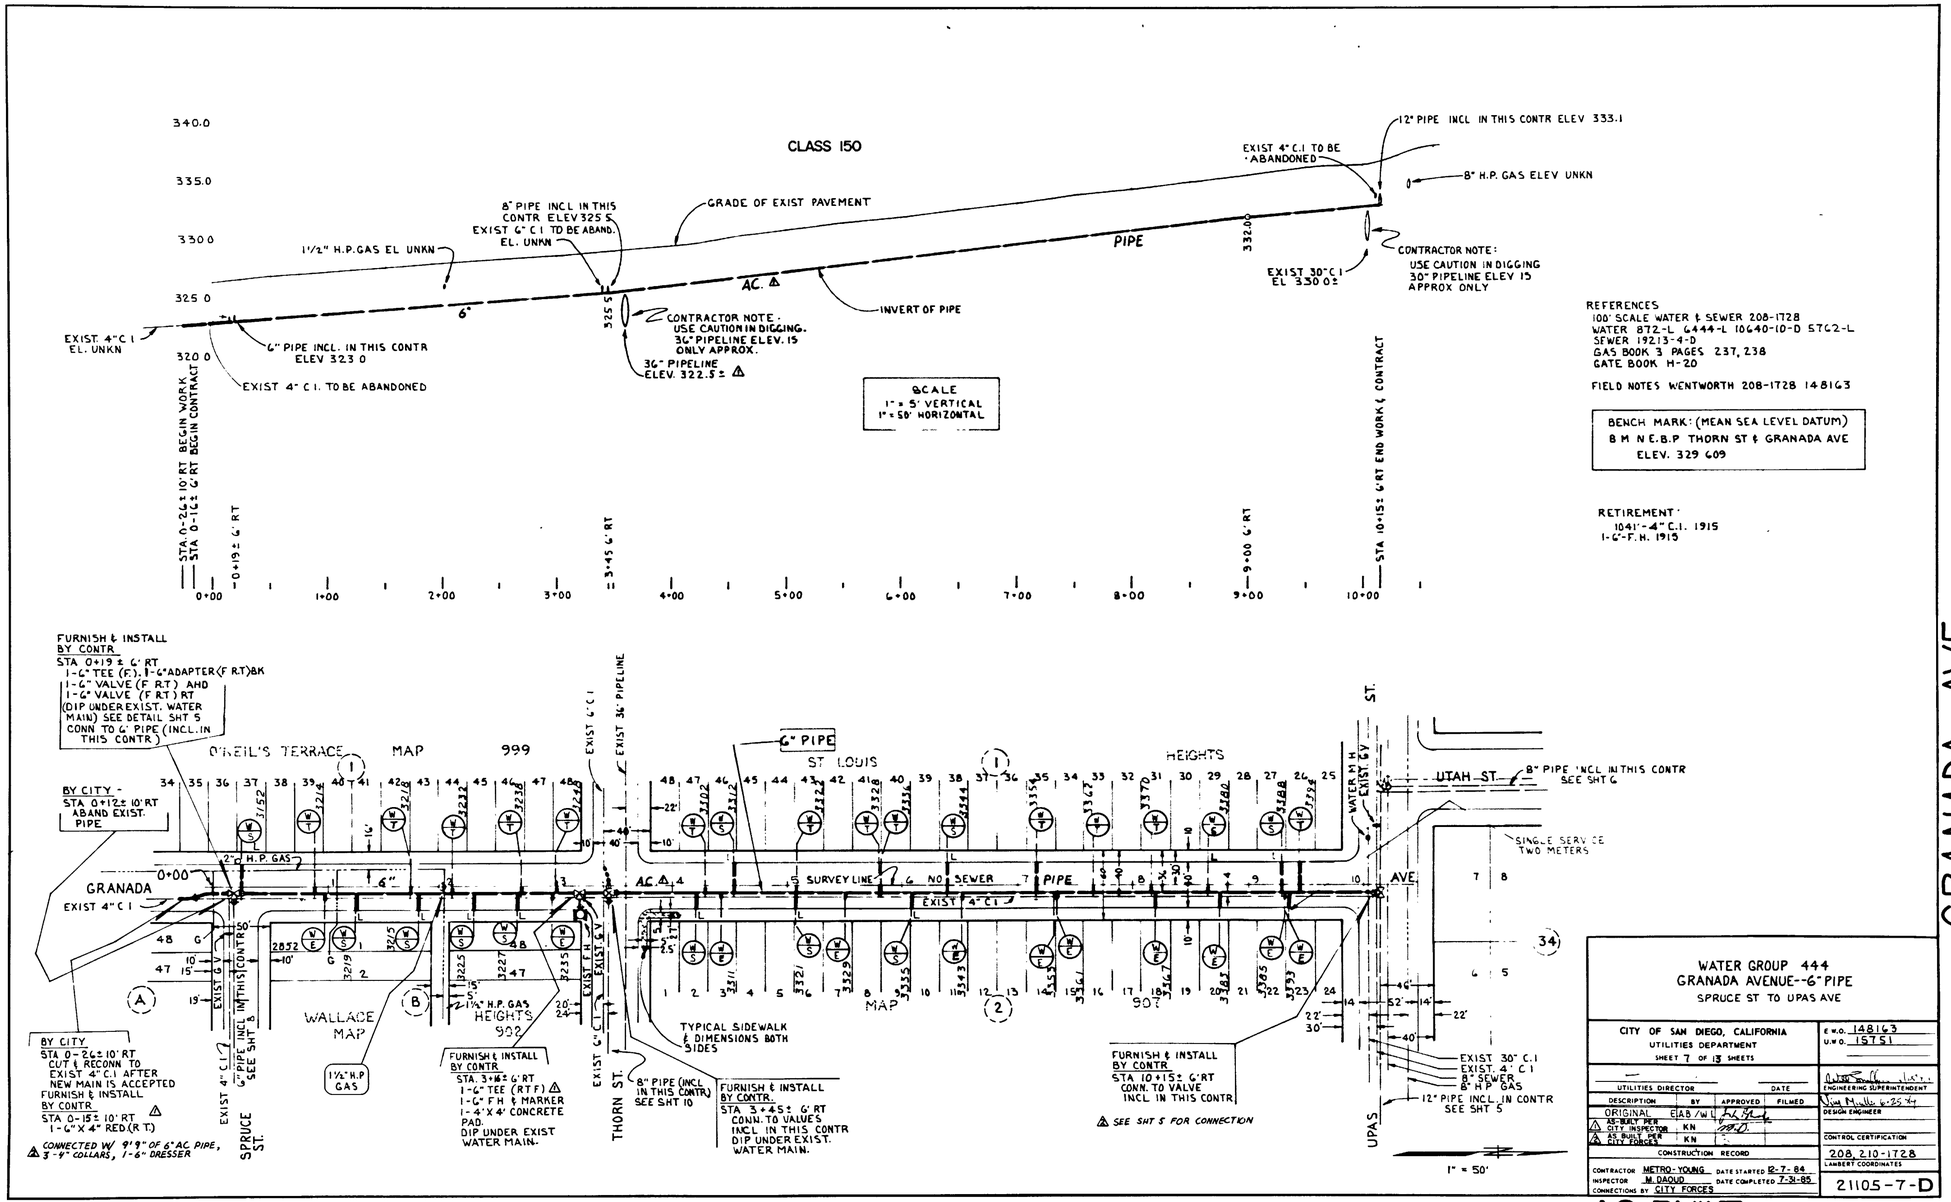

WATER GROUP 444
GRANADA AVENUE--6" PIPE
SPRUCE ST TO UPAS AVE

CITY OF SAN DIEGO, CALIFORNIA UTILITIES DEPARTMENT SHEET 7 OF 13 SHEETS	E.W.O. 148163 U.W.O. 15751
UTILITIES DIRECTOR — DATE	ENGINEERING SUPERINTENDENT
DESCRIPTION / BY / APPROVED / FILMED	DESIGN ENGINEER
ORIGINAL EAB/WL AS-BUILT PER CITY INSPECTOR KN AS BUILT PER CITY FORCES KN	CONTROL CERTIFICATION
CONSTRUCTION RECORD	208, 210-1728 LAMBERT COORDINATES
CONTRACTOR METRO-YOUNG DATE STARTED 12-7-84 INSPECTOR M. DAOUD DATE COMPLETED 7-31-85 CONNECTIONS BY CITY FORCES	21105-7-D

AS-BUILT