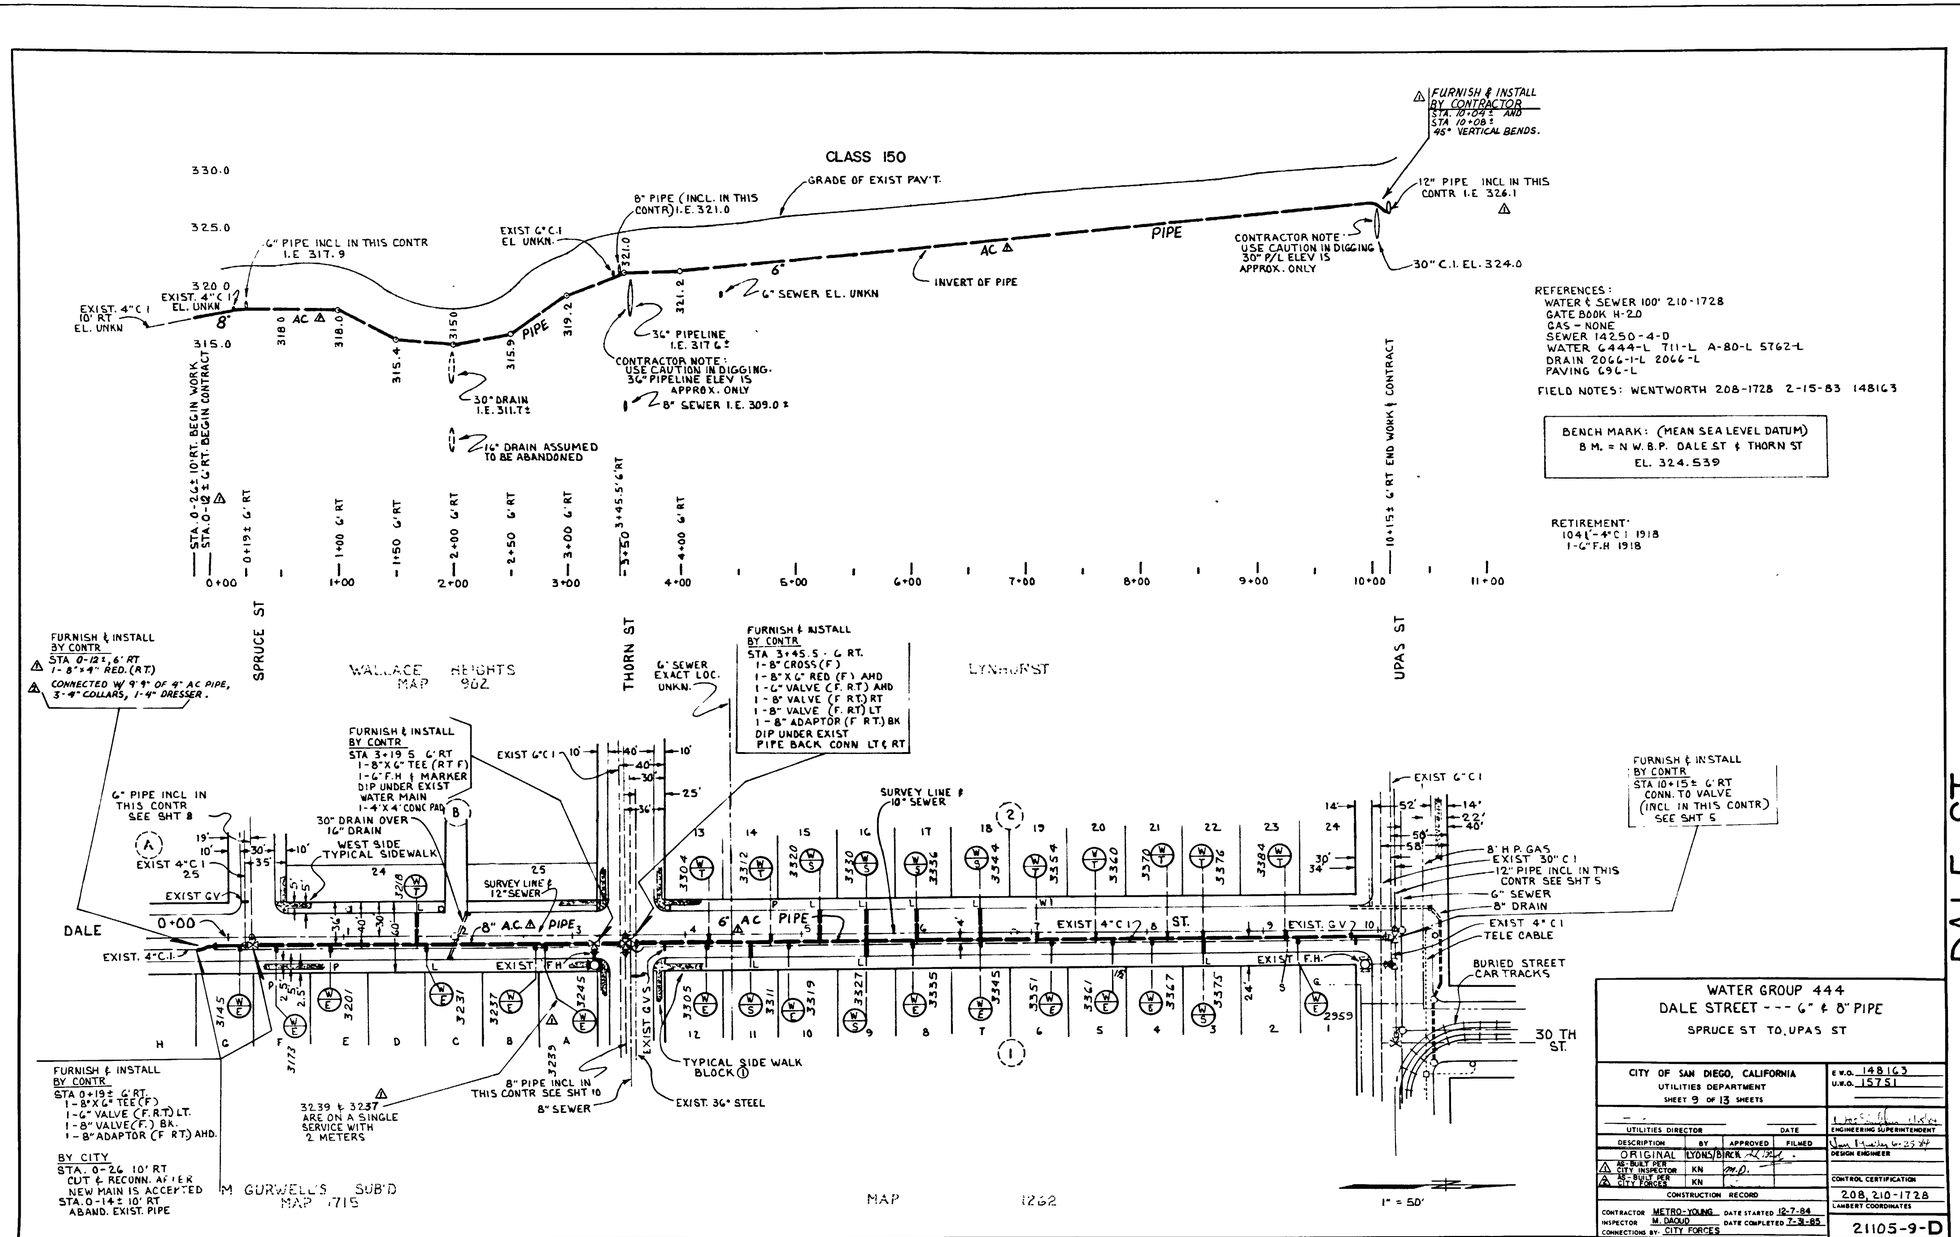

REFERENCES:
WATER & SEWER 100' 210-1728
GATE BOOK H-20
GAS - NONE
SEWER 14250-4-D
WATER 6444-L 711-L A-80-L 5762-L
DRAIN 2066-1-L 2066-L
PAVING 696-L

FIELD NOTES: WENTWORTH 208-1728 2-15-83 148163

BENCH MARK: (MEAN SEA LEVEL DATUM)
B.M. = N.W.B.P. DALE ST & THORN ST
EL. 324.539

RETIREMENT:
104 1-4" C.I. 1918
1-6" F.H. 1918

WATER GROUP 444
DALE STREET --- 6" & 8" PIPE
SPRUCE ST TO UPAS ST

CITY OF SAN DIEGO, CALIFORNIA
UTILITIES DEPARTMENT
SHEET 9 OF 13 SHEETS

E.W.O. 148163
U.W.O. 15751

UTILITIES DIRECTOR — DATE
ENGINEERING SUPERINTENDENT
DESIGN ENGINEER
CONTROL CERTIFICATION
208, 210-1728
LAMBERT COORDINATES

DESCRIPTION	BY	APPROVED	FILMED
ORIGINAL	LYONS/B	RCK	
AS-BUILT PER CITY INSPECTOR	KN	M.D.	
AS-BUILT PER CITY FORCES	KN		

CONSTRUCTION RECORD
CONTRACTOR METRO-YOUNG DATE STARTED 12-7-84
INSPECTOR M. DAOUD DATE COMPLETED 7-31-85
CONNECTIONS BY: CITY FORCES

21105-9-D

AS-BUILT