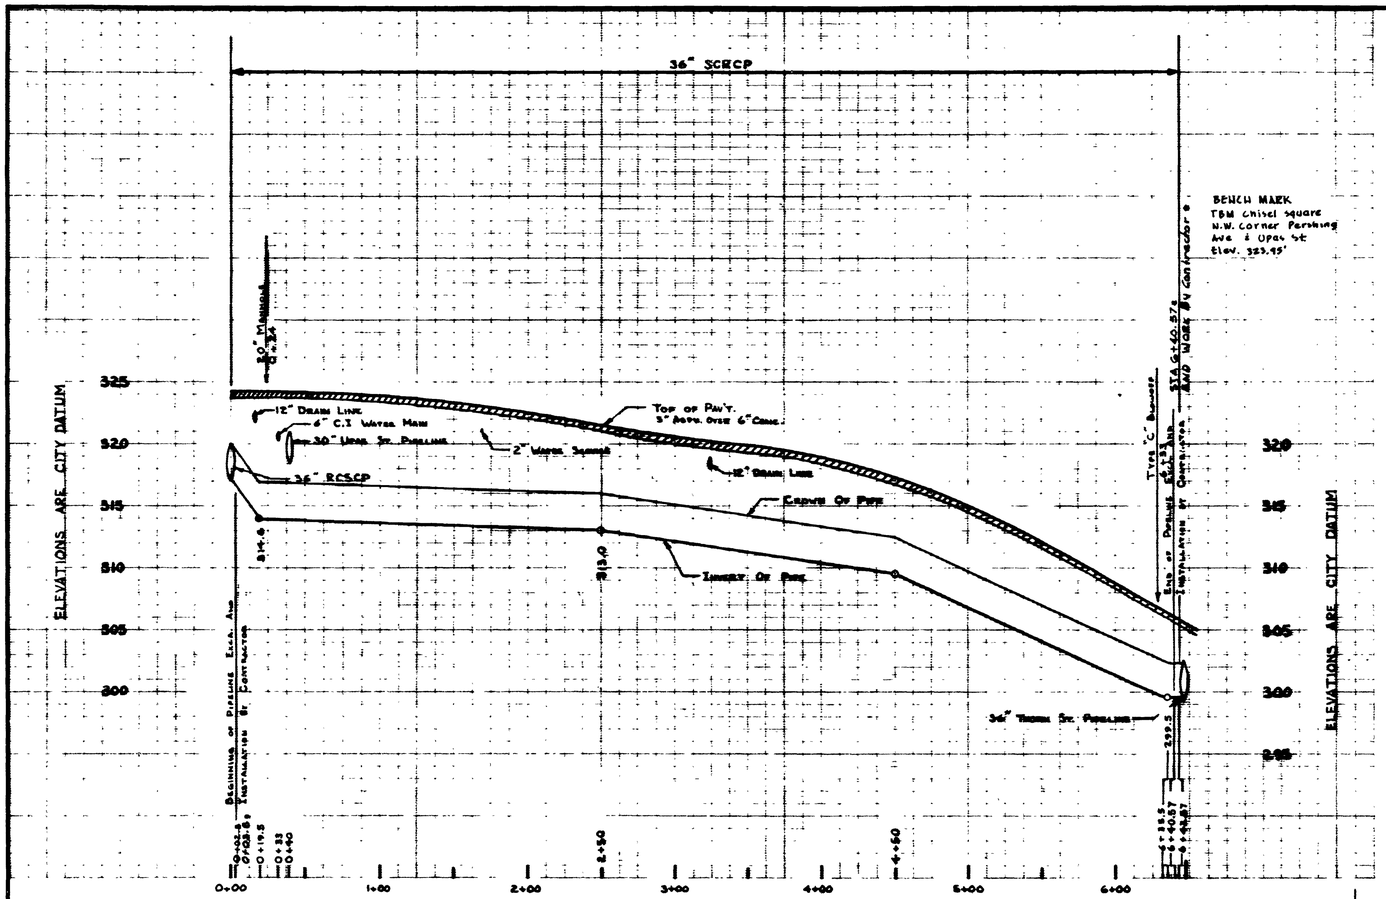

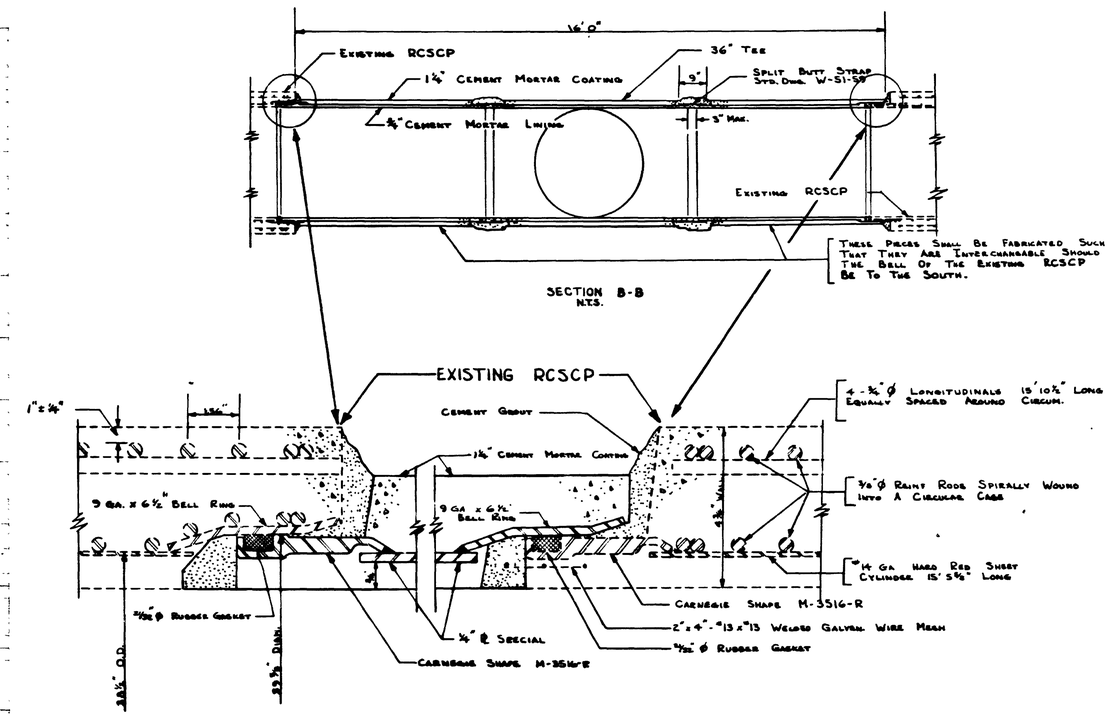

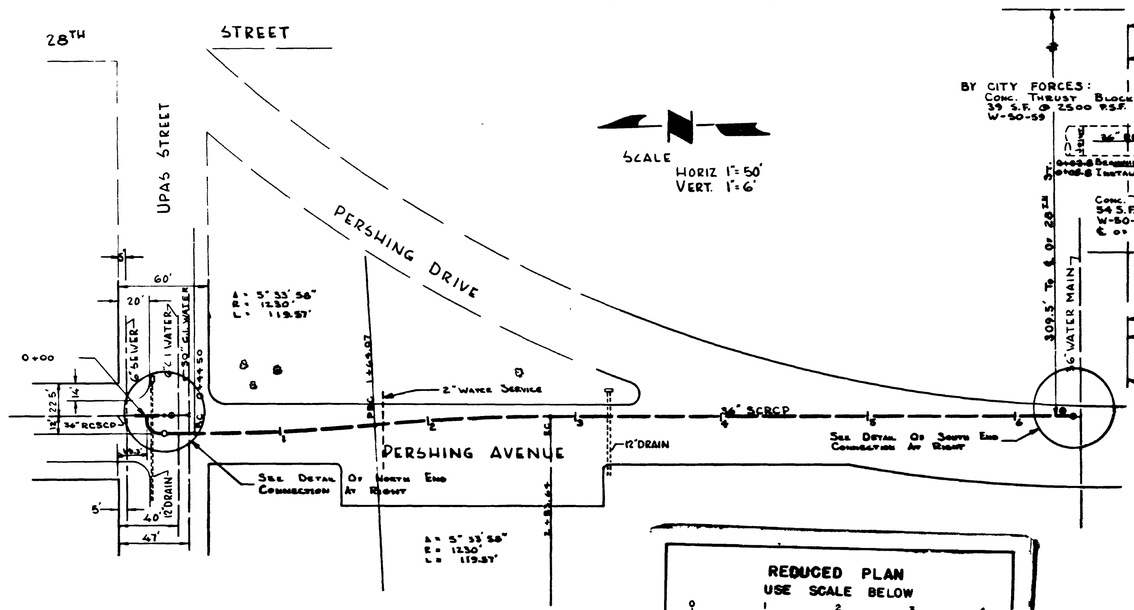

PERSHING AVENUE PIPELINE EXTENSION

UPAS STREET, THORN STREET CONNECTION.

CITY OF SAN DIEGO
ENGINEERING DEPARTMENT

SHEET 2 OF 2 SHEETS

W.O. NO. 48270

PLAN REVISION			
CHANGE	BY	DATE	APPROVAL

CITY ENGINEER — MAR 9 1962 — DATE

APPROVALS FOR	
WATER DEPT.	SEWERAGE
PLANNING DEPT.	DRAINAGE
ELECTRICAL	HIGHWAY
STRUCTURAL	GRADES
TRAFFIC	CONTROL

CONSTRUCTION RECORD	
DATE STARTED	DATE COMPLETED
CONTR.	INSP.
FIELD BOOK	

ASS'T CITY ENGINEER AND OFFICE ENGINEER — 12-26-61
SUPERVISOR — 12-21-61
CHECKED — 11-29-61
DESIGNED

10403-2AD

MICROFILMED

AS-BUILT. 12/18/62 Plat Book Pg H-20-B

APR - - 1963