24: TO 1 REDUCTION

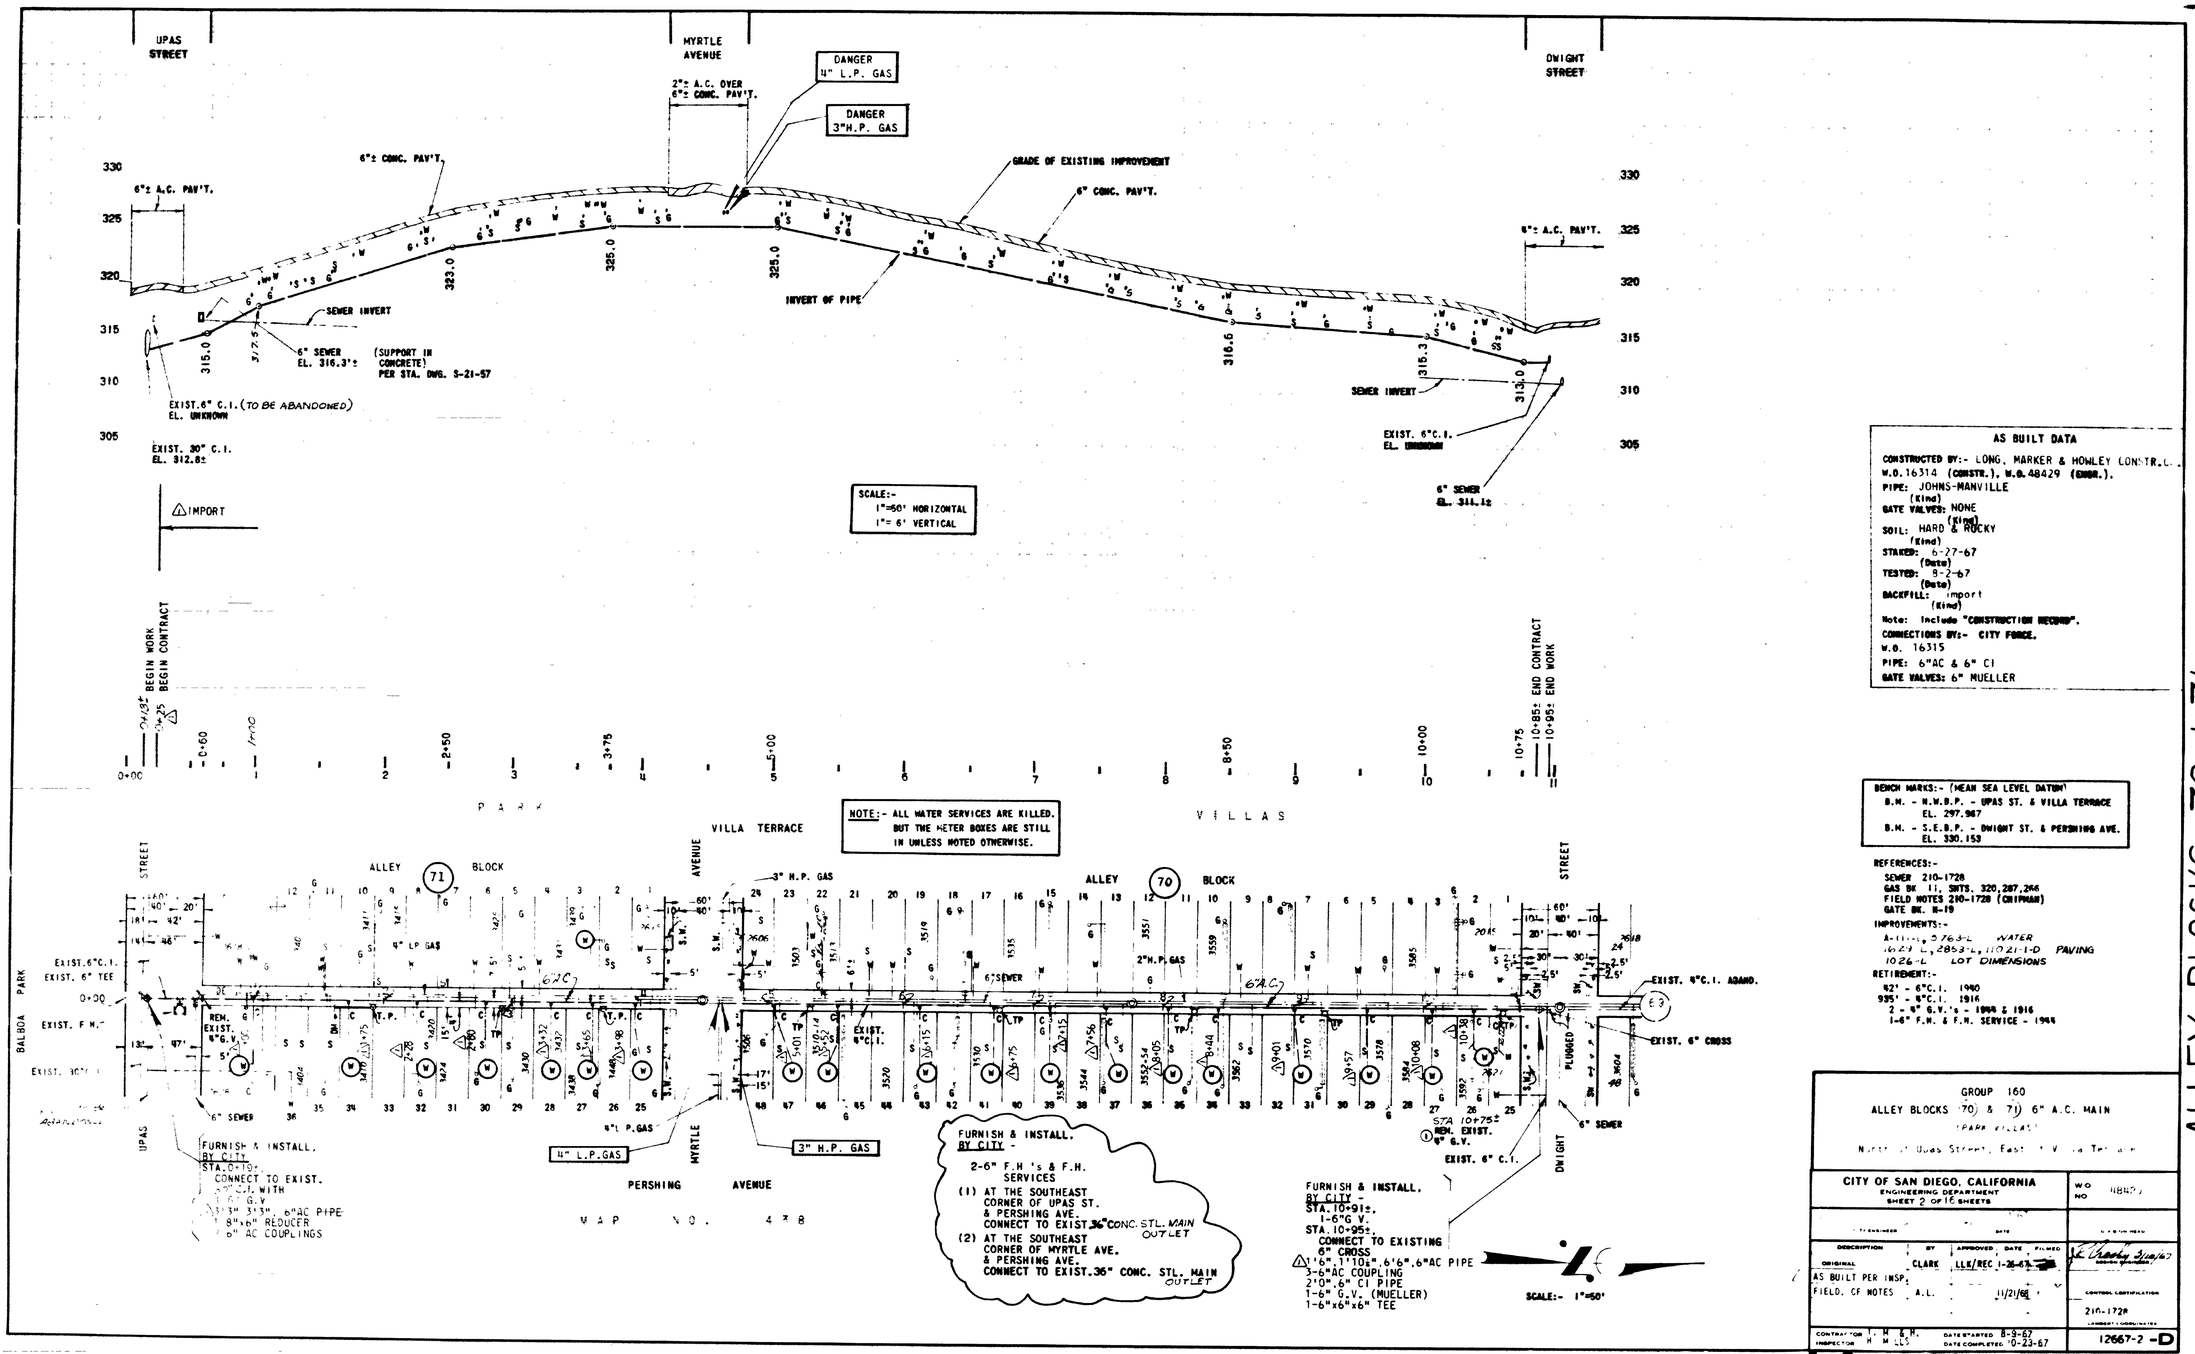

AS BUILT DATA

CONSTRUCTED BY:- LONG, MARKER & HOWLEY CONSTR.CO.
W.O.16314 (CONSTR.), W.O.48429 (ENGR.).
PIPE: JOHNS-MANVILLE (Kind)
GATE VALVES: NONE (Kind)
SOIL: HARD & ROCKY (Kind)
STAKED: 6-27-67 (Date)
TESTED: 8-2-67 (Date)
BACKFILL: import (Kind)
Note: Include "CONSTRUCTION RECORD".
CONNECTIONS BY:- CITY FORCE.
W.O. 16315
PIPE: 6"AC & 6" CI
GATE VALVES: 6" MUELLER

BENCH MARKS:- (MEAN SEA LEVEL DATUM)
B.M. - N.W.B.P. - UPAS ST. & VILLA TERRACE EL. 297.987
B.M. - S.E.B.P. - DWIGHT ST. & PERSHING AVE. EL. 330.153

REFERENCES:-
SEWER 210-1728
GAS BK. 11, SHTS. 320,287,246
FIELD NOTES 210-1728 (CHIPMAN)
GATE BK. H-19

IMPROVEMENTS:-
A-11111, 5763-L WATER
1629-L, 28833-L, 11021-1-D PAVING
1026-L LOT DIMENSIONS

RETIREMENT:-
92' - 6"C.I. 1940
935' - 8"C.I. 1916
2 - 6" G.V.'s - 1940 & 1916
1-6" F.H. & F.H. SERVICE - 1944

GROUP 160
ALLEY BLOCKS (70) & (71) 6" A.C. MAIN
(PARK VILLAS)
North of Upas Street, East of Villa Terrace

CITY OF SAN DIEGO, CALIFORNIA ENGINEERING DEPARTMENT SHEET 2 OF 16 SHEETS				WO NO 48429
CITY ENGINEER		DATE		W.O. ENGINEER
DESCRIPTION	BY	APPROVED	DATE	FILMED
ORIGINAL	CLARK	LLE/REC	1-26-68	
AS BUILT PER INSP. FIELD, CF NOTES	A.L.		11/21/68	
CONTRACTOR L. M. & H. INSPECTOR H. M. LLS		DATE STARTED 8-9-67 DATE COMPLETED 10-23-67		CONTROL CERTIFICATION 210-1728 LAMINEX CORDINATES 12667-2 -D

ALLEY BLOCKS 70 & 71

AS BUILT