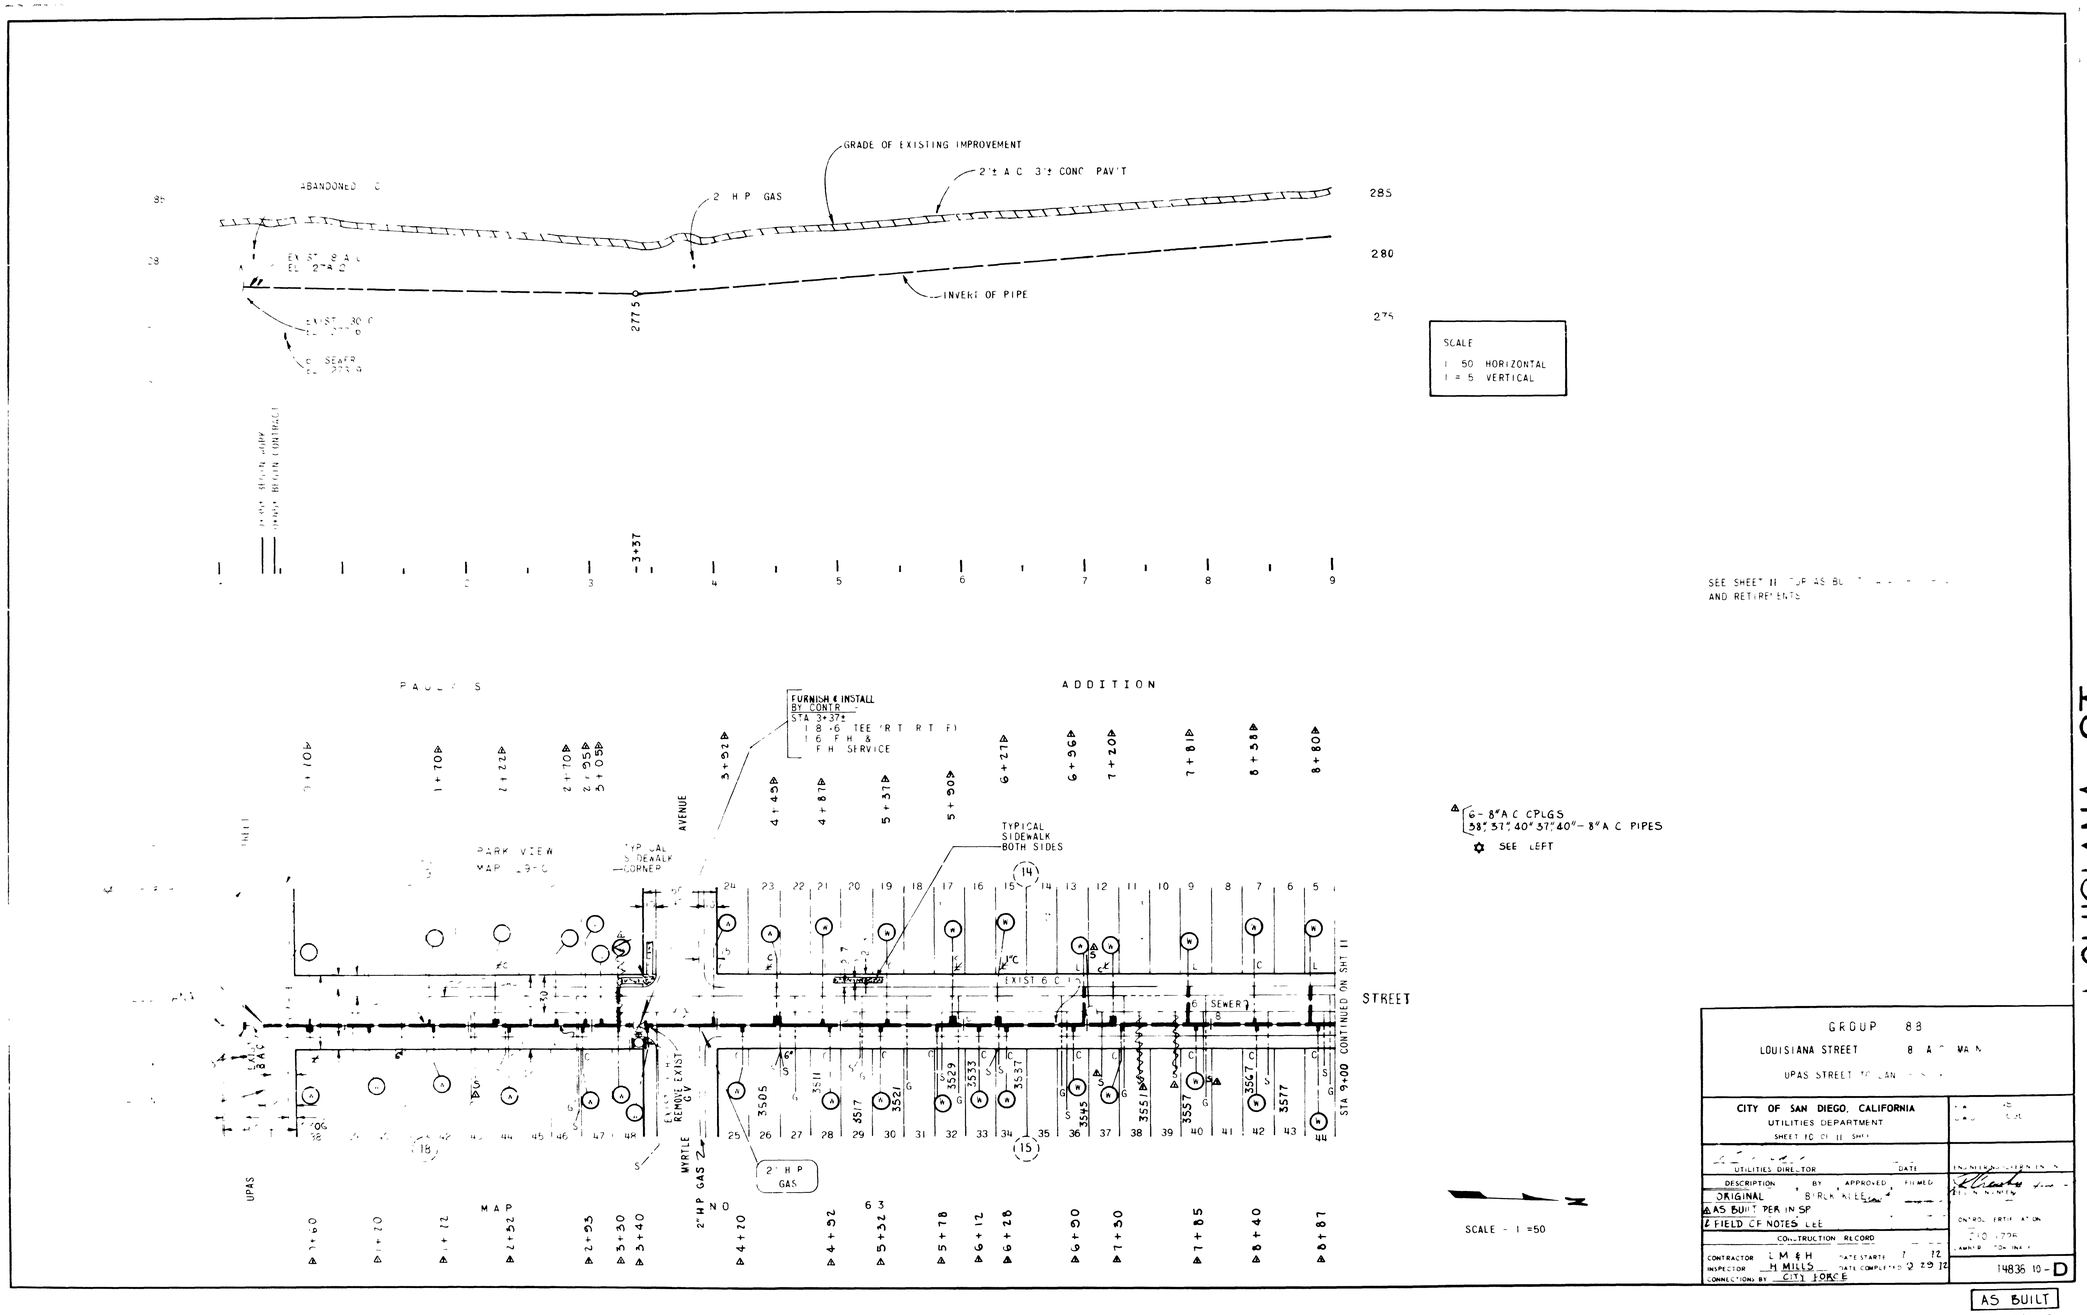

GRADE OF EXISTING IMPROVEMENT
2"± A C 3"± CONC PAV'T
2 H P GAS
INVERT OF PIPE
285
280
275
SCALE
1 50 HORIZONTAL
1 = 5 VERTICAL
SEE SHEET 11 FOR AS BUILT AND RETIREMENTS
ADDITION
FURNISH & INSTALL BY CONTR
STA 3+37±
1 8 -6 TEE (R T R T F)
1 6 F H & F H SERVICE
TYPICAL SIDEWALK BOTH SIDES
6 - 8" A C CPLGS
38", 37", 40" 37", 40" - 8" A C PIPES
SEE LEFT
PARK VIEW
AVENUE
STREET
UPAS
MAP NO 63
2" H P GAS
STA 9+00 CONTINUED ON SHT 11
SCALE - 1 =50
GROUP 88
LOUISIANA STREET 8 A C MAIN
UPAS STREET TO LAN
CITY OF SAN DIEGO, CALIFORNIA
UTILITIES DEPARTMENT
UTILITIES DIRECTOR
DESCRIPTION BY APPROVED FILMED
ORIGINAL BIRCH KEEL
AS BUILT PER IN SP
FIELD OF NOTES LEE
CONSTRUCTION RECORD
CONTRACTOR L M & H
INSPECTOR H MILLS
CONNECTIONS BY CITY FORCE
14836 10 - D
AS BUILT
1 24 - 73
LOUISIANA ST.