ALLEY BLK. 65 & 66

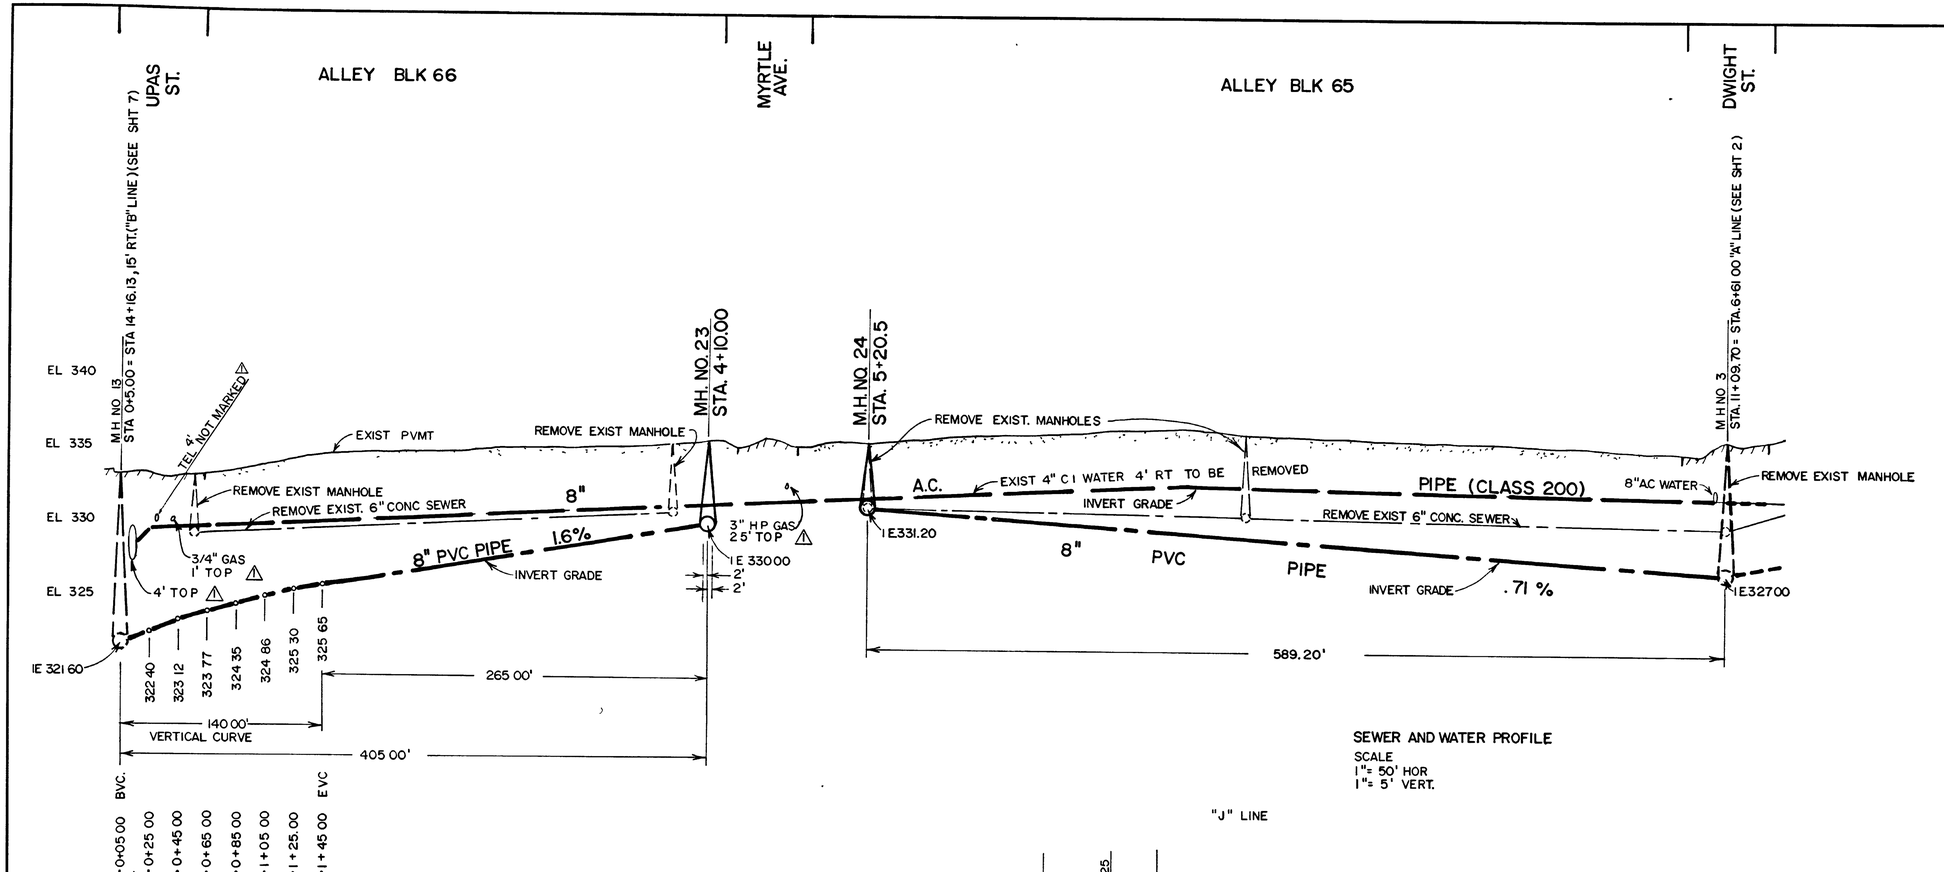


SEWER AND WATER PROFILE
SCALE
1" = 50' HOR
1" = 5' VERT.

BENCH MARK
SEBP VILLA TERRACE AND DWIGHT ST
EL 304.101 M.S.L.

REFERENCES
FIELD NOTES
CRAIG 210-1725, 11-86, WO 170461, SHT 3-9 OF 19 "J" LINE
WATER 5763-L, 6137-L, 12765-4-D
SEWER
GAS 11/319, 266

RETIREMENT
1000' OF 6" CONC. INSTALLED 1925±
1085' OF 4" CI " UNK

SEWER & WATER GROUP 71
ALLEY BLK. 65 & 66
UPAS TO DWIGHT ST.

CITY OF SAN DIEGO, CALIFORNIA
UTILITIES DEPARTMENT
SHEET 10 OF 16 SHEETS

SEWER W.O. 170461
WATER W.O. 180361

UTILITIES DIRECTOR — DATE 3-1-88
ENGINEERING SUPERINTENDENT — Roger Draft 3/4/88
DESIGN ENGINEER

| DESCRIPTION | BY | APPROVED | FILMED |
|---|---|---|---|
| ORIGINAL | DJ/KN | R. Bandhard | |
| 1 AS-BUILT PER CITY INSPECTOR | HW/CS | A. Paiva | |
| 2 CITY FORCES | RR/GB | | |

CONTROL CERTIFICATION
210-1727
LAMBERT COORDINATES
23415-10-D

CONSTRUCTION RECORD
CONTRACTOR DRAINAGE CONSTR CO. INC. — DATE STARTED 03-13-89
INSPECTOR A. PAIVA — DATE COMPLETED 12-08-89
CONNECTIONS BY CITY FORCES

AS-BUILT

99 8