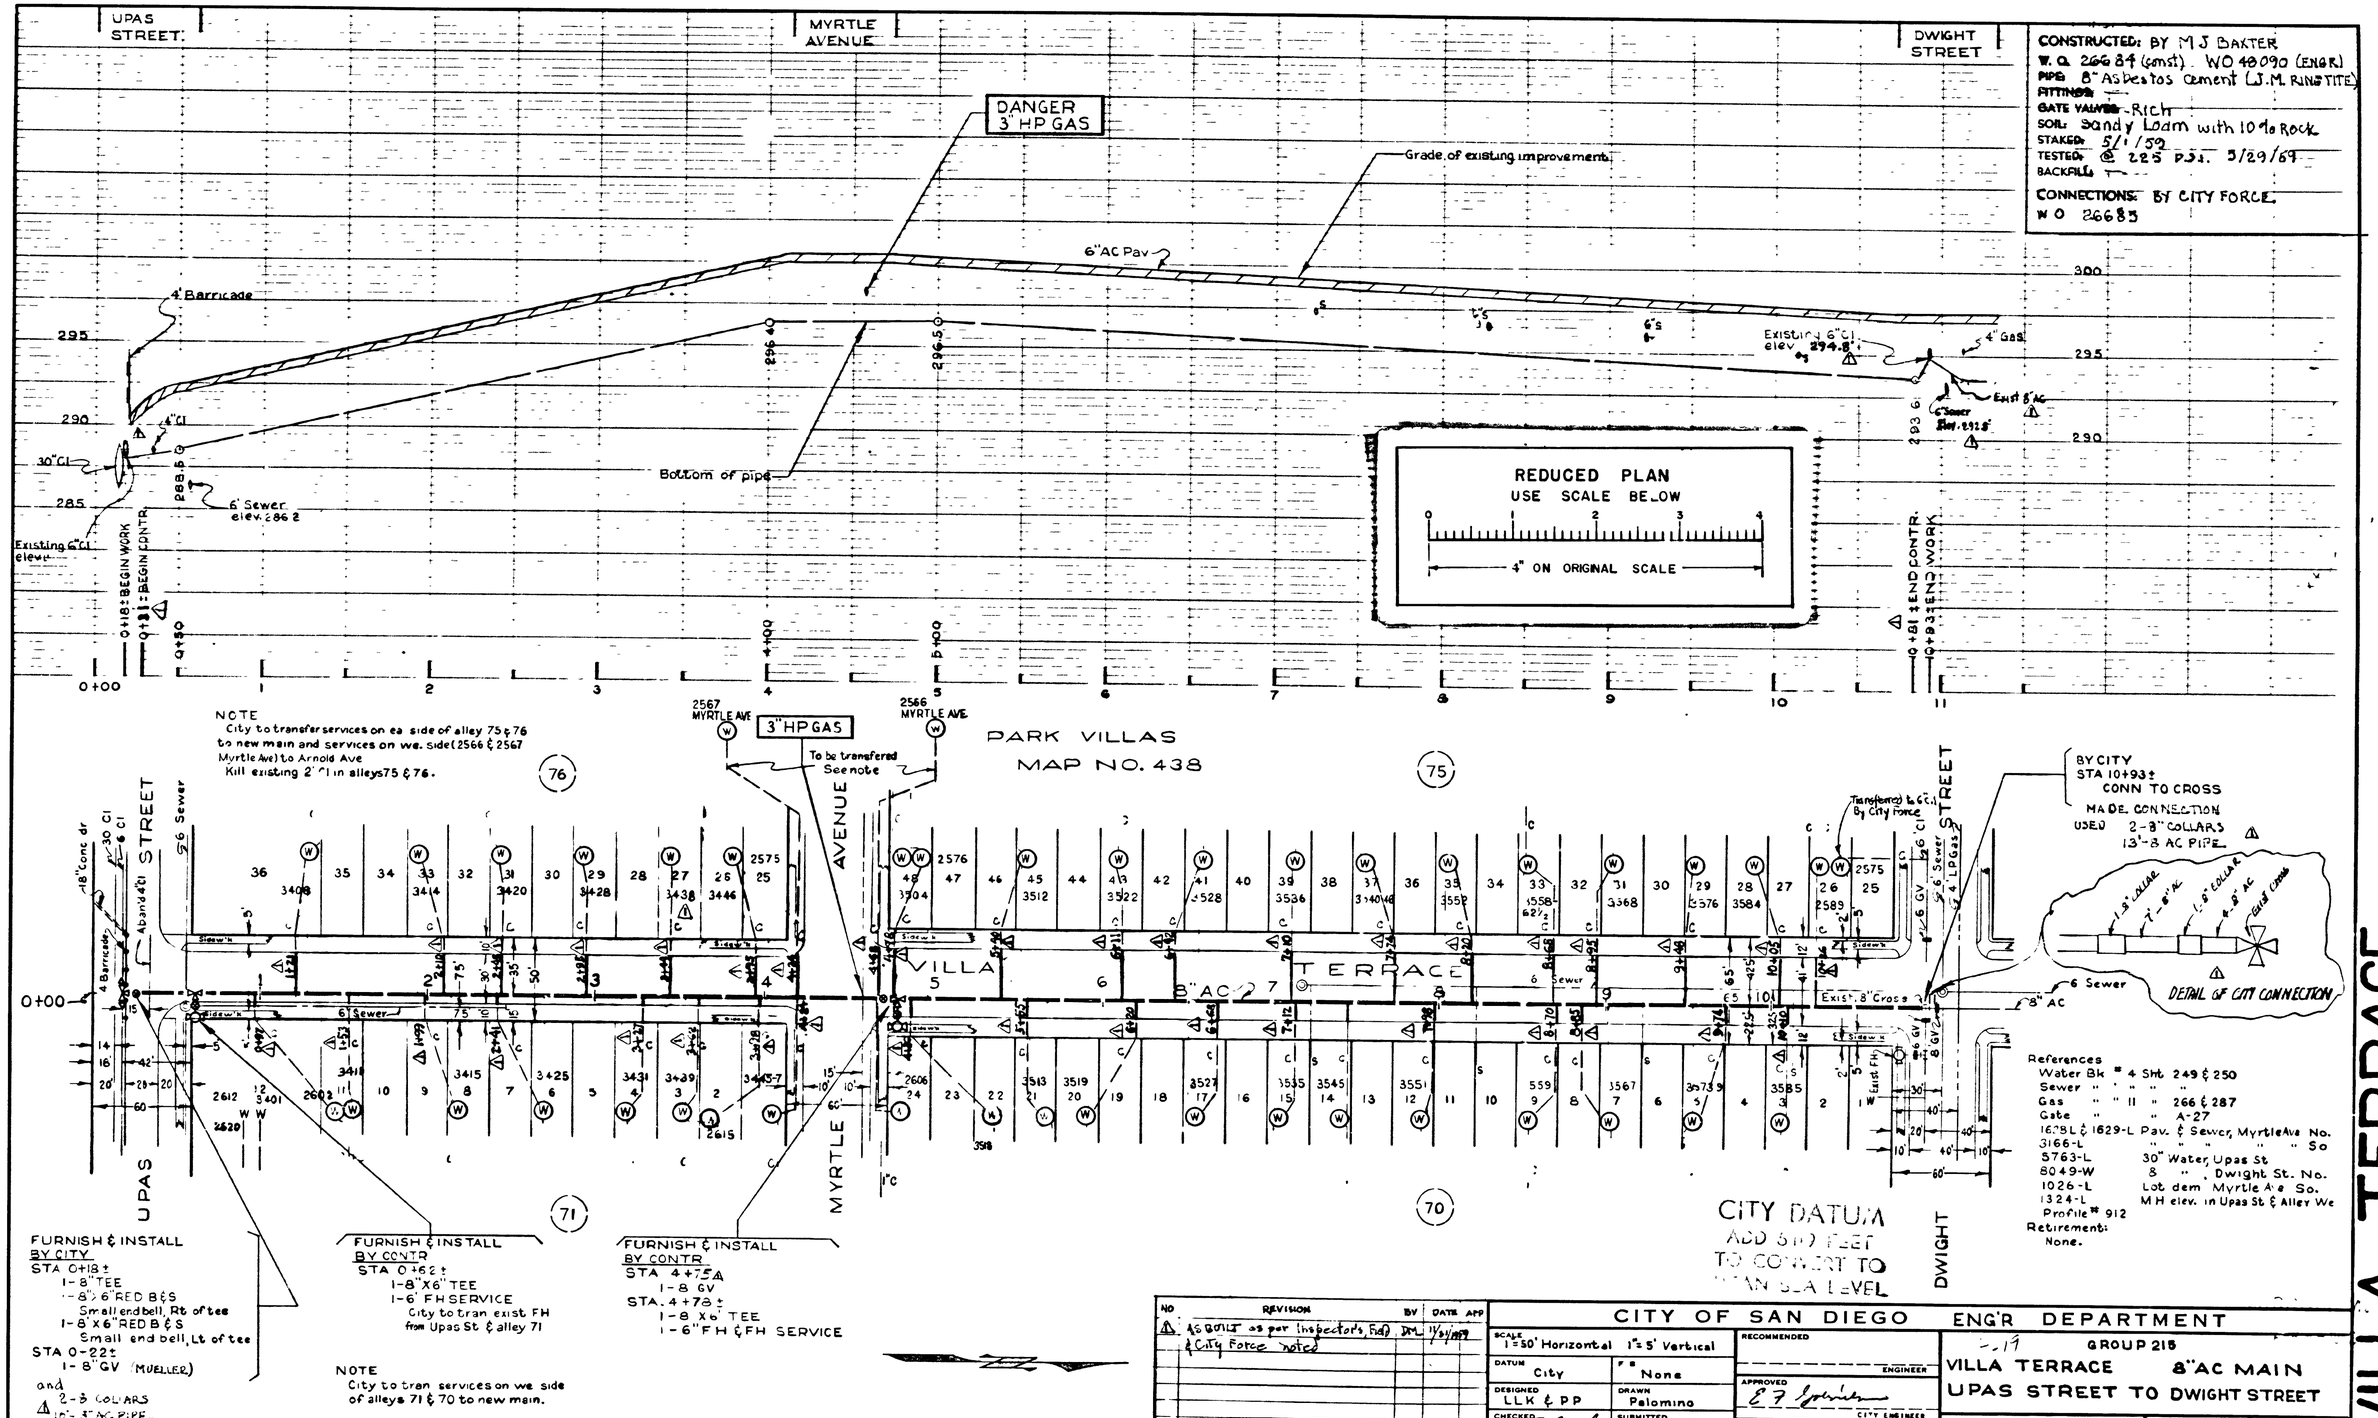

CONSTRUCTED: BY M J BAXTER
W. O. 26684 (const). WO 48090 (ENGR)
PIPE: 8" Asbestos Cement (J.M. RING TITE)
FITTINGS: —
GATE VALVES: Rich
SOIL: Sandy Loam with 10% Rock
STAKED: 5/1/59
TESTED: @ 225 P.S.I. 5/29/59
BACKFILL: —
CONNECTIONS: BY CITY FORCE
W O 26685

NO	REVISION	BY	DATE	APP
1	AS BUILT as per Inspector's Field & City Force noted	DM	11/21/1959	

CITY OF SAN DIEGO ENG'R DEPARTMENT

SCALE 1"=50' Horizontal 1"=5' Vertical
DATUM City
F.B. None
DESIGNED LLK & PP
DRAWN Palomino
CHECKED J.E. Crosby
SUBMITTED M.W. Mulkey
RECOMMENDED ENGINEER
APPROVED E.F. Goldman CITY ENGINEER
DATE 12/28/58

GROUP 215
VILLA TERRACE 8" AC MAIN
UPAS STREET TO DWIGHT STREET

SHEET 4 OF 7 SHEETS
SPEC NO 8317W
AS BUILT
DWG NO. 14407-L

VILLA TERRACE

INDEXED
DEC 26 1958