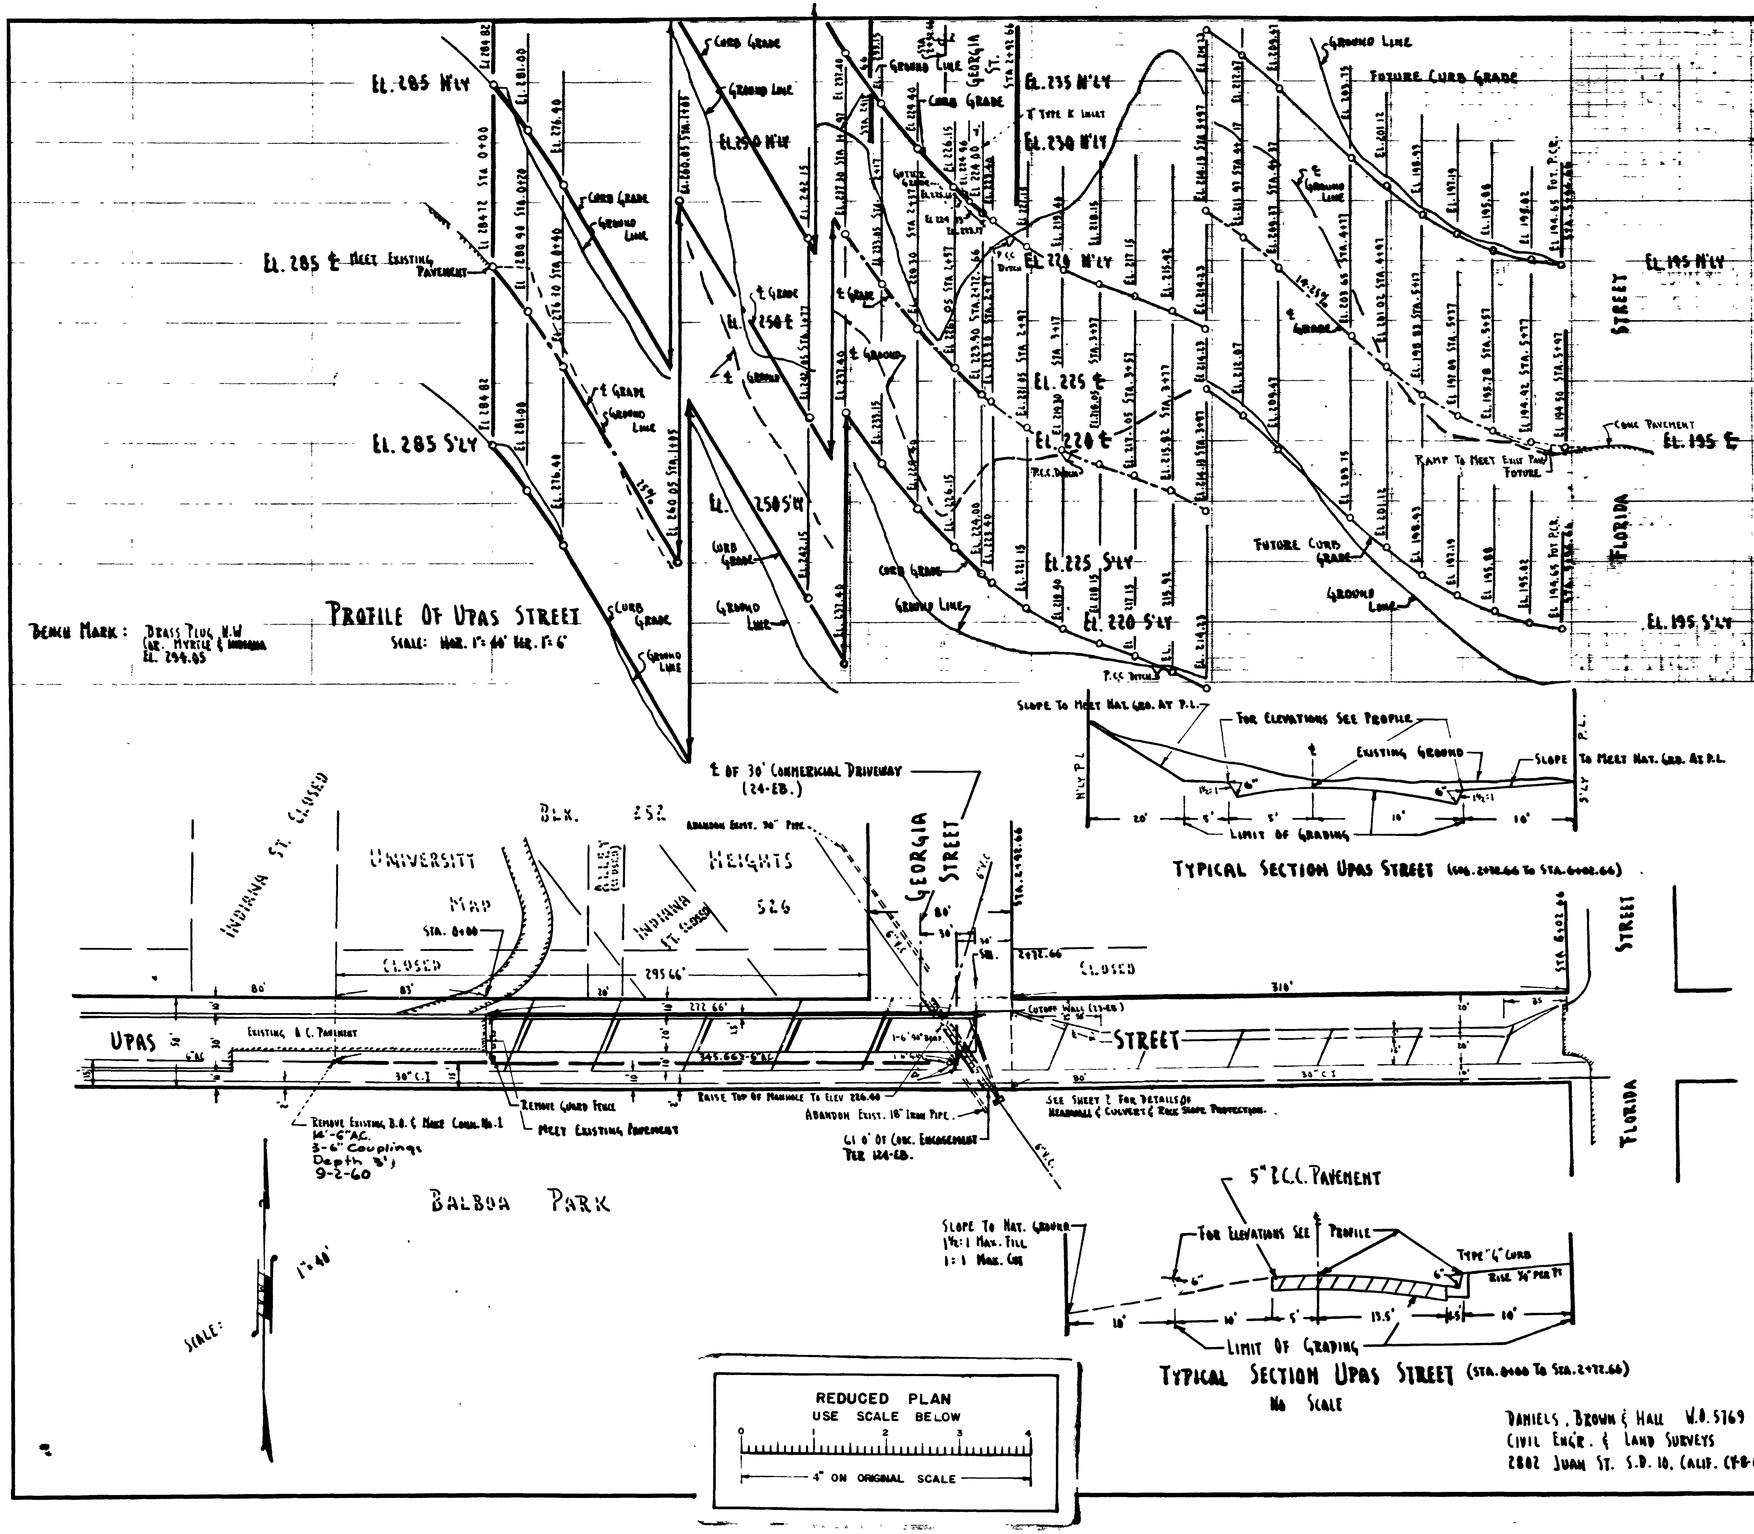

DANIELS, BROWN & HALL W.O. 5769
CIVIL ENG'R. & LAND SURVEYS
2802 JUAN ST. S.D. 10, CALIF. CY-8-6183

WORK TO BE DONE

THE IMPROVEMENT CONSISTS OF THE FOLLOWING WORK TO BE DONE ACCORDING TO THESE PLANS AND THE SPECIFICATIONS OF THE CITY OF SAN DIEGO.

THE GRADING OF THE PORTIONS OF THE STREETS SHOWN HATCHED THUS:

THE PREPARATION OF THE SUBGRADE AND THE PAVING OF THE PORTIONS OF THE STREET SHOWN THUS:

THE CONSTRUCTION OF TYPE "G" CURB AS SHOWN THUS:

THE CONSTRUCTION OF CUTOFF WALL PER 23-EB AS SHOWN.

THE CONSTRUCTION OF CONCRETE ENCASEMENT SHOWN THUS:

THE CONSTRUCTION OF 18" R.C.P. CULVERT AS SHOWN THUS:

THE CONSTRUCTION OF CUTOFF WALLS AS SHOWN ON THE PLAN.

THE CONSTRUCTION OF STORM DRAIN CLEANOUT SHOWN THUS:

THE CONSTRUCTION OF 6" GATE VALVES & BOXES SHOWN THUS:

THE CONSTRUCTION OF GRAVITY TYPE HEADWALL AS SHOWN.

THE CONSTRUCTION OF 6" A.C. WATER MAIN SHOWN THUS: 6" A.C.

THE CONSTRUCTION OF CONCRETE SEWER MANHOLES SHOWN THUS

THE CONSTRUCTION OF FIRE HYDRANT SERVICE SHOWN THUS:

THE CONSTRUCTION OF 8" V.C. SEWER MAIN SHOWN THUS: 8" V.C.

THE CONSTRUCTION OF TYPE "D" CLEANOUT SHOWN THUS:

THE CONSTRUCTION OF CONCRETE CRADLE SHOWN THUS:

STANDARD DRAWINGS

1-EB, 9-EB, 22-EB, 23-EB, 301-EB, 314-EB, 506-EB, 702-EB, & 24-EB, 21-EB, 124-EB, 214-EB, 311-EB, 325-EB, 100-EB, 101-EB, 103-EB & 106-EB, 212-WB, 258-WB, 261-WB, 286-WB, 553-EB.

NOTE: NO PAVEMENT SHALL BE PLACED BEFORE GAS MAINS & SERVICES ARE INSTALLED.

STANDARD SPECIFICATIONS

STANDARD SPECIFICATIONS, PART I FILED APRIL 9, 1958, INCLUDING AMENDMENT FILED APRIL 8, 1959, PART V FILED MAY 9, 1958. GENERAL CONDITIONS FOR PRIVATE CONTRACT WORK.

WATER DEPARTMENT NOTES

THE CONNECTIONS TO ALL EXISTING WATER MAINS WILL BE MADE BY THE CITY OF SAN DIEGO WATER DEPARTMENT. CHARGES WILL BE COLLECTED ONLY ON CONNECTIONS ACTUALLY MADE. WHERE NO CONNECTION IS MADE, THE CONTRACTOR SHALL INSTALL A BLOWOFF AT THE SITE AS SHOWN ON THE PLANS. ANY CONNECTION NOT SHOWN WILL BE MADE AT FORCES IN EFFECT AS OF THIS DATE.

THE COSTS OF CONNECTIONS SHOWN ON THESE PLANS ARE AS FOLLOWS

CONNECTION NO. 1 $157.00 CONNECTION NO 2 $157

CITY FORCES WILL EXCAVATE, BACKFILL, & FURNISH AND INSTALL ALL MATERIAL EXCEPT PAVING, FOR APPROXIMATELY TEN (10) FEET ADJACENT TO THE POINT OF CONNECTION TO EACH EXISTING MAIN.

THE CONTRACTOR SHALL EXCAVATE AT THE LOCATION OF EACH REQUIRED CONNECTION TO AN EXISTING MAIN TO DETERMINE THE ELEVATION AND LOCATION OF THE MAIN AT THE CONNECTION. IMMEDIATELY AFTER SUCH DETERMINATION HAS BEEN MADE, THE ABOVE EXPLORATORY EXCAVATION SHALL BE BACKFILLED IN ACCORDANCE WITH CITY STANDARD SPECIFICATIONS. (WHERE REQUIRED BY ENGINEER)

ALL PIPE LINE WORK BY CONTRACTOR SHALL TERMINATE APPROXIMATELY TEN (10) FEET FROM POINTS OF CONNECTIONS TO THE EXISTING WATER MAINS AND NO EXCAVATION SHALL BE MADE WITHIN THE AFORESAID TEN (10) FEET EXCEPT THE ABOVE EXPLORATORY EXCAVATION.

CONSTRUCTION APPROVAL

Date Fee Paid 6-2-60 Permit No. IN 279

Approved for Construction By J.H.

PRIVATE CONTRACT

ENGINEER OF WORK Raymond F. Hall RE. 8629

PLAN FOR THE IMPROVEMENT OF UPAS STREET GEORGIA STREET - W'LY.

IN 279

CITY OF SAN DIEGO
ENGINEERING DEPARTMENT

SHEET 1 OF 2 SHEETS

PLAN REVISION			
CHANGE	BY	DATE	APPROVAL
As Built	D.J.	9/26/61	

CONSTRUCTION RECORD
DATE STARTED 6/21/60 DATE COMPLETED 11/2/61
CONTR. Hedrick INSP. Boyd
FIELD BOOK H-19

CITY ENGINEER E. F. Jobson 4/5/60 DATE

APPROVALS FOR
WATER DEPT. Donald Lenard 3-14-60 SEWERAGE Walter 3/11/60
PLANNING DEPT. DRAINAGE Wm Symonds 3/29
ELECTRICAL HIGHWAY
STRUCTURAL GRADES H. Mills 3/24/60
TRAFFIC CONTROL F. J. Enderle

W.O. NO 20045
APPROVED 4-5-60
ASS'T CITY ENGINEER AND OFFICE ENGINEER
SUPERVISOR
CHECKED
DESIGNED V.W.
9026-D

INDEXED
MICROFILMED
APR 19 1963
APR - - 1963