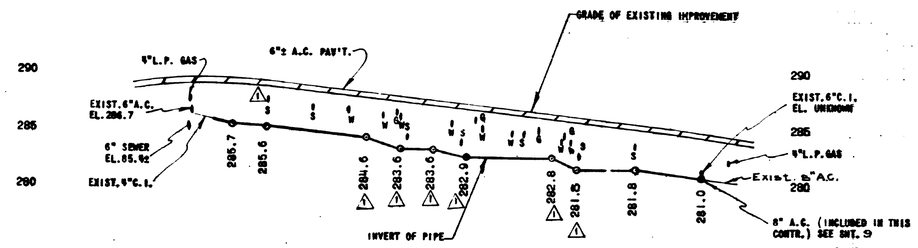

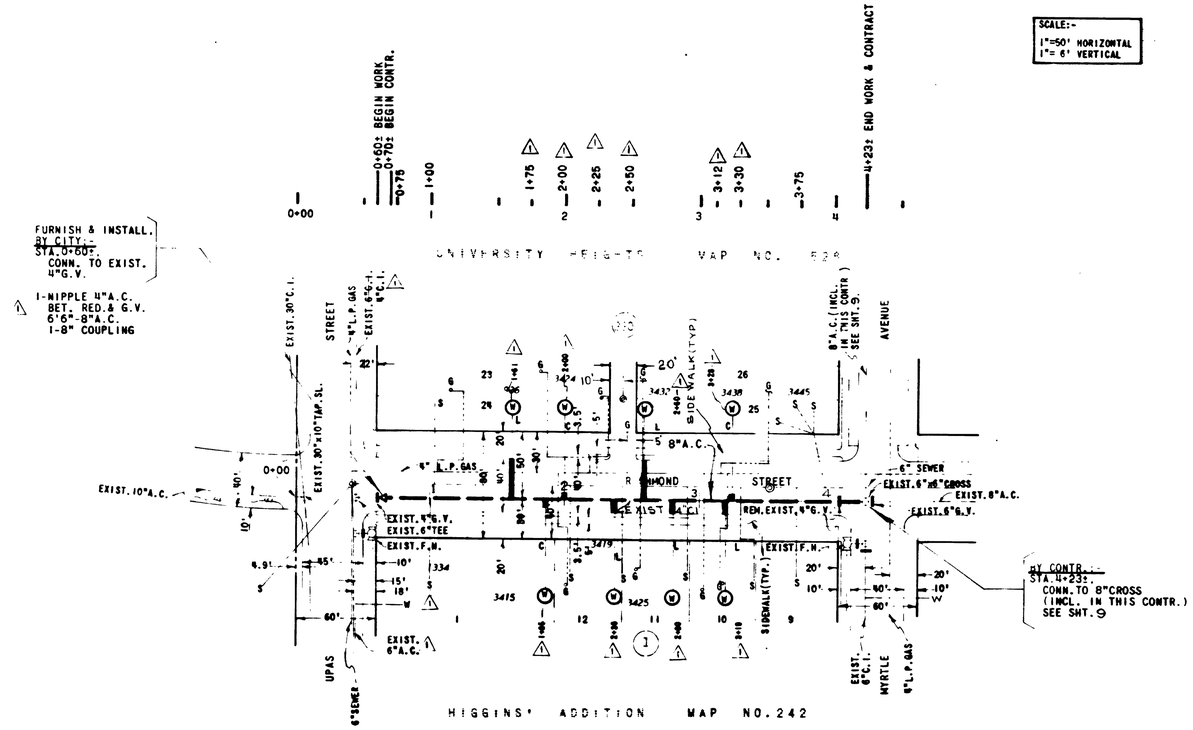

SCALE:-
1"=50' HORIZONTAL
1"= 6' VERTICAL

BENCH MARK:- (MEAN SEA LEVEL DATUM)
B.M. - H.W.B.P. - RICHMOND ST. & UPAS ST., EL.290.030

AS BUILT DATA

CONSTRUCTED BY:- LONG, MARKER & NOWLEY CONST.CO.
W.O. 16044 (CONSTR.). W.O. 48397 (ENGR.),
PIPE: JOHNS-MANVILLE "RING-TITE".
(Kind)
GATE VALVES: NONE
(Kind)
SOIL: REP. CONGLOMERATE
(Kind)
STAKED: 12/14/66
(Date)
TESTED: 2/6/67
(Date)
BACKFILL: - IMPORT
(Kind)
Note: Include "CONSTRUCTION RECORD".
CONNECTIONS BY:- CITY FORCE,
W.O. 16045
PIPE: 4" A.C. & 8"A.C.
GATE VALVES: NONE

REFERENCES:-
GATE BK. G-19
GAS 2. SHTS. 198 & 203
2415-L WATER. RICHMOND ST.
5767-L " . 30"C I. UPAS ST. P.L
10561-6-D WATER. RICHMOND ST. 0+00 TO S.
6917-W WATER 6"A.C. UPAS ST.
6803-W " RICHMOND ST. 4+23± TO N.
FIELD NOTES 210-1722. 48397 RICHMOND ST.

RETIREMENT:-
363' - 4"C.I - 1927
1-8"G.V. - 1927

GROUP 150
RICHMOND STREET 8"A C. MAIN
Upas Street To Myrtle Avenue

CITY OF SAN DIEGO, CALIFORNIA
ENGINEERING DEPARTMENT
SHEET 4 OF 13 SHEETS

W.O. NO. 48397

DESCRIPTION	BY	APPROVED	DATE	FILM NO.
ORIGINAL	P.P.	LLE/GFA	8/11/	
AS BUILT Per Inspect's. Field & C.F. Notes	P.P.	LLE/REC	5-3-67	

LONG, MARKER & NOWLEY

CONTROL CERTIFICATION: 210-1722

CONTRACTOR CONST. CO. DATE STARTED 1-26-67
INSPECTOR MARTELL DATE COMPLETED 2-17-67

12471-4-D

RICHMOND STREET UPAS STREET TO MYRTLE AVENUE

AS BUILT