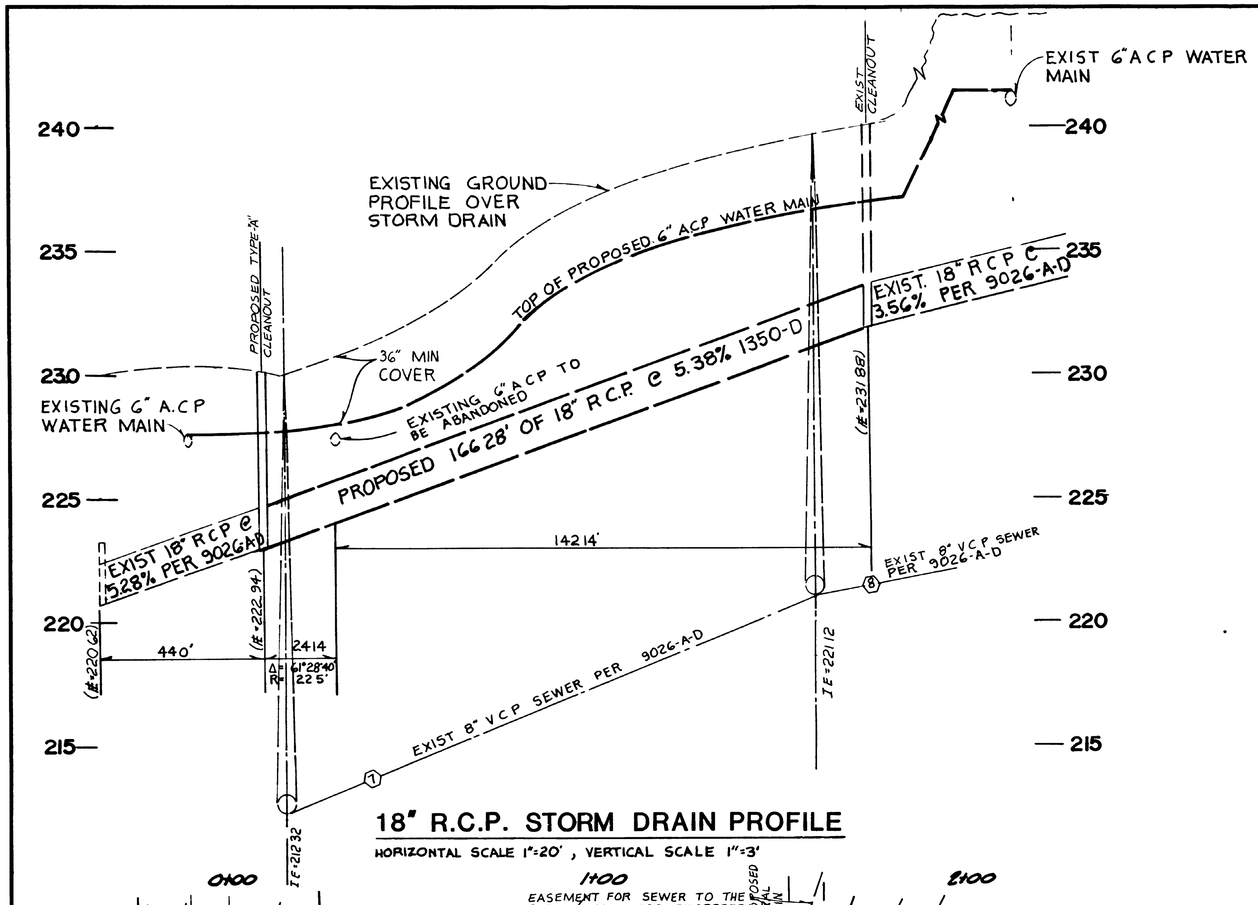

18" R.C.P. STORM DRAIN PROFILE

HORIZONTAL SCALE 1"=20', VERTICAL SCALE 1"=3'

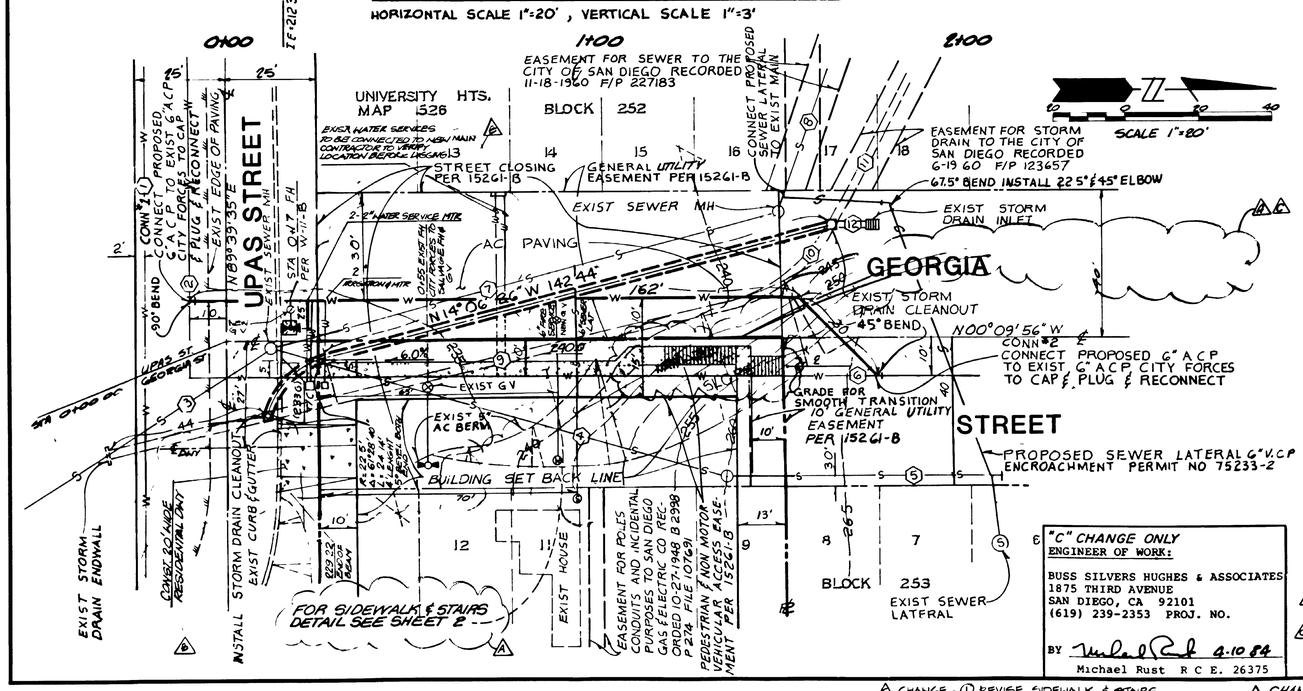

"C" CHANGE ONLY
ENGINEER OF WORK:
BUSS SILVERS HUGHES & ASSOCIATES
1875 THIRD AVENUE
SAN DIEGO, CA 92101
(619) 239-2353 PROJ. NO.
BY Michael Rust 4-10-84
Michael Rust R C E. 26375

△ CHANGE - ① REVISE SIDEWALK & STAIRS
② DELETE RETAINING WALL @ PROPERTY LINE
③ DELETE RETAINING WALL NOTE
④ ADD SHEET 4

△ CHANGE ① ADD DRIVEWAY
② ADD FIRE SERVICE, WATER SERVICE & IRRIGATION
③ CONNECT EXIST WATER SERVICE TO NEW WATER MAIN
④ ADD SEWER LATERAL

△ CHANGE: ① ADD LEGEND, RELOCATE WORK BY CITY FOR REQ. & R.O.T.
② ADD SHEET 4
③ ADD RETAINING WALL NOTE

WORK TO BE DONE

THE IMPROVEMENTS CONSIST OF THE FOLLOWING WORK TO BE DONE ACCORDING TO THESE PLANS AND THE SPECIFICATIONS AND STANDARD DRAWINGS OF THE CITY OF SAN DIEGO.

STANDARD SPECIFICATIONS

1 STANDARD SPECIFICATIONS FOR PUBLIC WORKS CONSTRUCTION (1979 ED) DOCUMENT NO 766725, FILED NOVEMBER 9, 1979

2 STANDARD SPECIAL PROVISIONS, DOCUMENT NO 767381, FILED NOVEMBER 9, 1979

3. CITY OF SAN DIEGO STANDARD SPECIAL PROVISIONS, DOCUMENT NO 767246, FILED SEPTEMBER 20, 1979

STANDARD DRAWINGS

1 REGIONAL STANDARD DRAWINGS, DOCUMENT NO 767429, FILED DECEMBER 3, 1979

2 CITY OF SAN DIEGO STANDARD DRAWINGS, DOCUMENT NO 767694, FILED MAY 9, 1980

LEGEND	STD DWG	SYMBOL
STREET PAVEMENT SCHEDULE "H"	SDG-101	
A.C. OVERLAY (1-1/2" AVRG)		
6" A.C. BERM (TYPE "A")		
GUARD RAIL		
STORM DRAIN		
CATCH BASIN (TYPE "E")		
CLEAN-OUT (TYPE "A")		
CURB OUTLET (MODIFIED)	D-25	
CUT-OFF WALL		
6" ACP WATER MAIN		W W
FIRE HYDRANT	S-11-B	
SEWER LATERAL		S S
RETAINING WALL	DETAIL	
SIDEWALK WITH HAND RAILS		
PCC DRIVEWAY	6-4	
WATER SERVICE & METER	W-2, W-15	

EXISTING UTILITY LINES

NO	TYPE	REF MAP NO	BEARING/DELTA	RADIUS	LENGTH	REMARKS	DATE COMPLETED
1	30" CCT WATER	9026-D, 9026-A-D					
2	6" A C P WATER	9026-D, 9026-A-D			(±20')	PORTION TO BE ABANDONED	11/2/61
3	6" V C P SEWER	9026-D, 9026-A-D					1961
4	6" V C P SEWER	9026-D, 9026-A-D			(±128')	TO BE ABANDONED	1961
5	6" V C P SEWER	WO 69813			(±75')	TO BE ABANDONED	1961
6	6" A C P WATER	9026-A-D			(±87')	PORTION TO BE ABANDONED	11/2/61
7	8" V C P SEWER	9026-A-D	N15°19'14"W	~	(±446')		1961
8	8" V C P SEWER	9026-A-D	N71°39'01"W	~	~		1961
9	18" R C P S DRAIN	9026-D, 9026-A-D	N12°34'49"W	~	(174')	PORTION TO BE ABANDONED	11/2/61
10	18" R C P S DRAIN	9026-A-D	(Δ=50°)	(45')	(39.27')	TO BE ABANDONED.	11/2/61
11	18" R C P S DRAIN	9026-A-D	N62°34'49"W	~	~		
12	18" R C P S DRAIN	9026-A-D	N00°10'48"W	(10')	~		

WORK BY CITY FORCES

CONNECTION #1 $2,255 6" WATER MAIN CUT & PLUG & RECONNECT
#2 $2,255 6" WATER MAIN CUT & PLUG & RECONNECT

A.D.T

UPAS STREET 3,000
GEORGIA STREET LOCAL
WILSHIRE TERRACE COL-DL-SAC

△ NOTE SEE SHEET 2 & 3 FOR REVISED SIDEWALK & STAIRS DELETE RETAINING WALL & PROPERTY LINE

BIGGS ENGINEERING CORPORATION
CIVIL ENGINEERS • PLANNING CONSULTANTS • SURVEYORS
121 EAST 1ST STREET, NATIONAL CITY, CALIFORNIA 92050 phone 714-474-4659

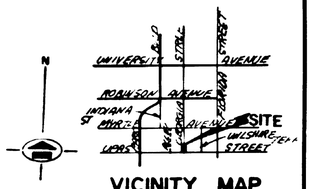

VICINITY MAP
NO SCALE

ENGINEERING PERMIT NO W25902

BENCH MARK	ENGINEER OF WORK.
CITY OF SAN DIEGO BENCH MARK IND NO 210.21725.4 NW COR FLORIDA STREET & UPAS STREET BRASS PLUG ELEV 200.974 MSL	DAN S BIGGS RCE 26112 — DATE 6/20/5

DATE 12-3-5 | PRIVATE CONTRACT | JOB NO. 81.139

IMPROVEMENT PLAN FOR:

GEORGIA STREET UTILITIES RELOCATION

CITY OF SAN DIEGO, CALIFORNIA
ENGINEERING DEPARTMENT
SHEET 1 OF 4 SHEETS

T.B. - 02-007
W.O. NO. 75233

C.R. Fowler 12-22-81
FOR CITY ENGINEER DATE

DESCRIPTION	BY	APPROVED	DATE	FILMED
ORIGINAL				
"A" CHANGE	BIGGS		2-7-86	
"B" CHANGE	BIGGS			
"C" CHANGE	B.B.H.A			
AS BUILT			10-21-86	

CONTRACTOR ROEL CONST. DATE STARTED 7-8-85
INSPECTOR DATE COMPLETED 9-2-85

REGIONAL COORDINATES 210-1725
LA MESA COORDINATES 20032-1-D

81155

5 1 2 3 4 IN.