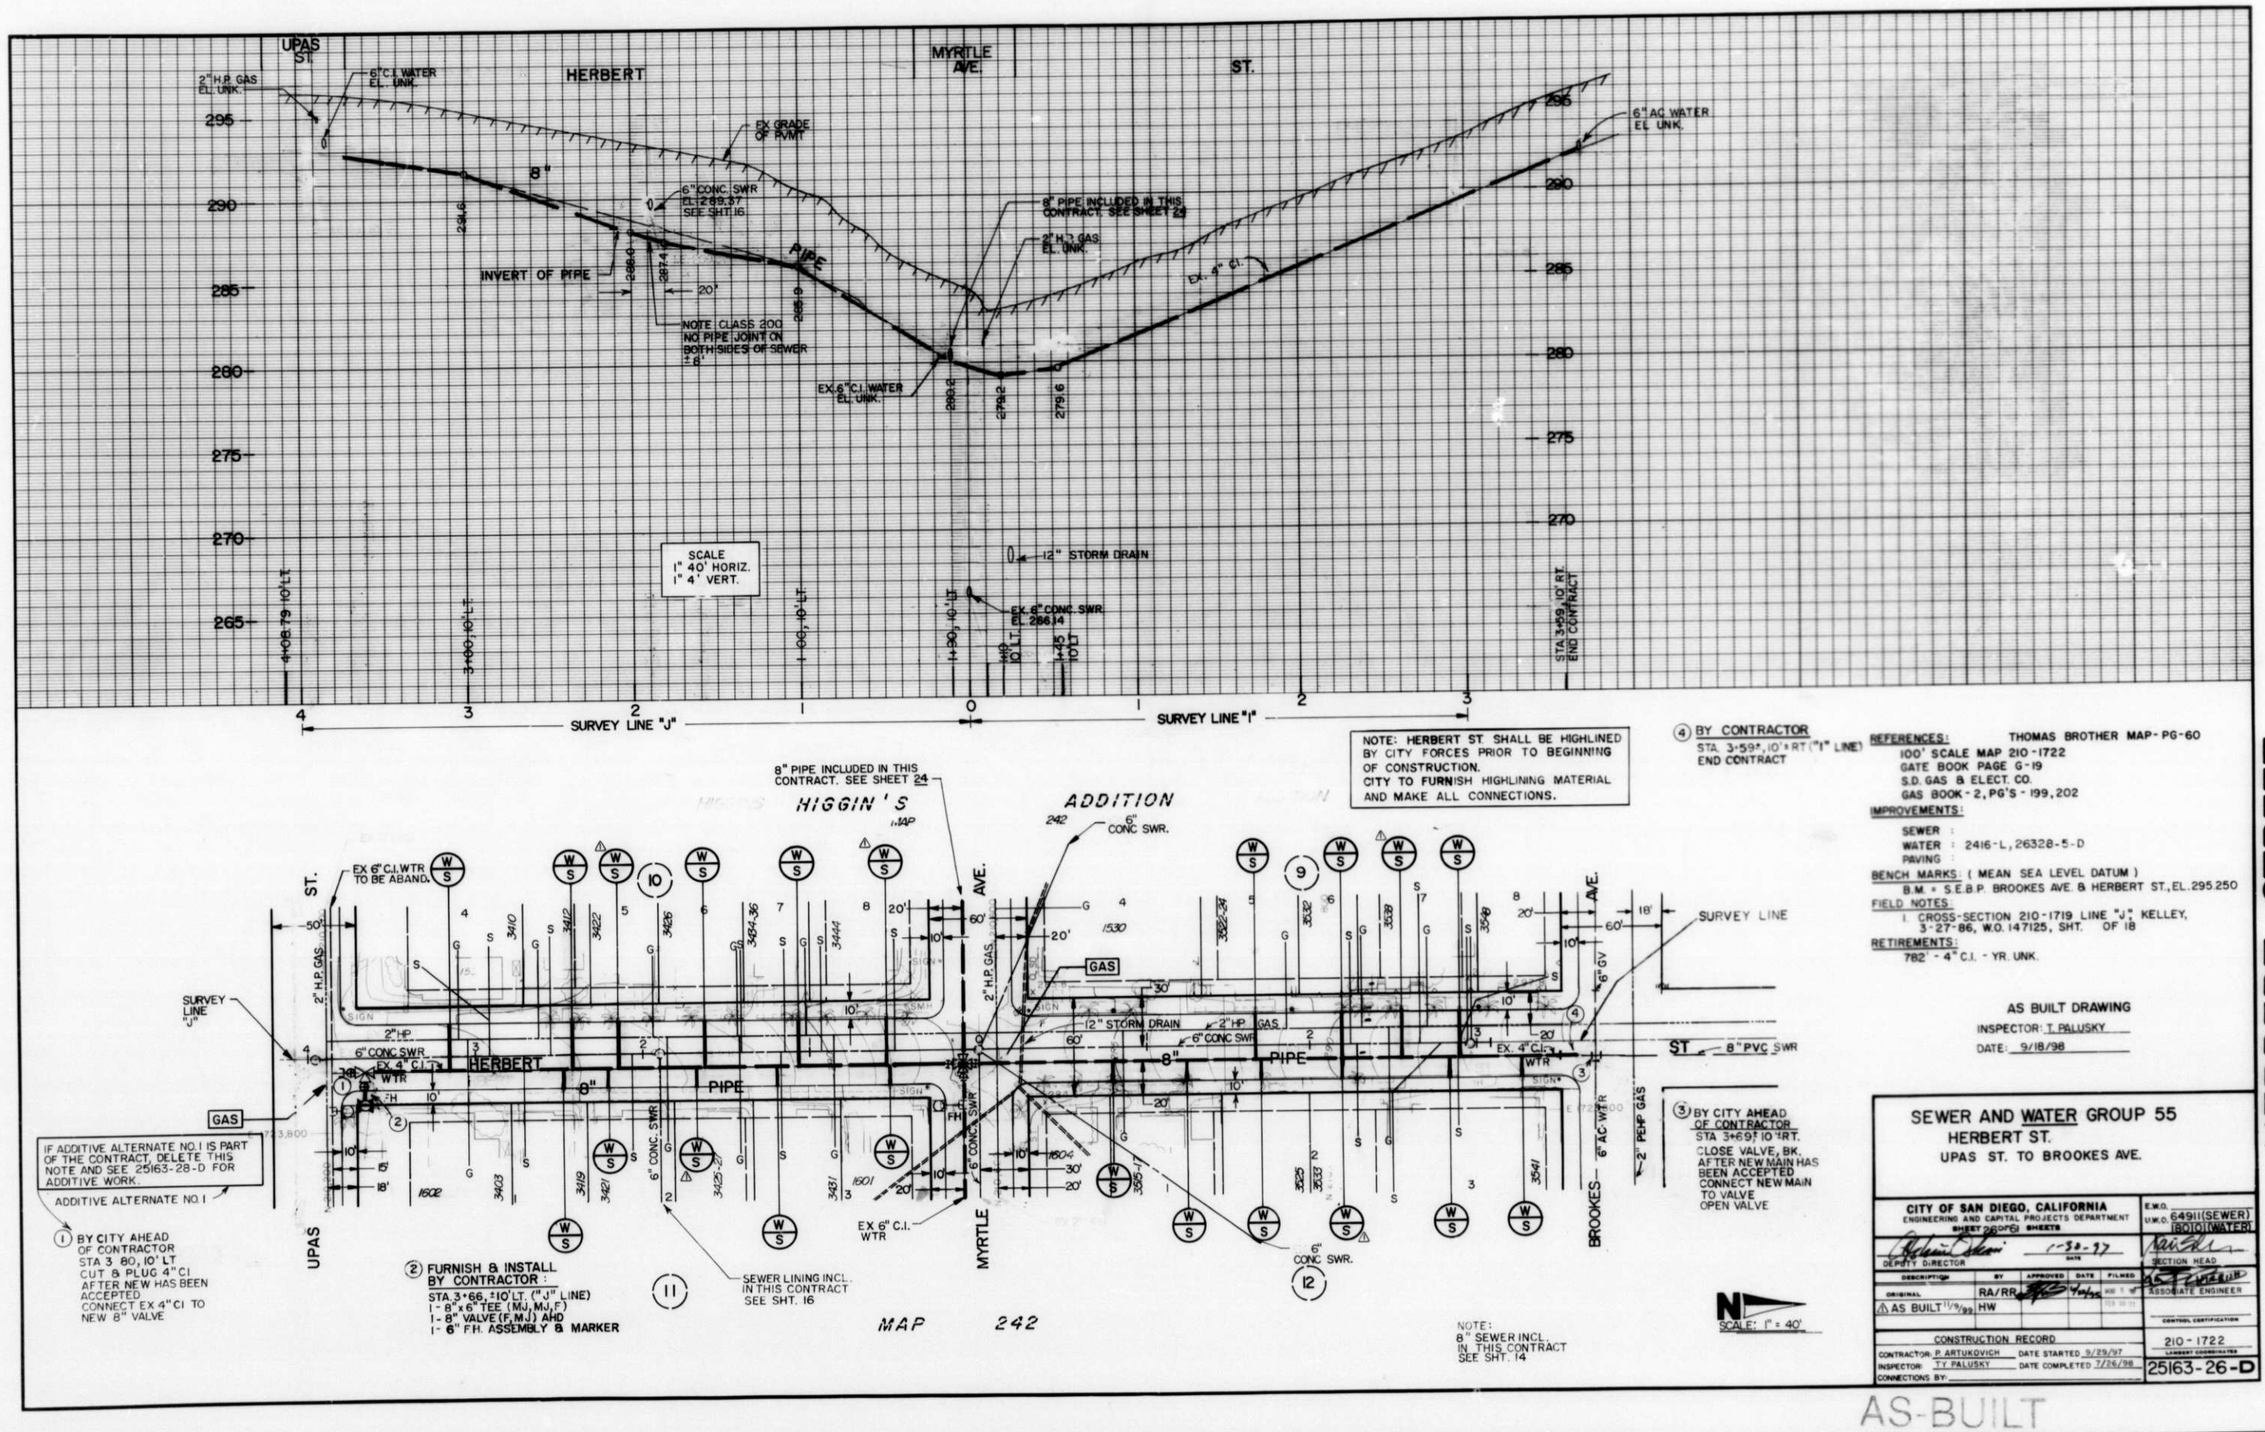

④ BY CONTRACTOR
STA. 3+59±, 10'± RT ("I" LINE) END CONTRACT

REFERENCES: THOMAS BROTHER MAP - PG-60
100' SCALE MAP 210-1722
GATE BOOK PAGE G-19
S.D. GAS & ELECT. CO.
GAS BOOK - 2, PG'S - 199, 202

IMPROVEMENTS:
SEWER :
WATER : 2416-L, 26328-5-D
PAVING :

BENCH MARKS: (MEAN SEA LEVEL DATUM)
B.M. = S.E.B.P. BROOKES AVE. & HERBERT ST., EL. 295.250

FIELD NOTES:
1. CROSS-SECTION 210-1719 LINE "J", KELLEY, 3-27-86, W.O. 147125, SHT. OF 18

RETIREMENTS:
782' - 4" C.I. - YR. UNK.

AS BUILT DRAWING
INSPECTOR: T. PALUSKY
DATE: 9/18/98

SEWER AND WATER GROUP 55
HERBERT ST.
UPAS ST. TO BROOKES AVE.

CITY OF SAN DIEGO, CALIFORNIA
ENGINEERING AND CAPITAL PROJECTS DEPARTMENT
SHEET 26 OF 61 SHEETS

DEPUTY DIRECTOR — DATE 1-30-97
SECTION HEAD
ASSOCIATE ENGINEER

DESCRIPTION	BY	APPROVED	DATE	FILMED
ORIGINAL	RA/RR		4/10/95	
⚠ AS BUILT 11/9/99	HW			

CONSTRUCTION RECORD
CONTRACTOR: P. ARTUKOVICH DATE STARTED 9/29/97
INSPECTOR: TY PALUSKY DATE COMPLETED 7/26/98
CONNECTIONS BY:

E.W.O. 64911 (SEWER)
U.W.O. 80101 (WATER)
CONTROL CERTIFICATION
210-1722
LAMBERT COORDINATES
25163-26-D

HERBERT STREET

AS-BUILT

FILMED FROM THE ORIGINAL. BEST QUALITY OBTAINABLE. EXCESSIVE GRAY BACKGROUND MAY CAUSE A POOR QUALITY REPRODUCTION.