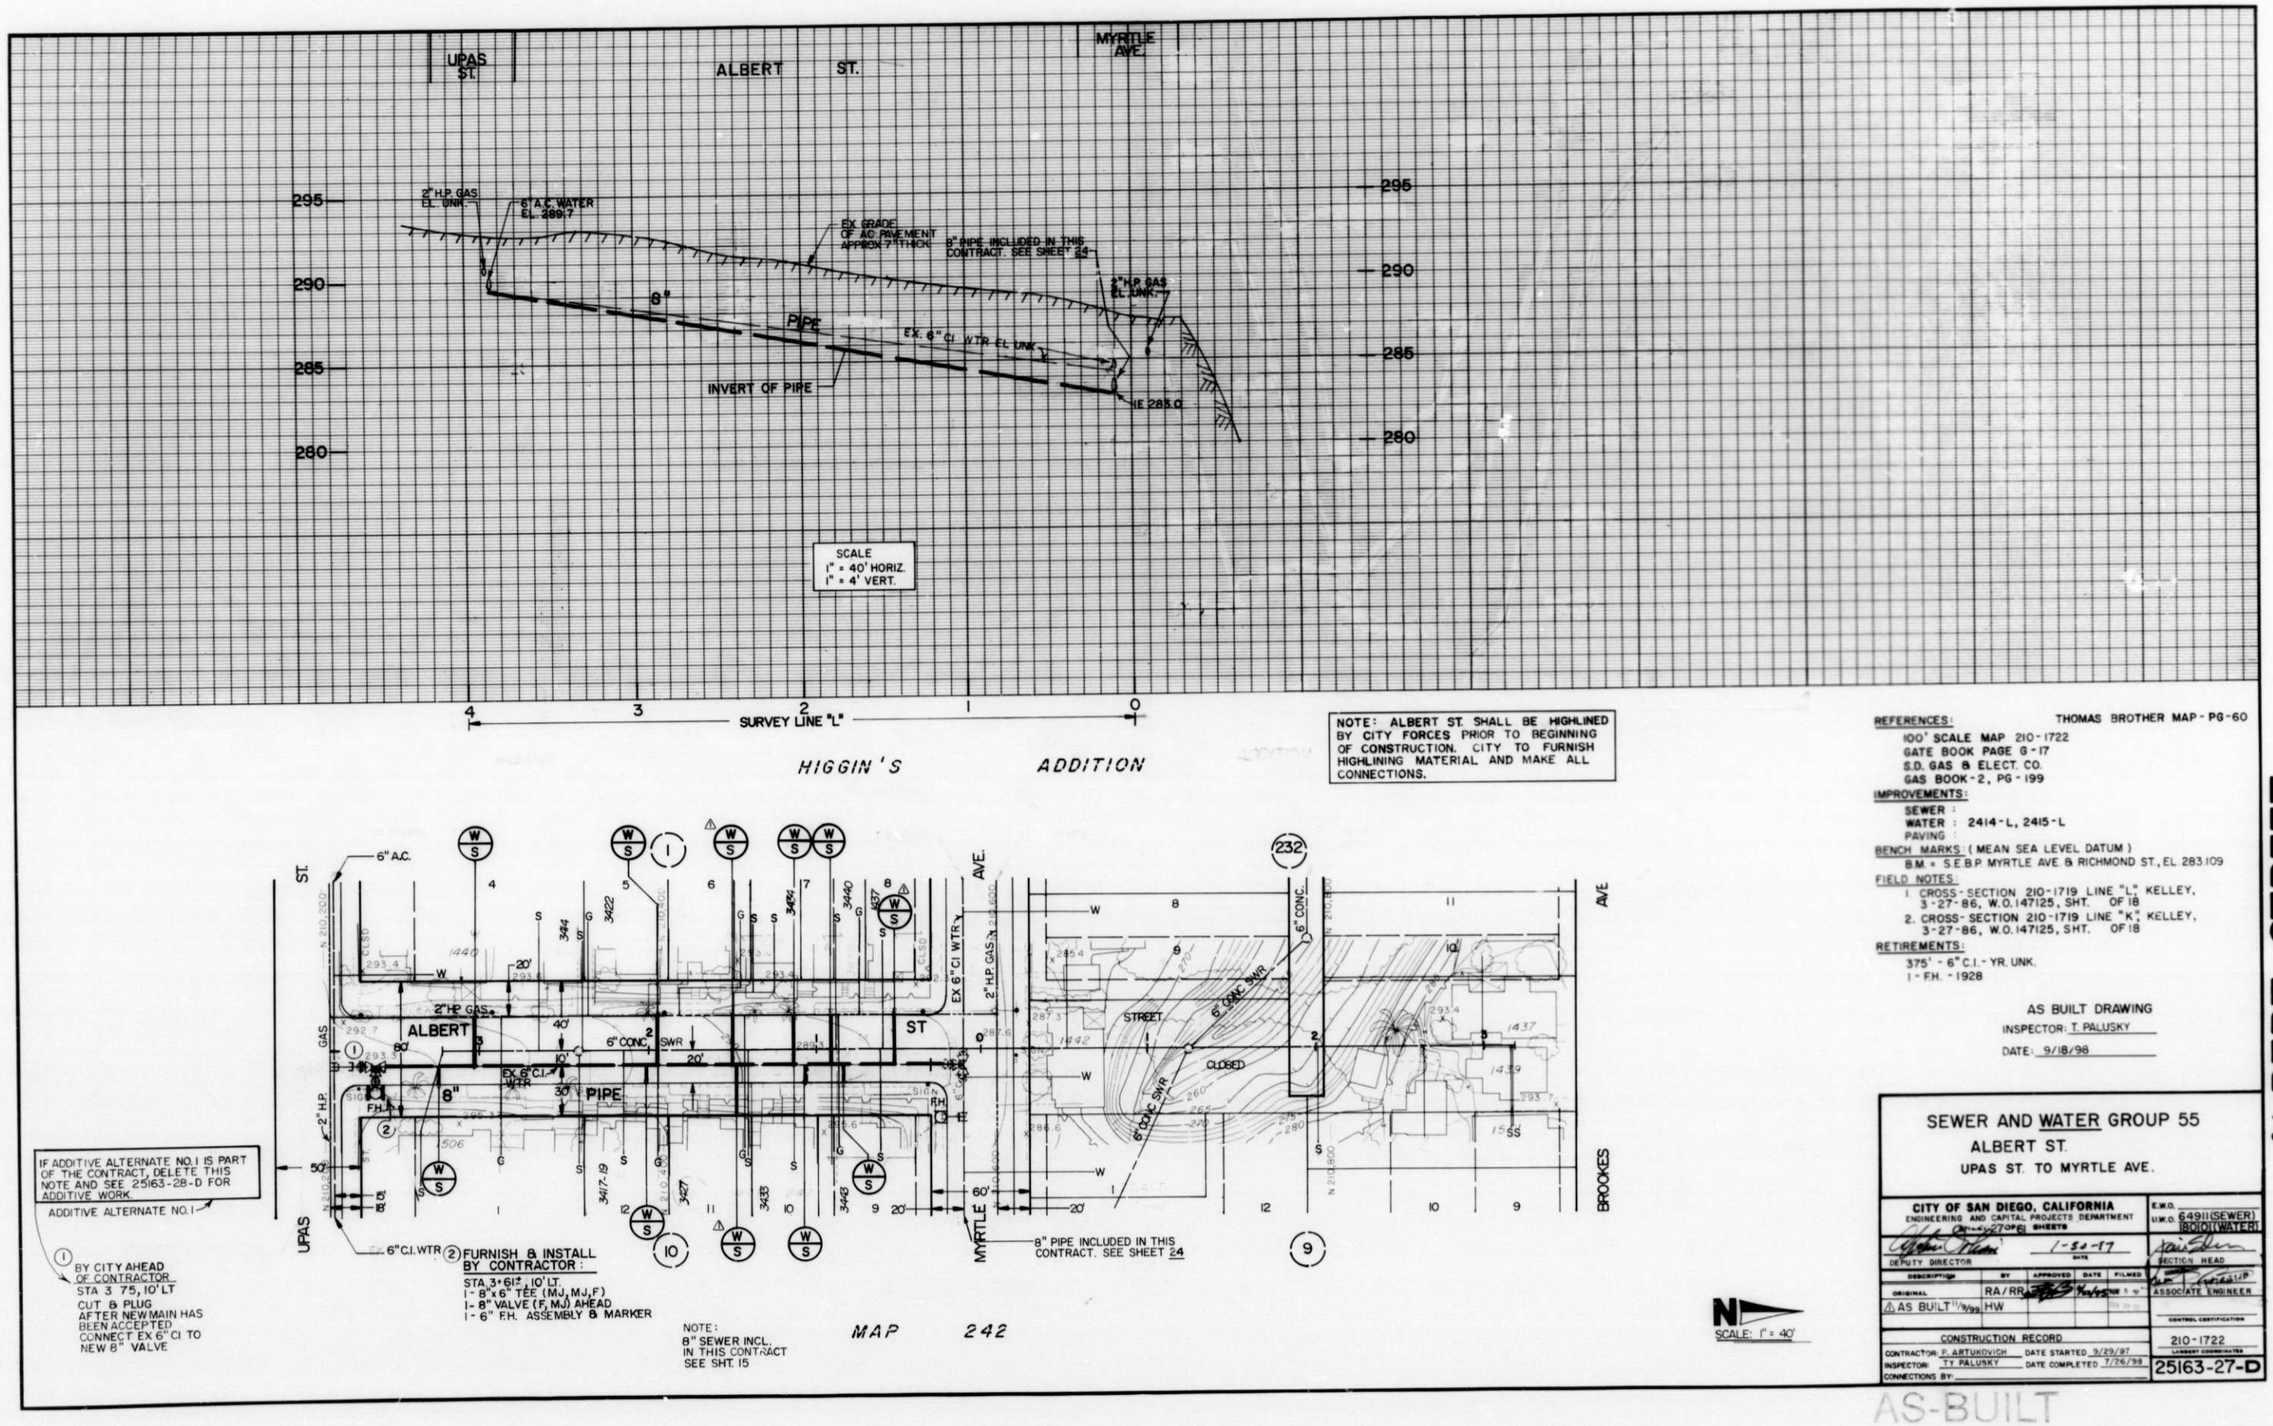

REFERENCES: THOMAS BROTHER MAP - PG-60
100' SCALE MAP 210-1722
GATE BOOK PAGE G-17
S.D. GAS & ELECT. CO.
GAS BOOK-2, PG-199

IMPROVEMENTS:
SEWER :
WATER : 2414-L, 2415-L
PAVING :

BENCH MARKS: (MEAN SEA LEVEL DATUM)
B.M. = S.E.B.P. MYRTLE AVE. & RICHMOND ST., EL. 283.109

FIELD NOTES:
1. CROSS-SECTION 210-1719 LINE "L", KELLEY, 3-27-86, W.O. 147125, SHT. OF 18
2. CROSS-SECTION 210-1719 LINE "K", KELLEY, 3-27-86, W.O. 147125, SHT. OF 18

RETIREMENTS:
375' - 6" C.I. - YR. UNK.
1 - F.H. - 1928

AS BUILT DRAWING
INSPECTOR: T. PALUSKY
DATE: 9/18/98

SEWER AND WATER GROUP 55
ALBERT ST.
UPAS ST. TO MYRTLE AVE.

CITY OF SAN DIEGO, CALIFORNIA
ENGINEERING AND CAPITAL PROJECTS DEPARTMENT
SHEETS 27 OF 61
DEPUTY DIRECTOR — DATE 1-30-97
E.W.O. 64911(SEWER) 80101(WATER)
SECTION HEAD
ASSOCIATE ENGINEER
CONTROL CERTIFICATION
210-1722
LAMBERT COORDINATES
25163-27-D

DESCRIPTION	BY	APPROVED	DATE	FILMED
ORIGINAL	RA/RR			
AS BUILT 11/9/99	HW			

CONSTRUCTION RECORD
CONTRACTOR: P. ARTUKOVICH DATE STARTED 9/29/97
INSPECTOR: TY PALUSKY DATE COMPLETED 7/26/98
CONNECTIONS BY:

ALBERT STREET

AS-BUILT

FILMED FROM THE ORIGINAL. BEST QUALITY OBTAINABLE. EXCESSIVE GRAY BACKGROUND MAY CAUSE A POOR QUALITY REPRODUCTION.

0 1 2 3 4 IN.